


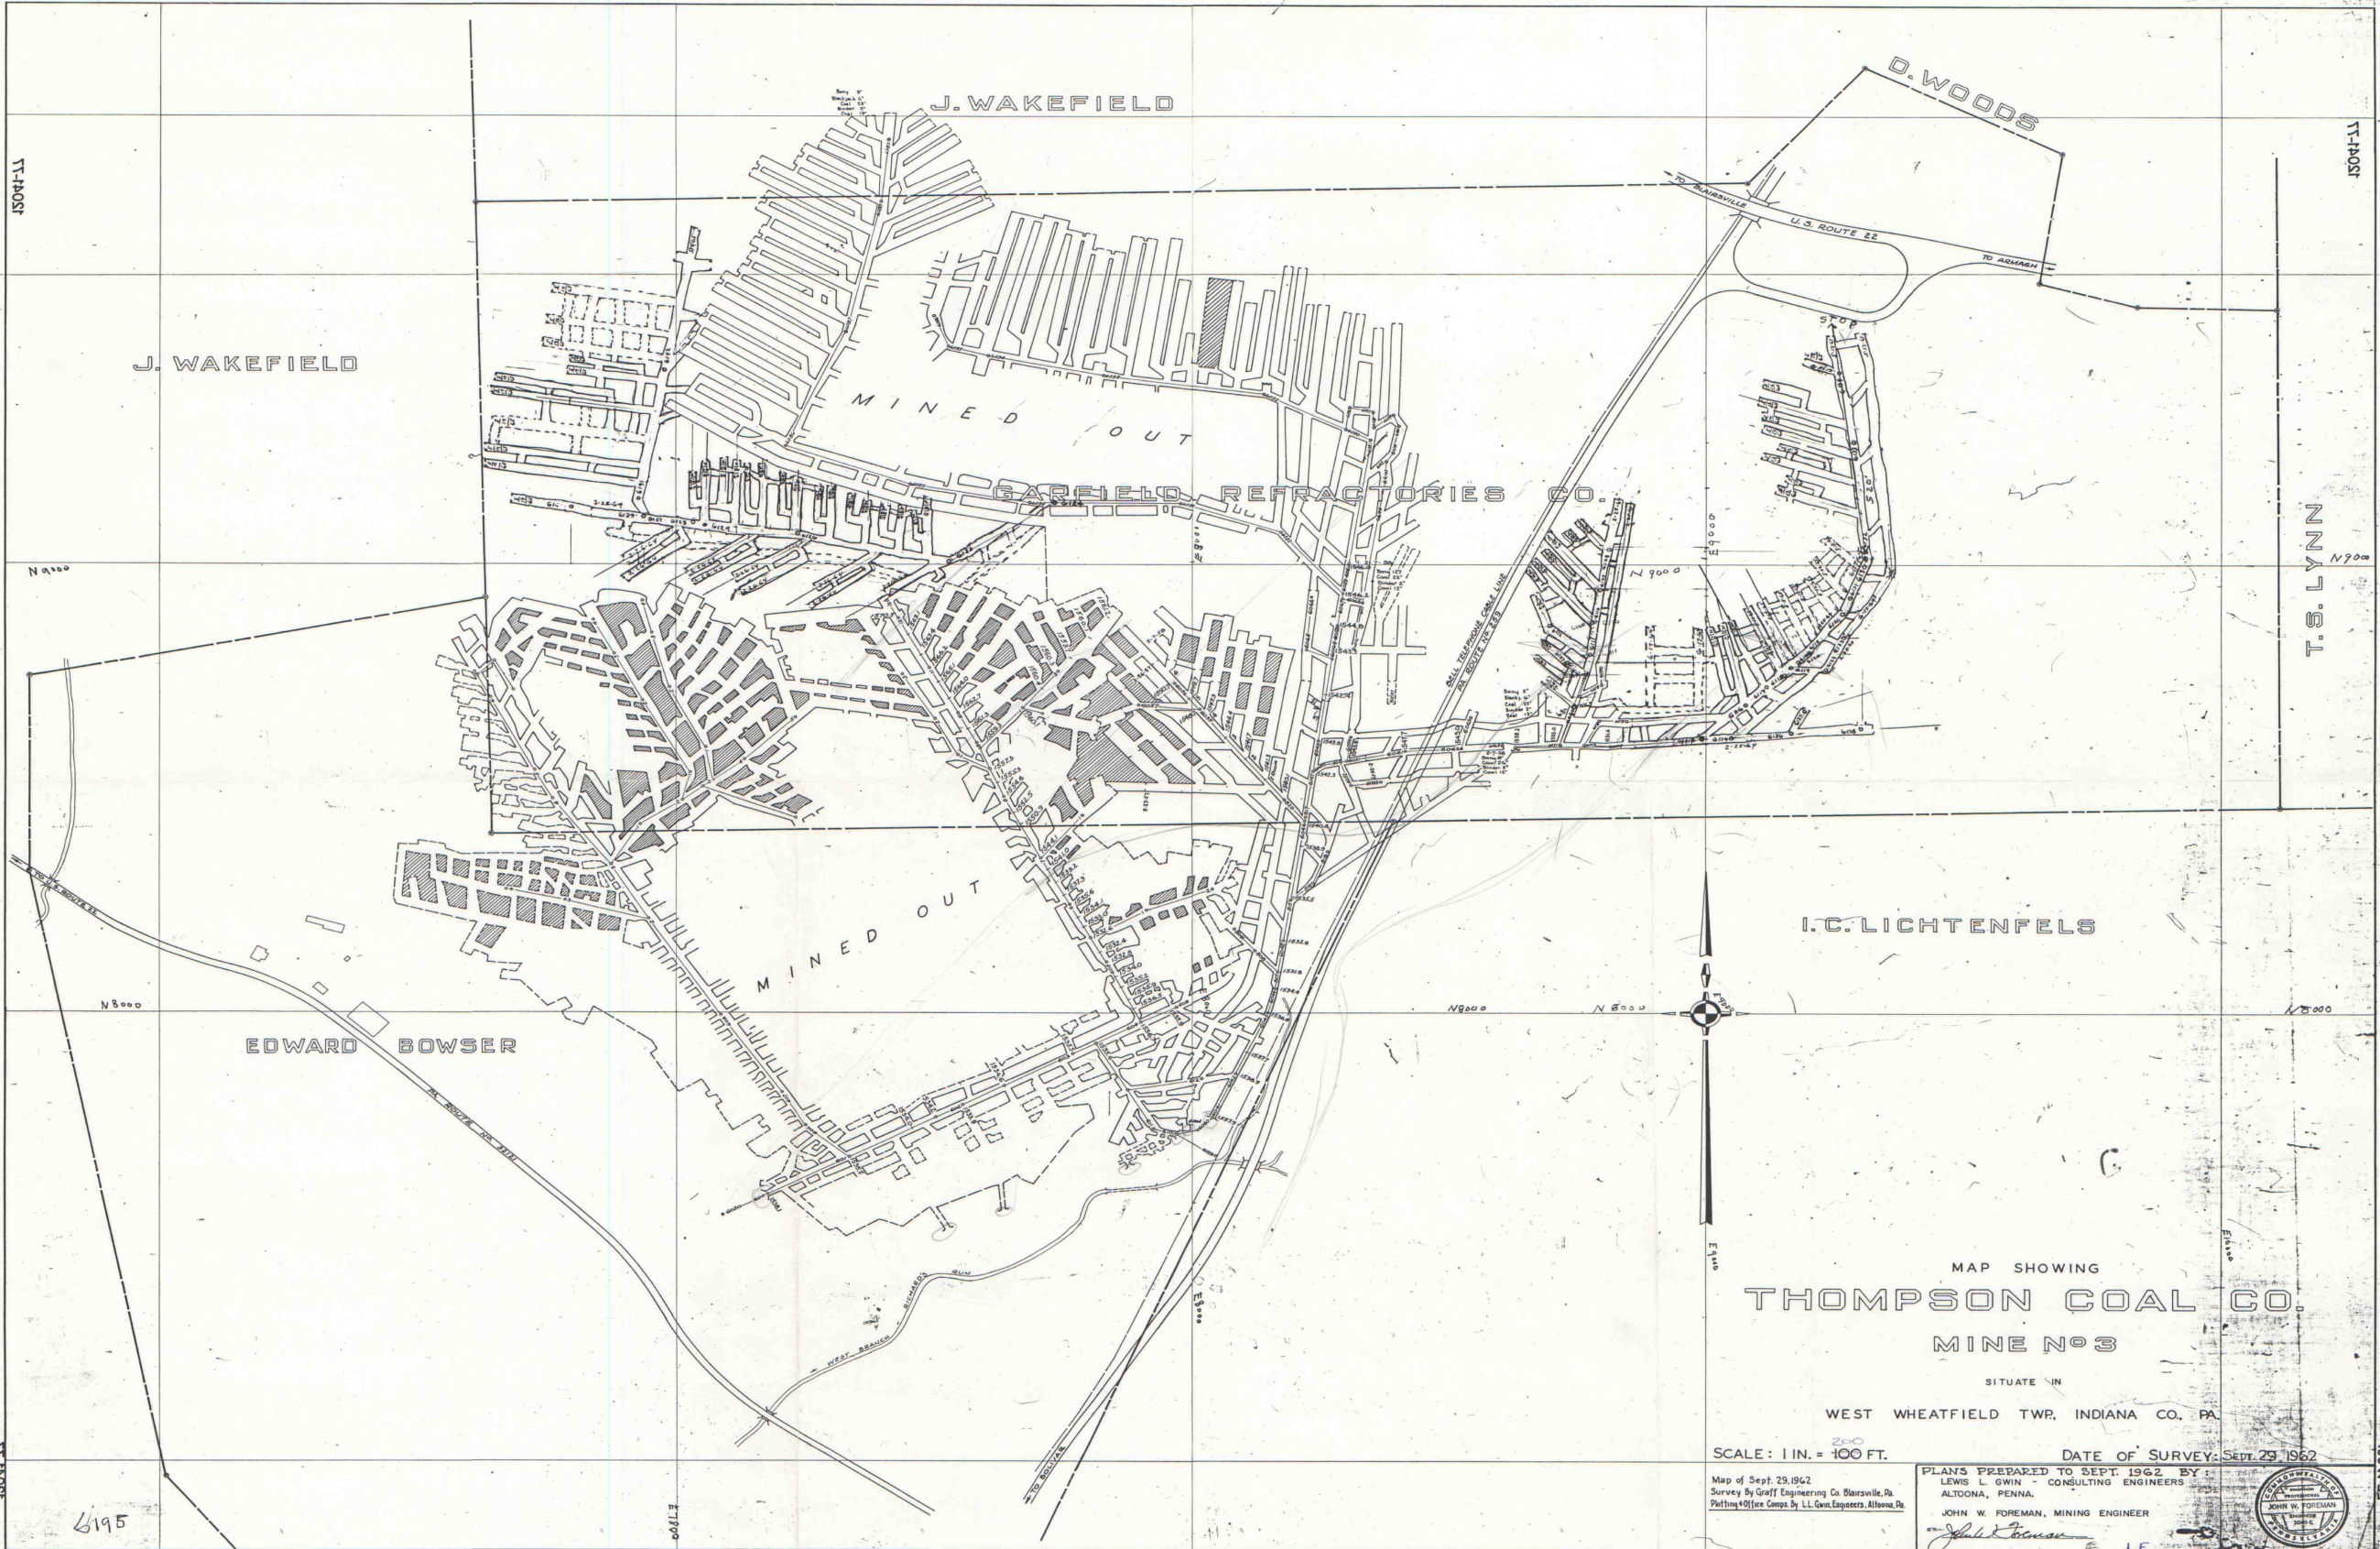

MAP SHOWING
THOMPSON COAL CO.
MINE NO. 3

SITUATE IN
WEST WHEATFIELD TWP., INDIANA CO., PA.

SCALE: 1 IN. = 100 FT.

DATE OF SURVEY: SEPT. 29, 1962

Map of Sept. 29, 1962
Survey By Graff Engineering Co. Blairsville, Pa.
Plotting Office Camps By L.L. Gwin, Engineers, Altoona, Pa.

PLANS PREPARED TO SEPT. 1962 BY:
LEWIS L. GWIN - CONSULTING ENGINEERS
ALTOONA, PENNA.

JOHN W. FOREMAN, MINING ENGINEER

