


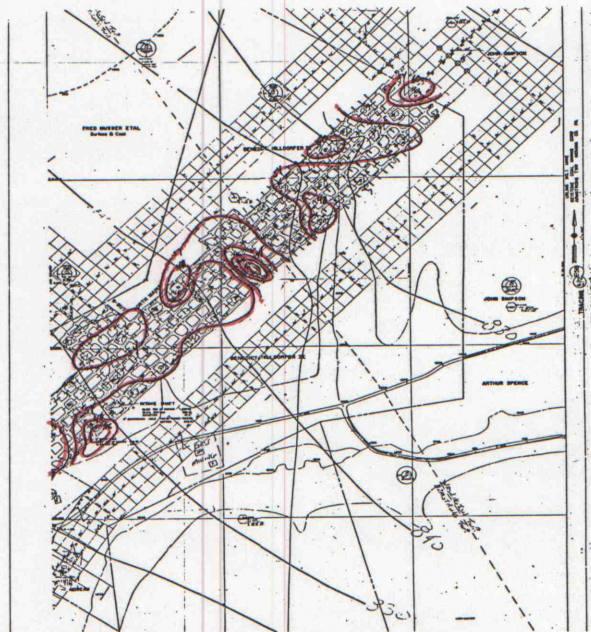

IMAPS # 17335