

PENNA. STATE GAME LANDS
warrant 3575


Cle 146

PENNA. DEPT. of FORESTS and WATERS
(SURFACE)
THOMAS E. REITZ
(MINERAL)

GREEN GLEN CORP.
(SURFACE)
THOMAS E. REITZ
(MINERAL)

LEGEND

BELTS
DEVELOPMENT PLANS
DOORS
ESCAPE WAY
GAS WELLS WITHIN MINE
INTAKE AIR CURRENT
OVERCASTS
PERMANENT STOPPINGS
REGULATOR
RETURN AIR CURRENT
SEALS (if and when needed)
UNDERCASTS
LINE BRATTICE
CHECK CURTAINS
LOW SLOPE

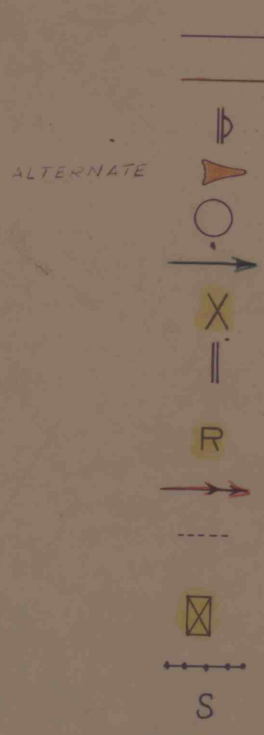

General: The following information shall be submitted to the District Manager:

- Company Name: GLEN IRVAN CORPORATION
Mine Name: BARK CAMP No. 2
Post Office Address: P.O. Box 36
(Town, County, State): Clearfield Co., Pa.
Telephone Number: 84-637-9965
USBM Identification No.: 38-0127-0
Operator's Name: IRVAN STOKES
Operator's Title: PRESIDENT
Operator's Address: 801 Duquesne, Pa.
Operator's Telephone No.: 84-187-7250
- Indicate if the mine is:
☐ less than one year old
☐ greater than one year
- Number of employees: Surface
Underground
Total

LEGEND

Contemplated Mining
Mining Completed Area

Permit No. 73-3

Glen Irvan Corp.
Ventilation Map
Bark Camp No. 2

Huston Township Clearfield Co. Pa.

SCALE- 1 inch = 100 feet

FEBRUARY 2, 1971
CLEARFIELD, PA.

HESS & FISHER
ENGINEERS, INC.
M-CH 1 A

No MINES ABOVE OR BELOW
To the date 2/2/72 this is a complete and accurate
map of all the workings and workings set apart of the
Bark Camp No. 2 mine