


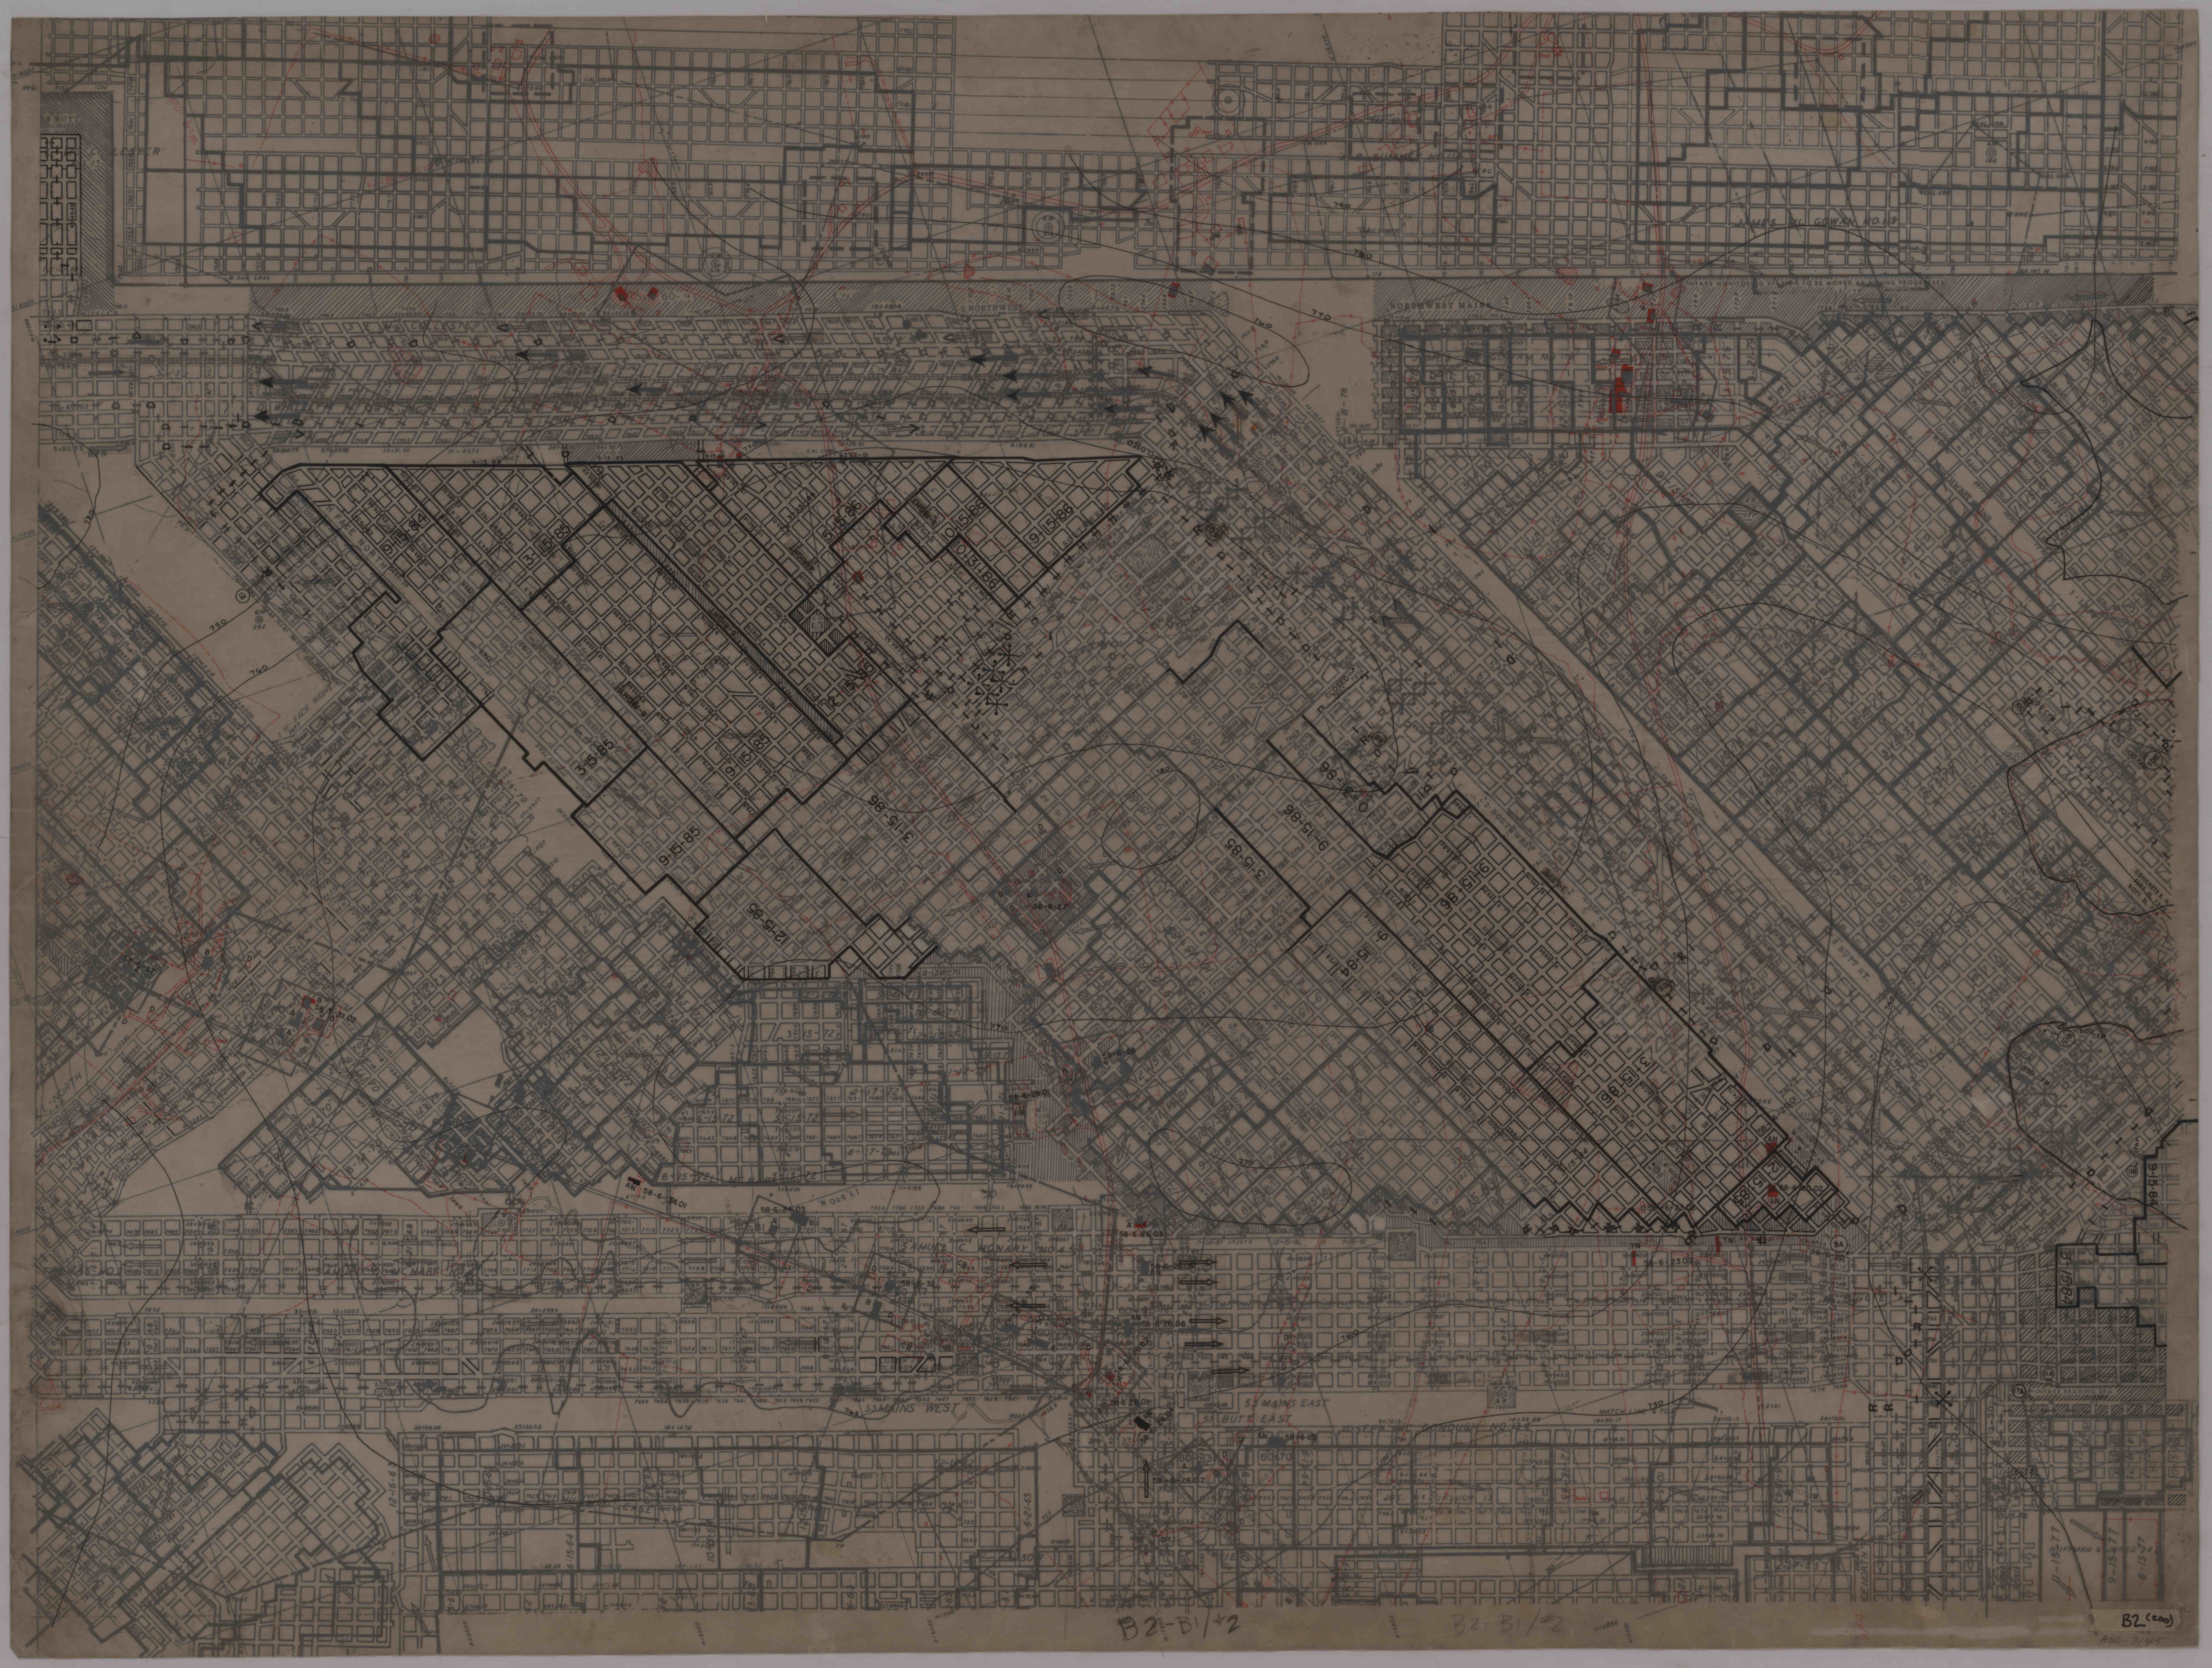

B2-B1/2

B2-B1/2

B2 (copy)