


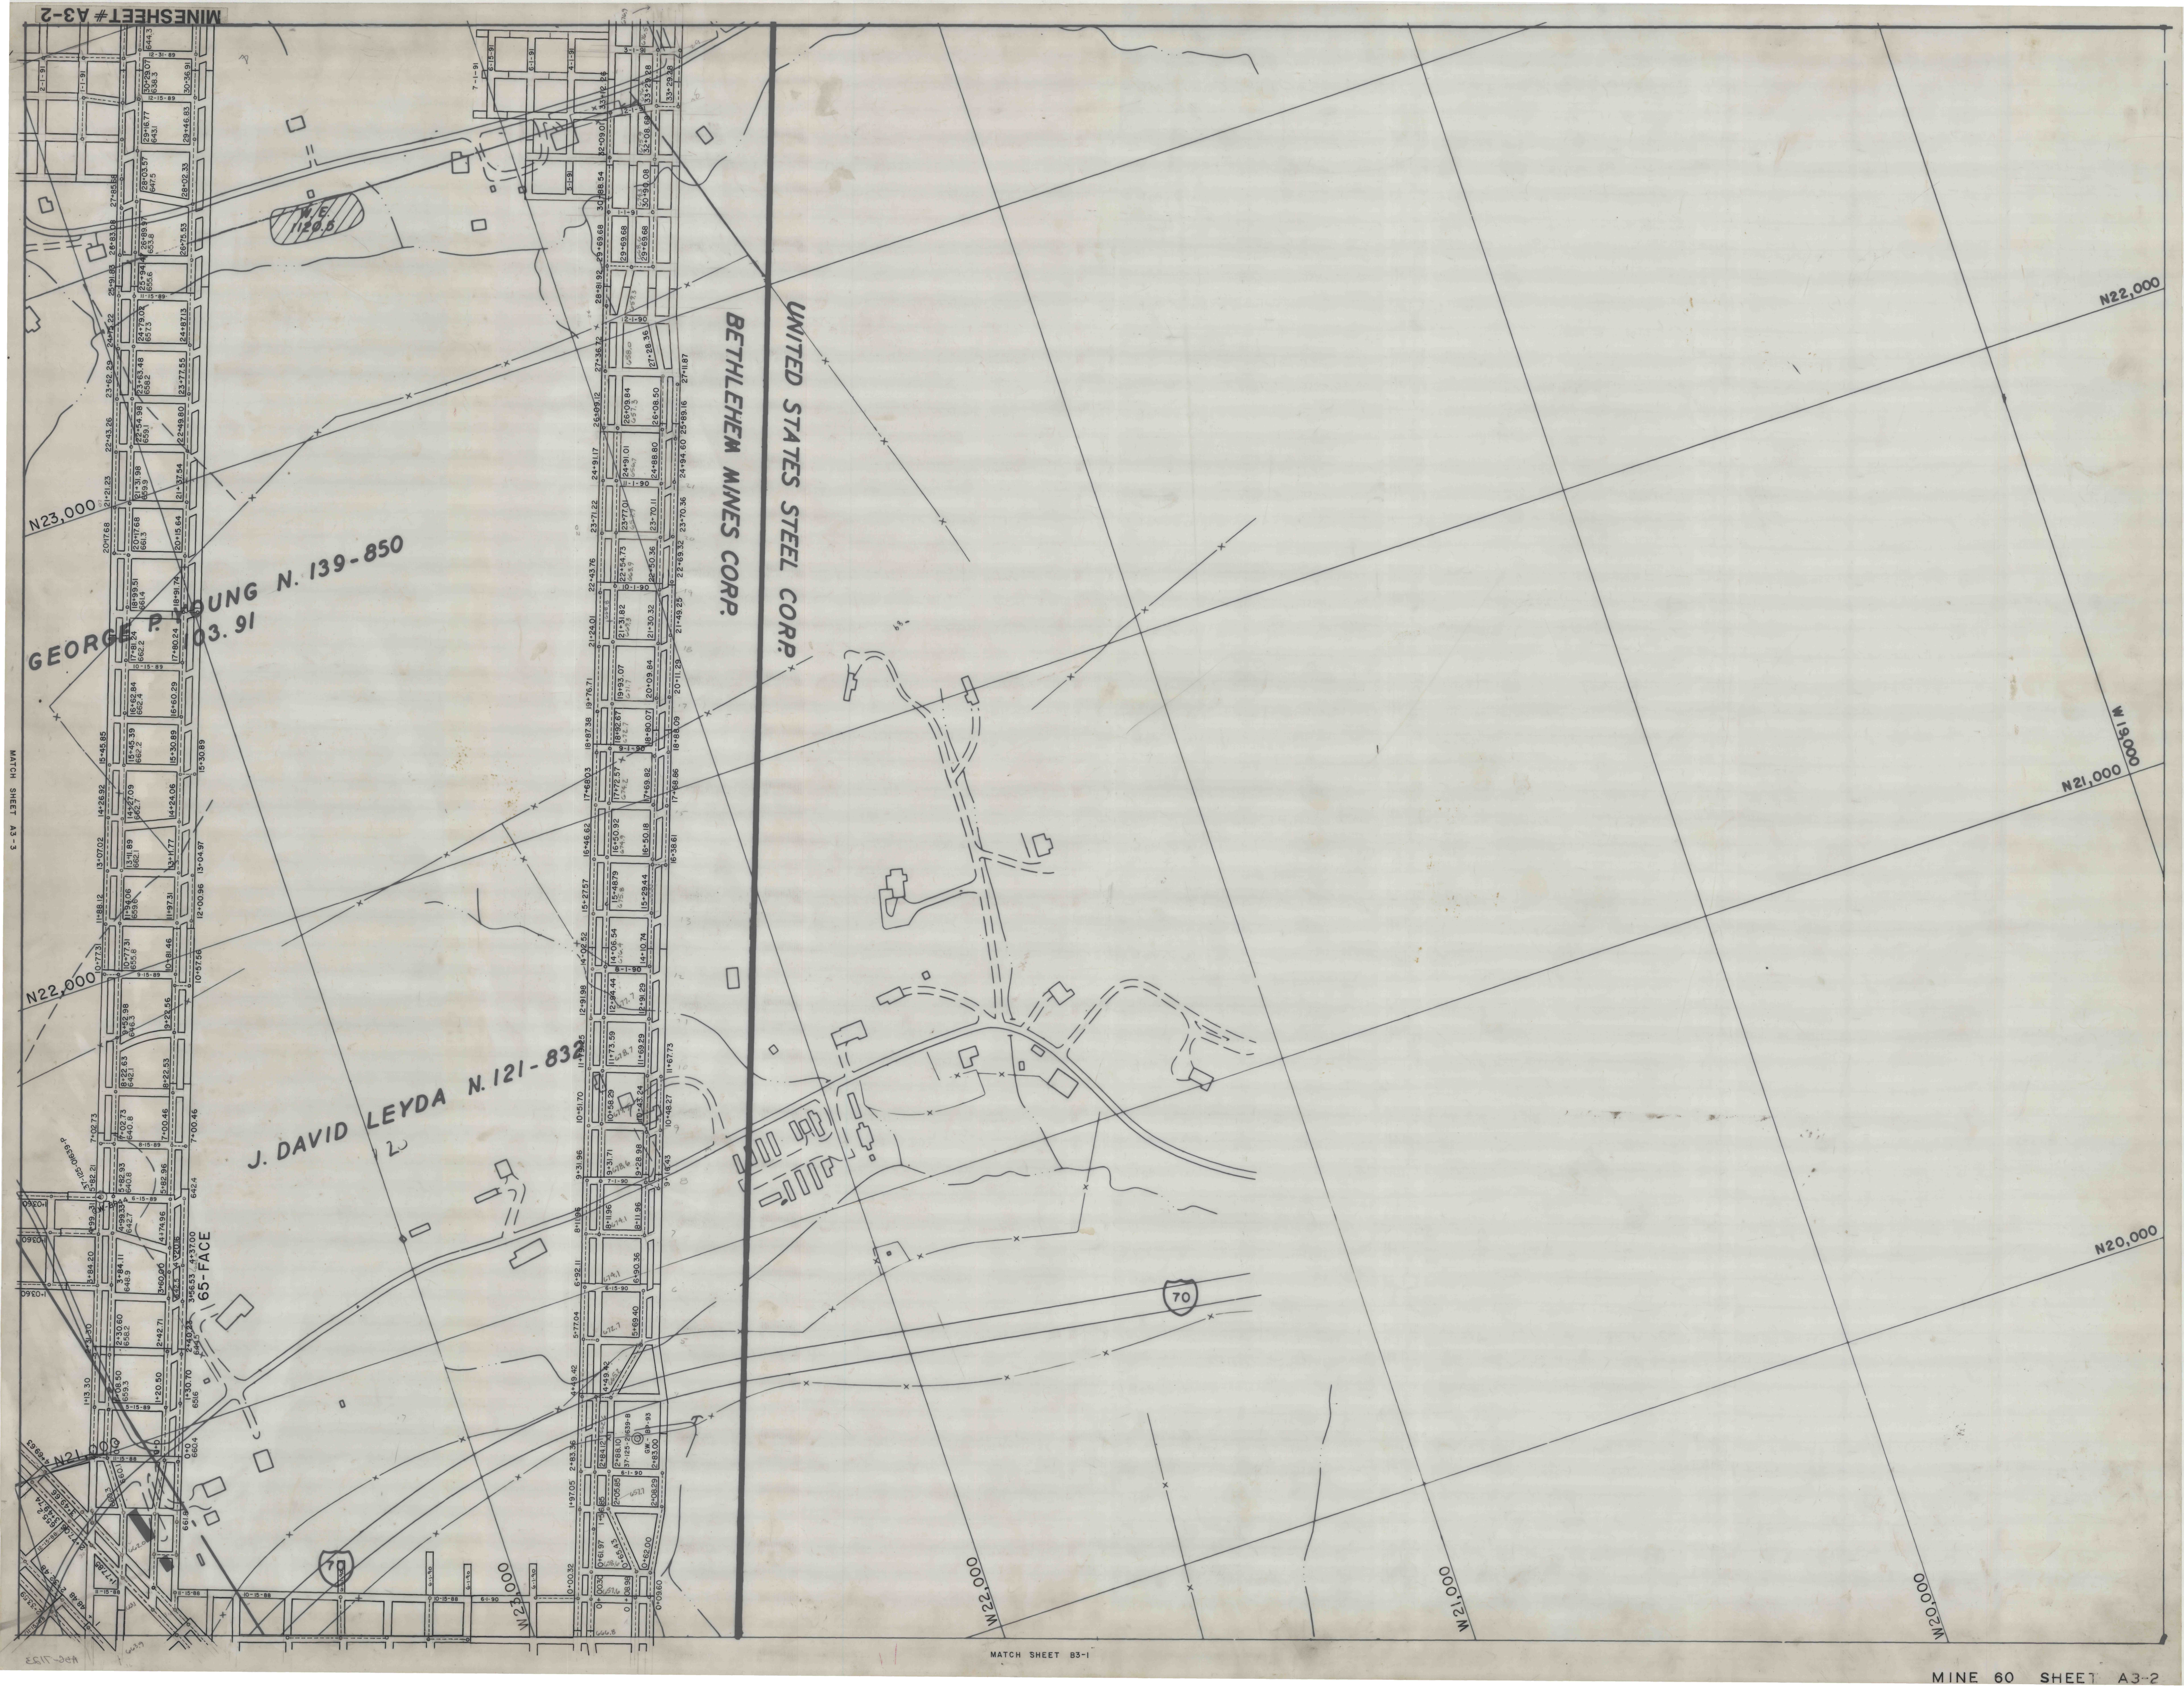

MINE 60 SHEET A3-2


J. DAVID LEYDA N. 121-832

BETHLEHEM MINES CORP.

UNITED STATES STEEL CORP.

65-FACE

N22,000

N20,000

N20,000

N20,000

N21,000

N22,000

MATCH SHEET B3-1

MINE 60 SHEET A3-2