


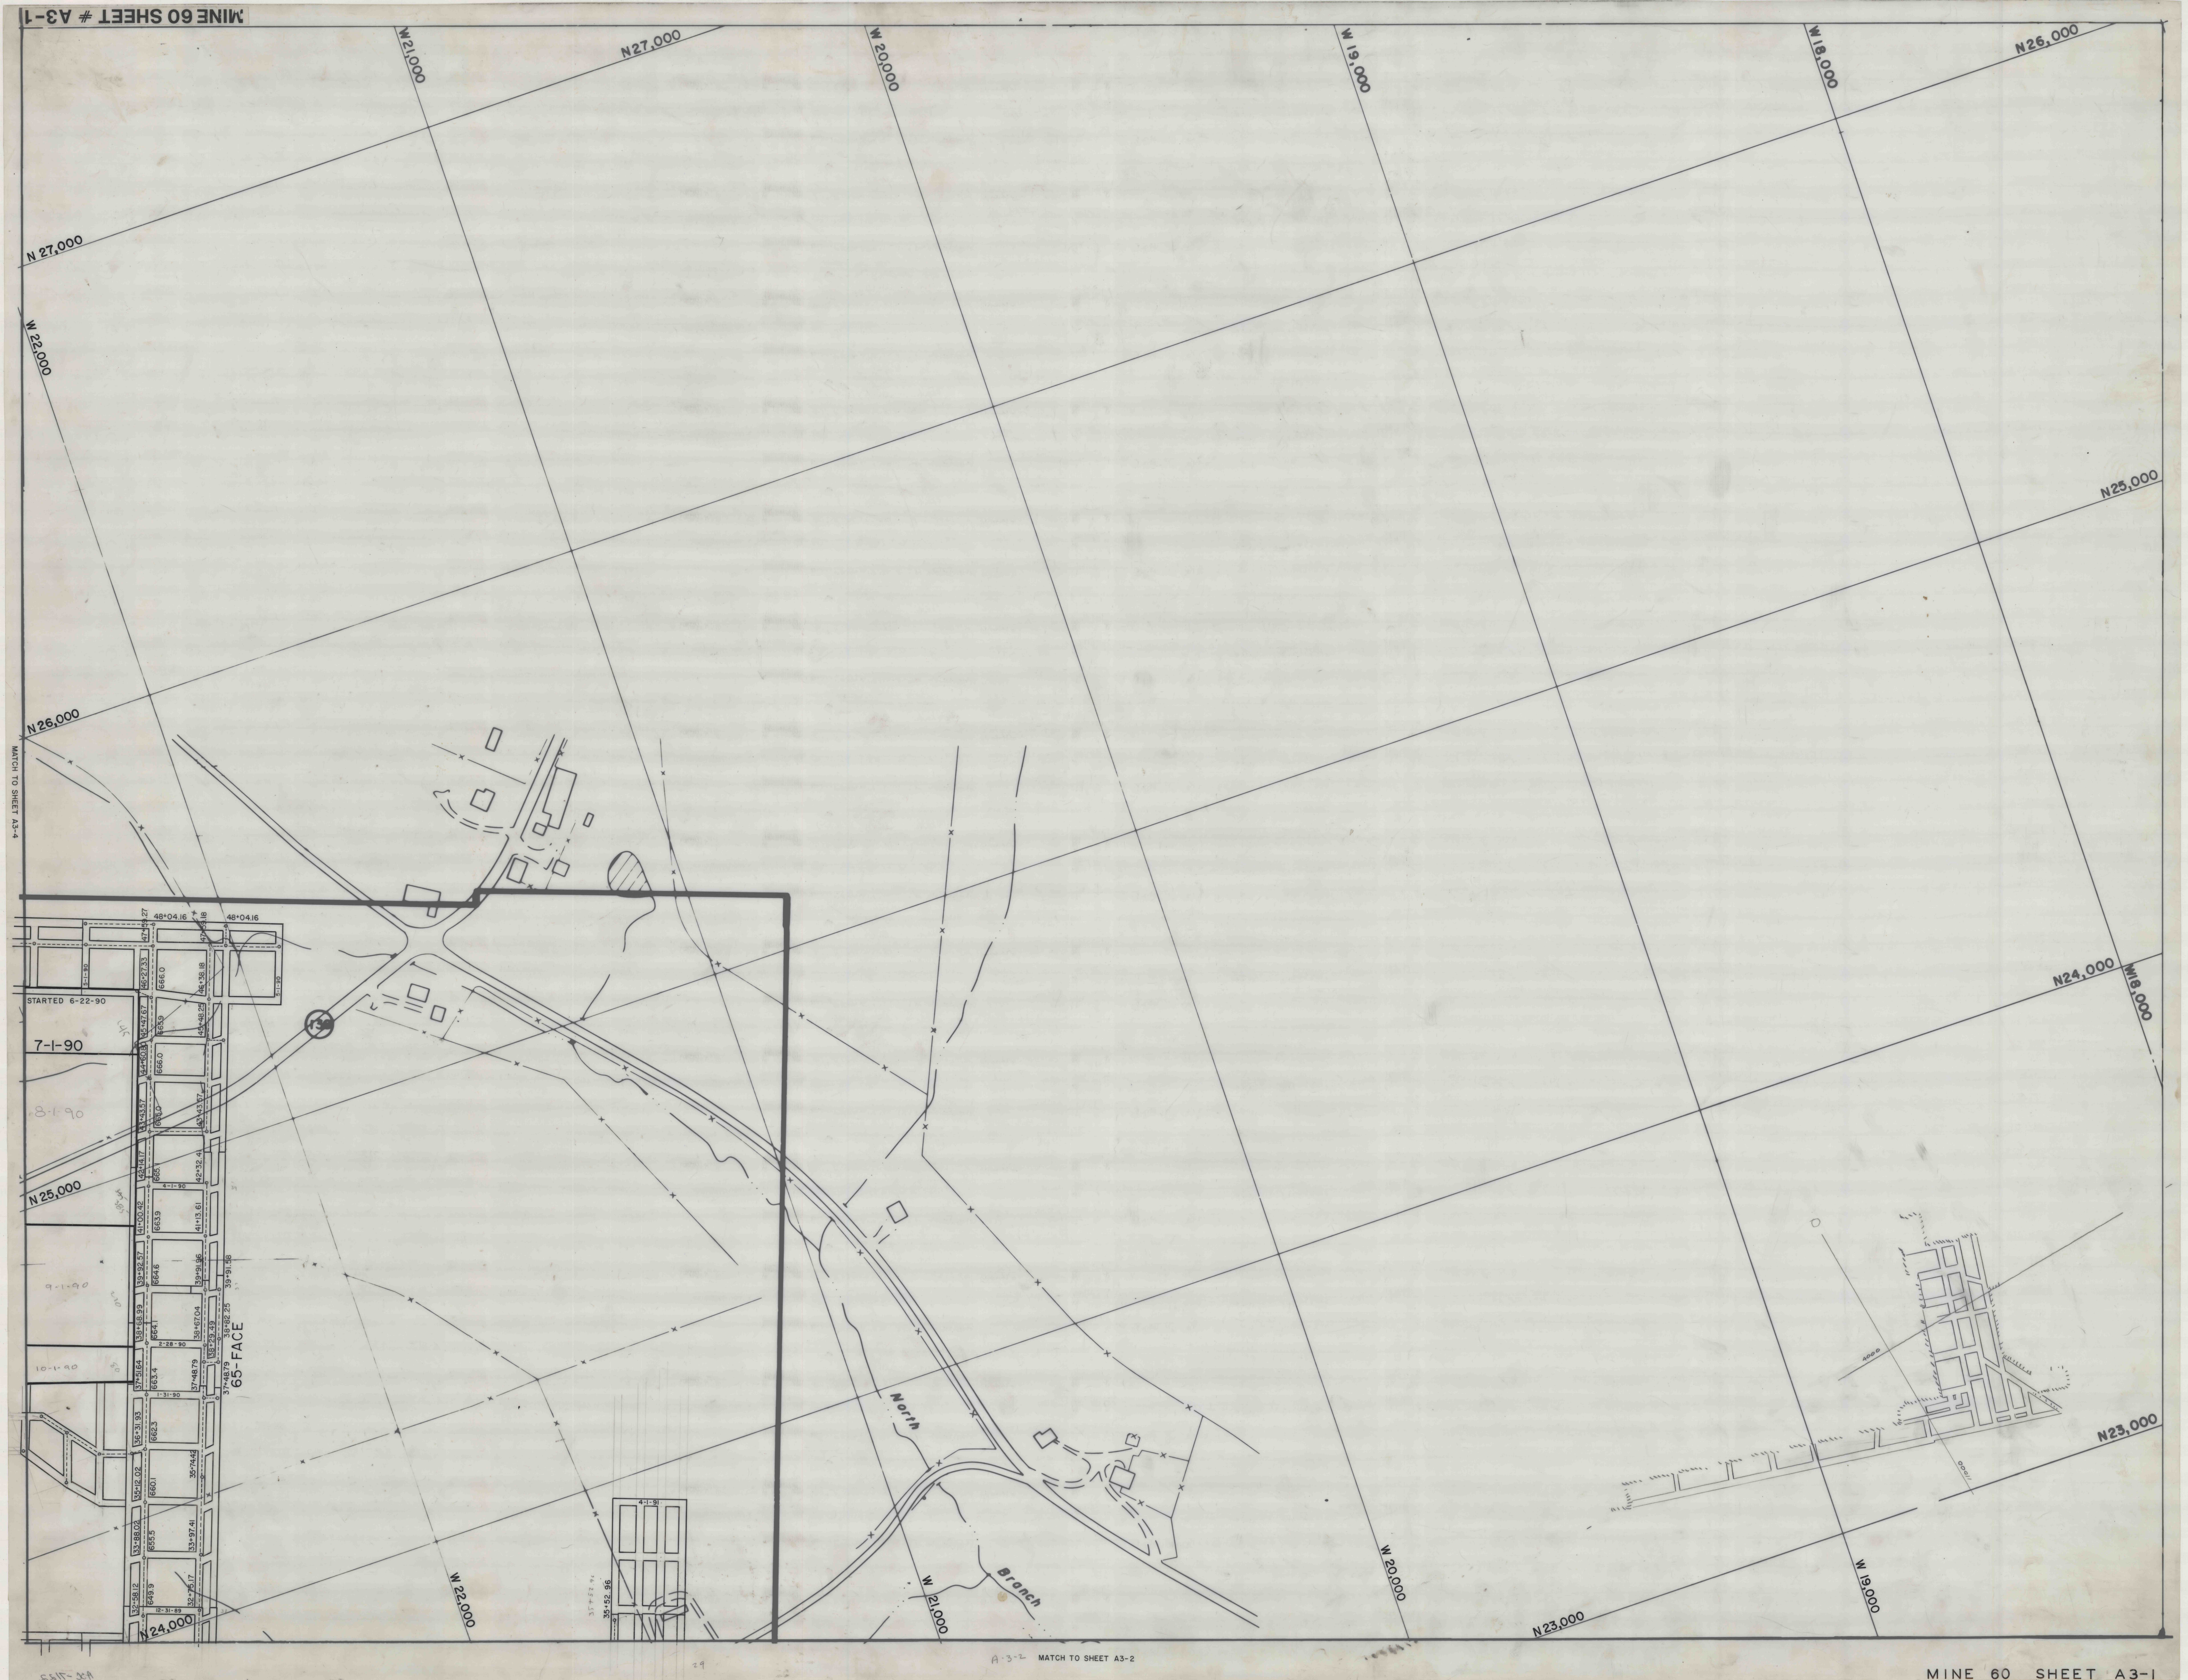

MATCH TO SHEET A3-4