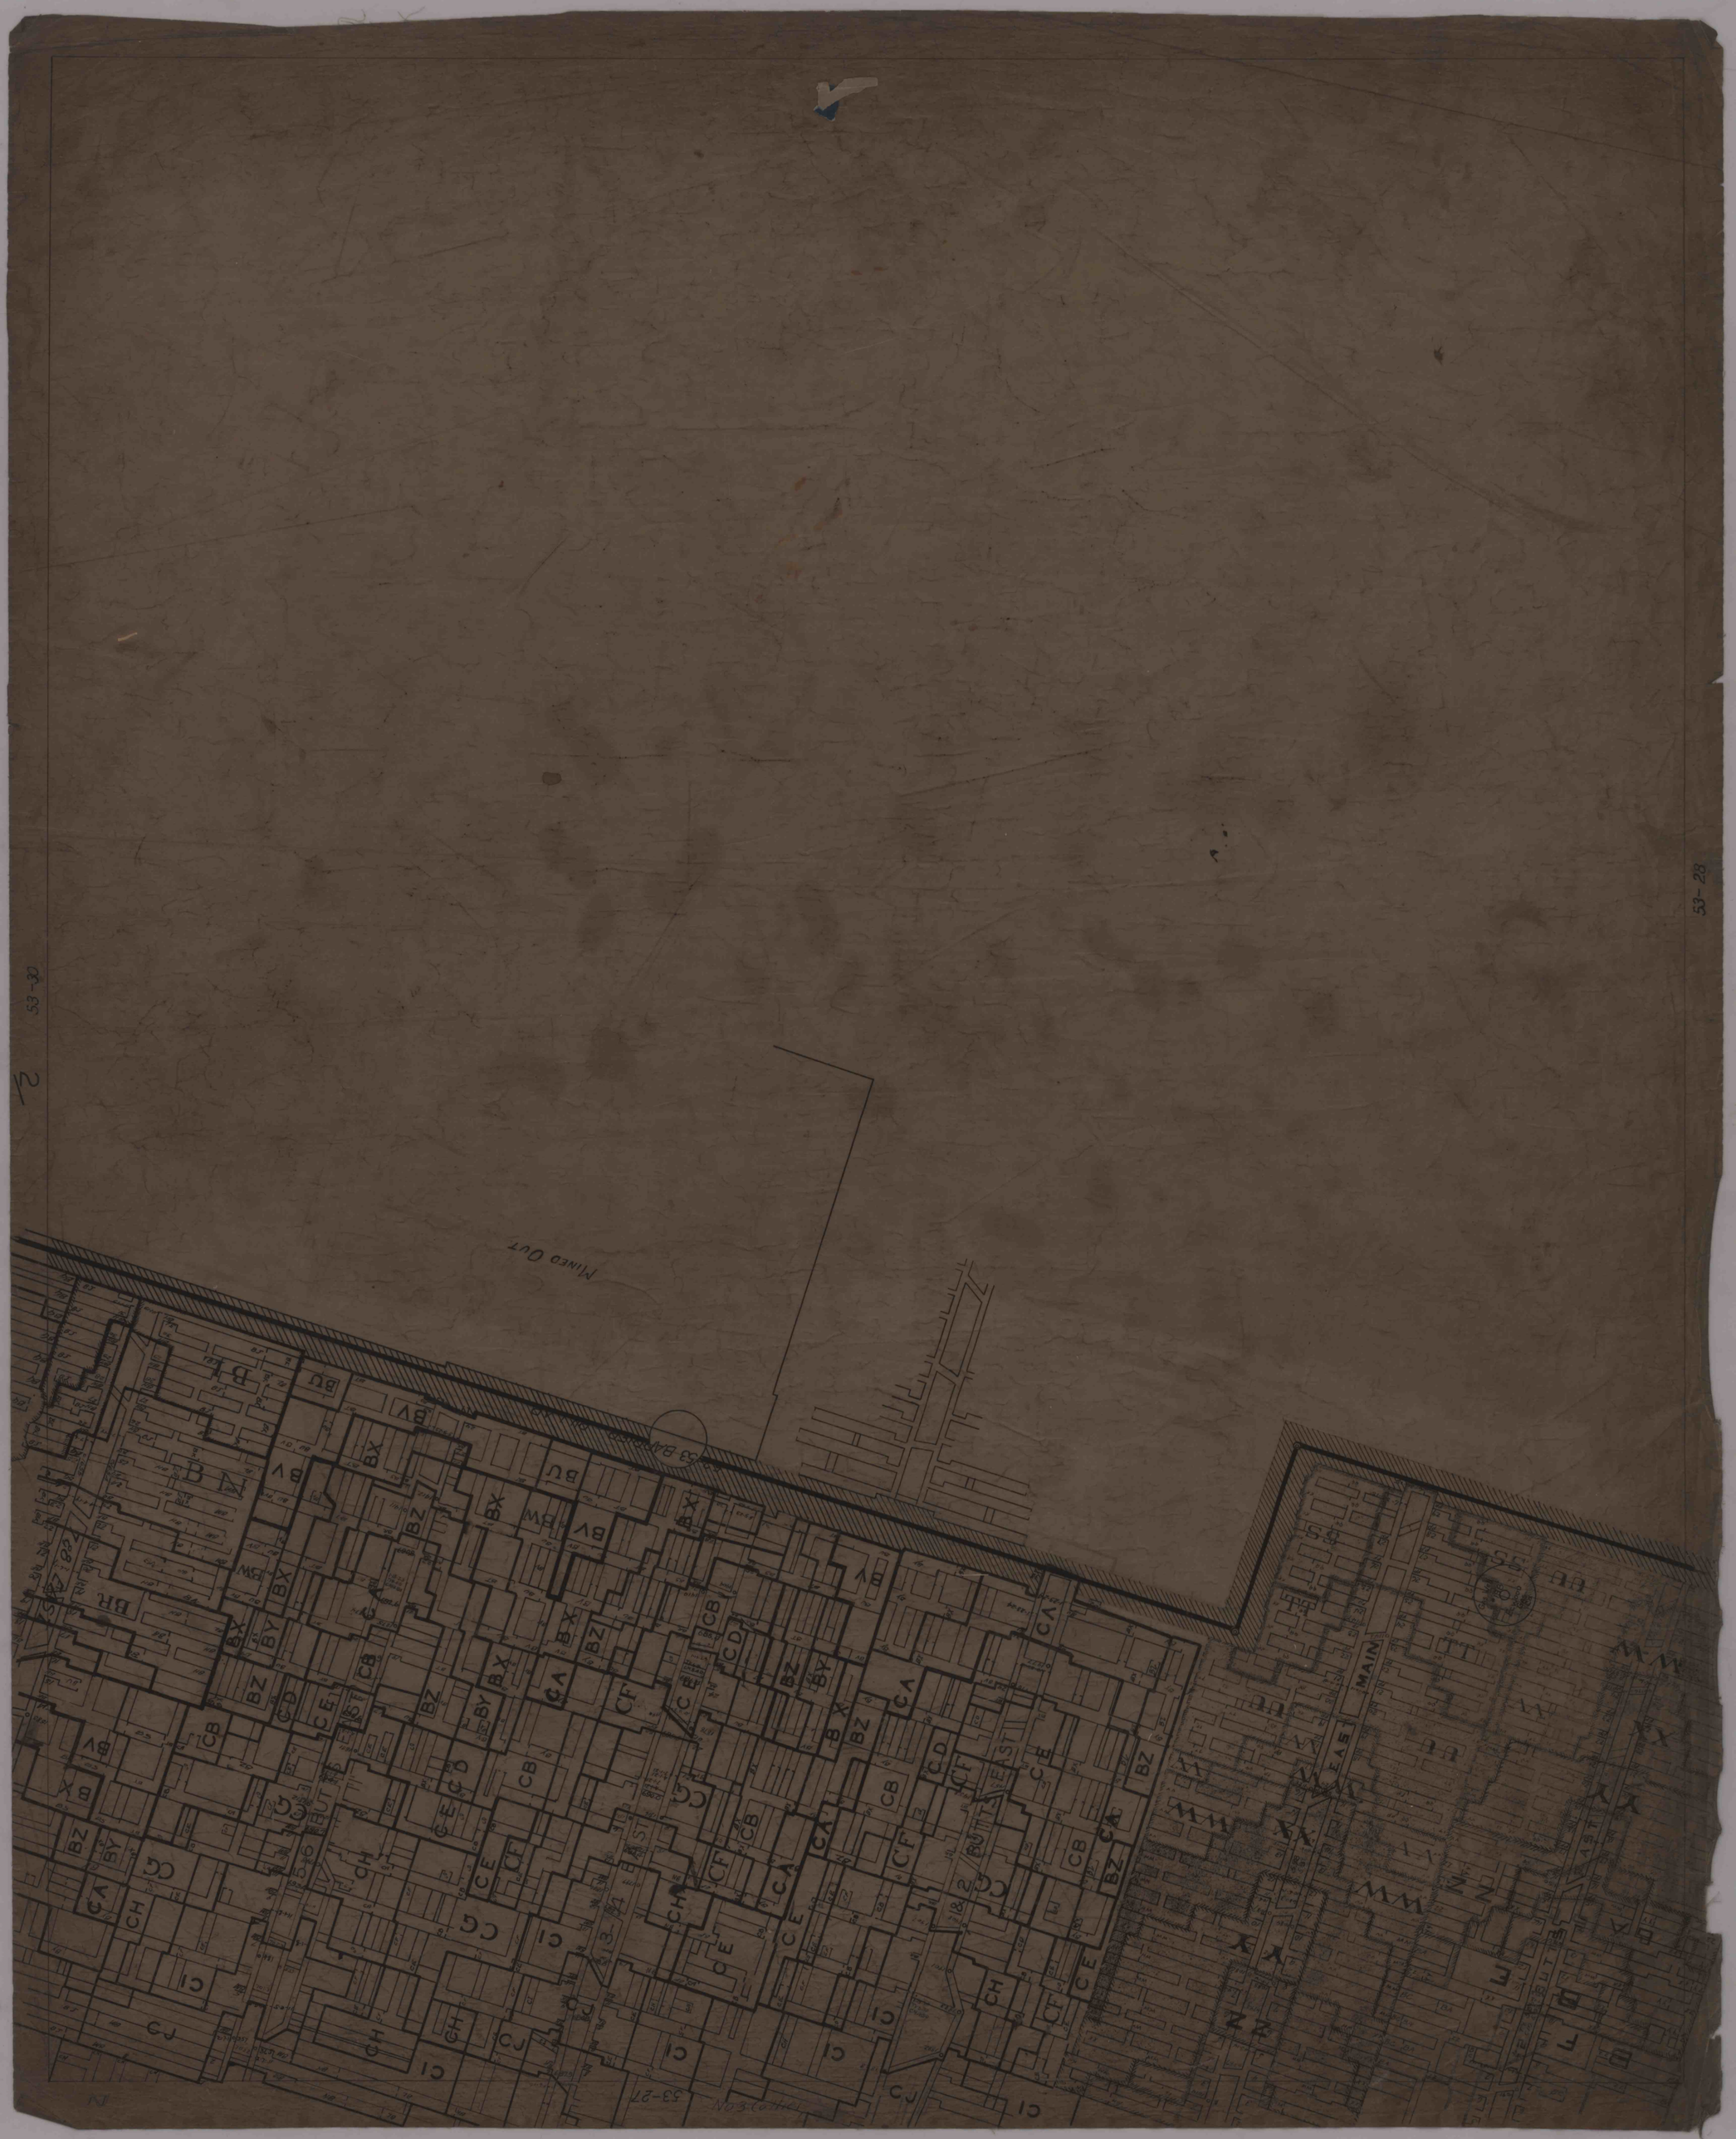
53-30
53-28
Mined Out
53 Barrier
53-27
MAIN
EAST
BUTTE
N