


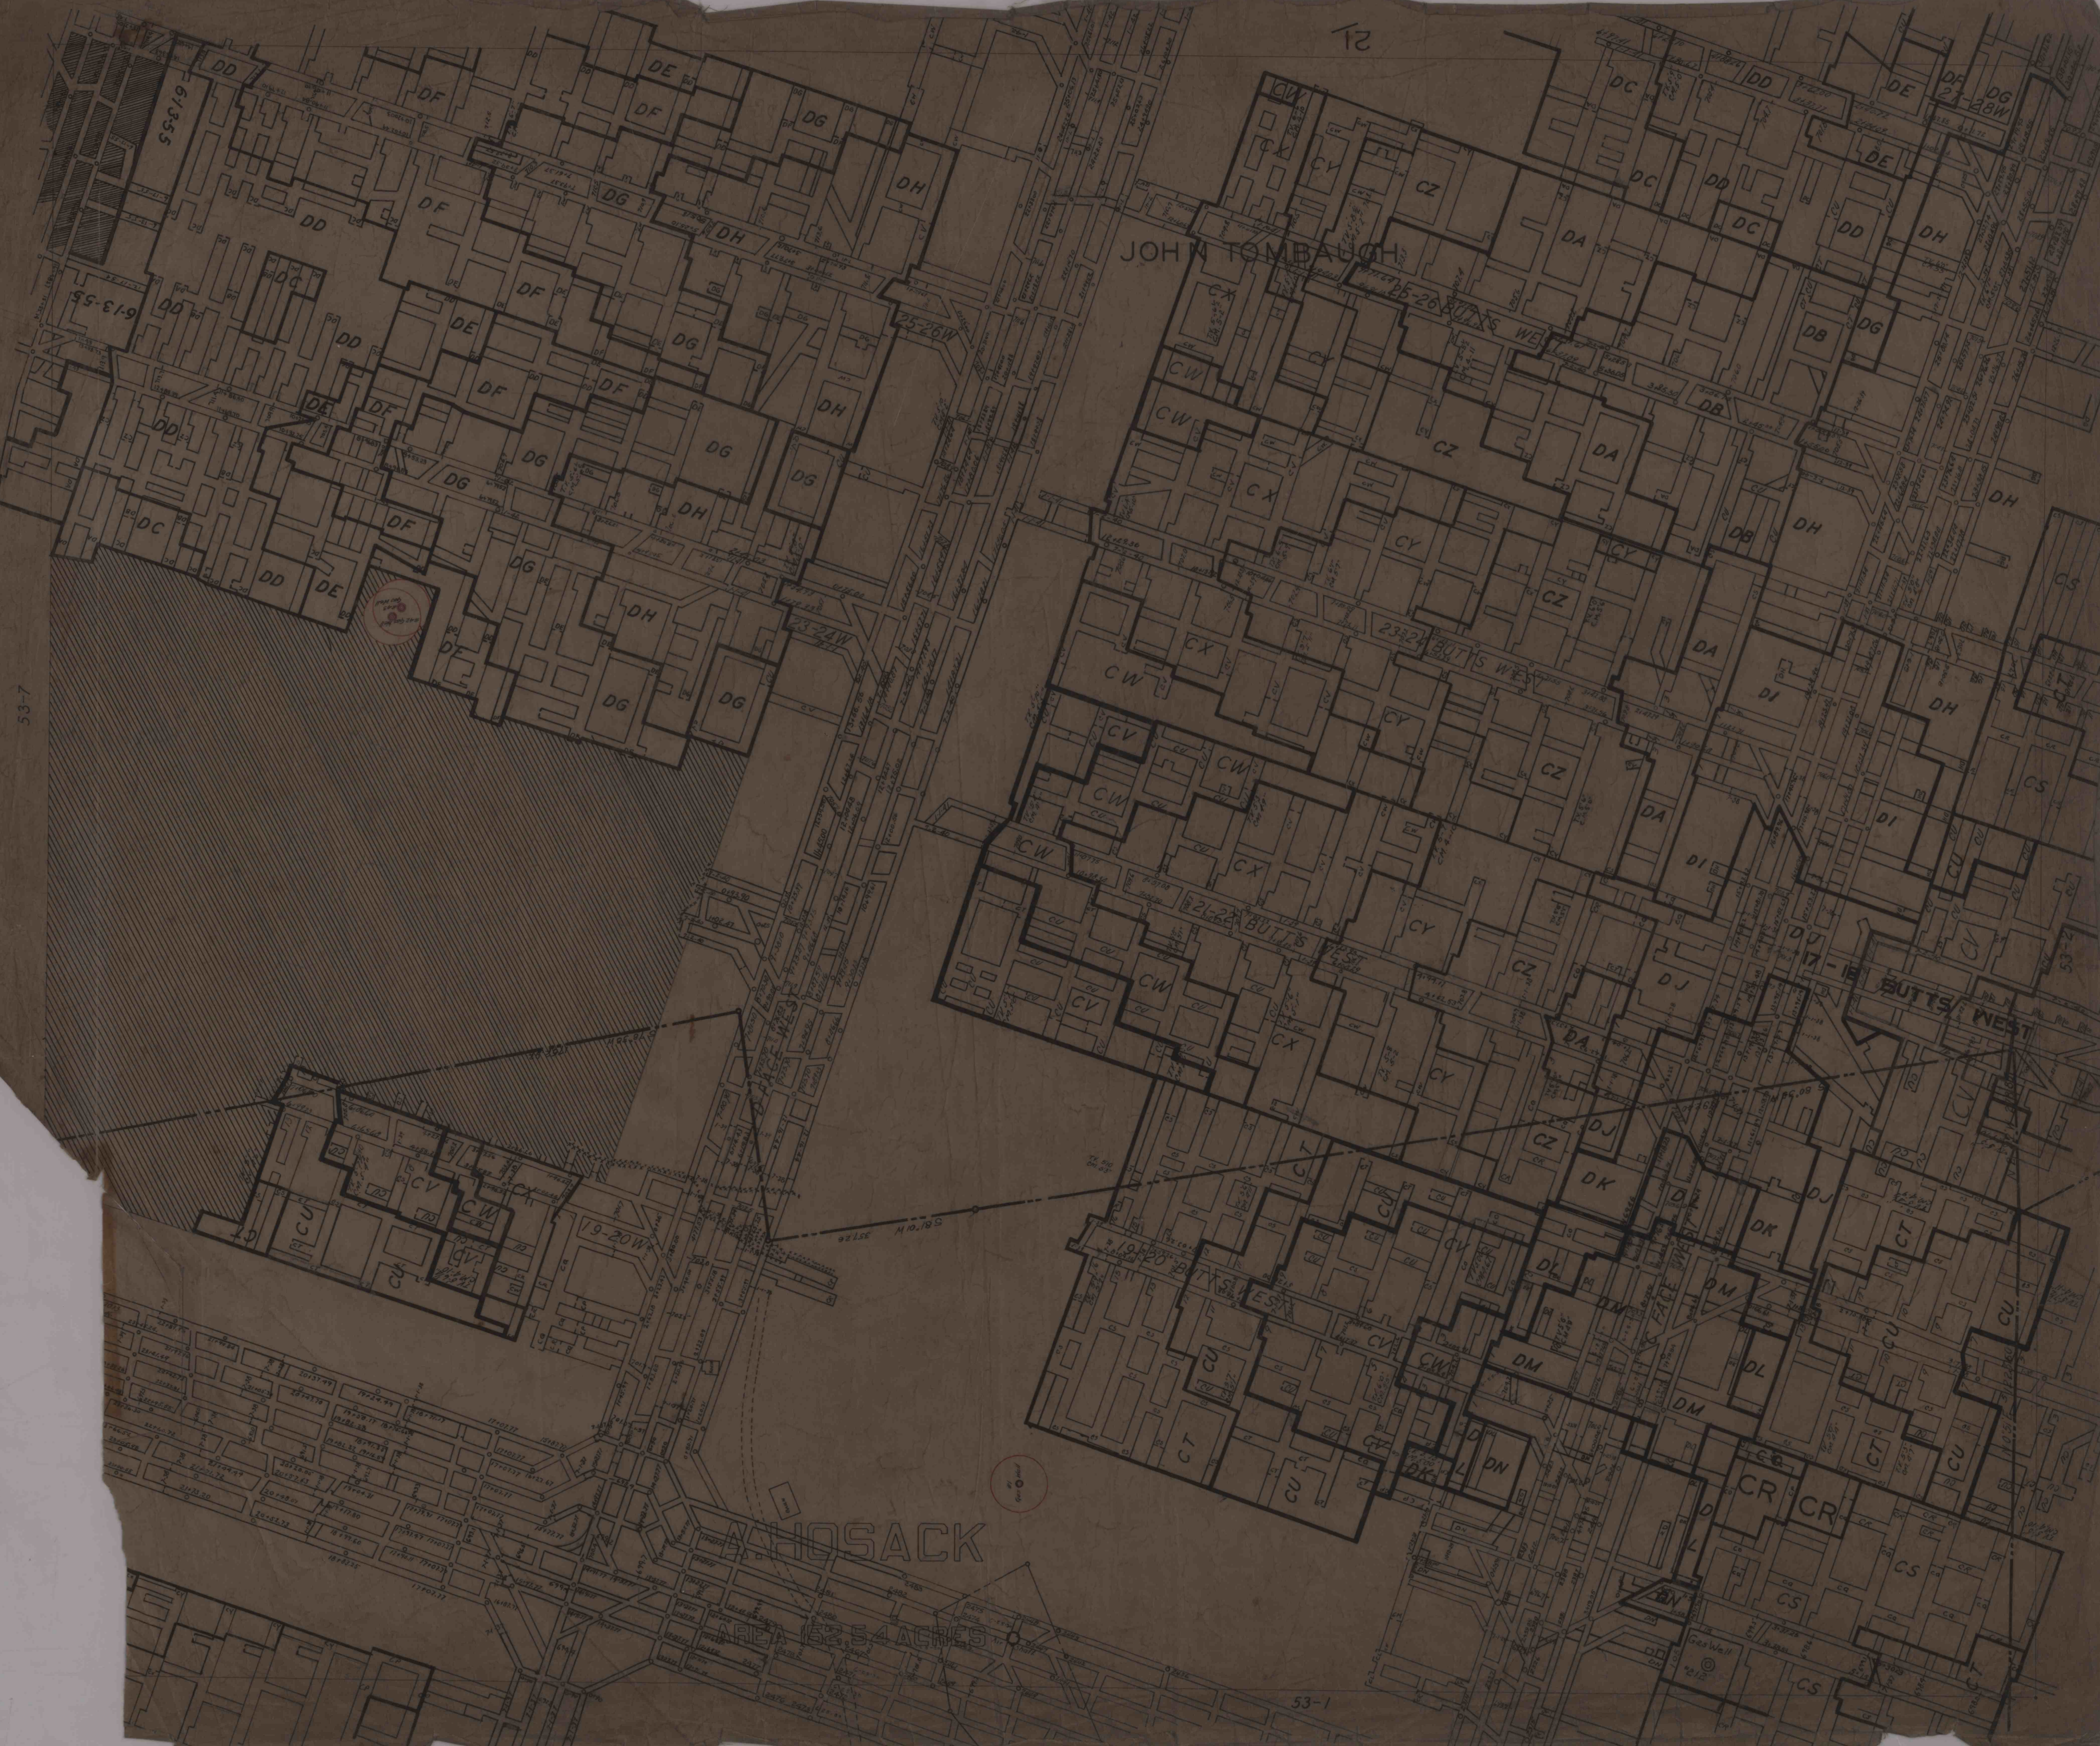

JOHN TOMBAUGH

BUTTS WEST

ANOSACK

AREA 152.54 ACRES

53-7

53-1