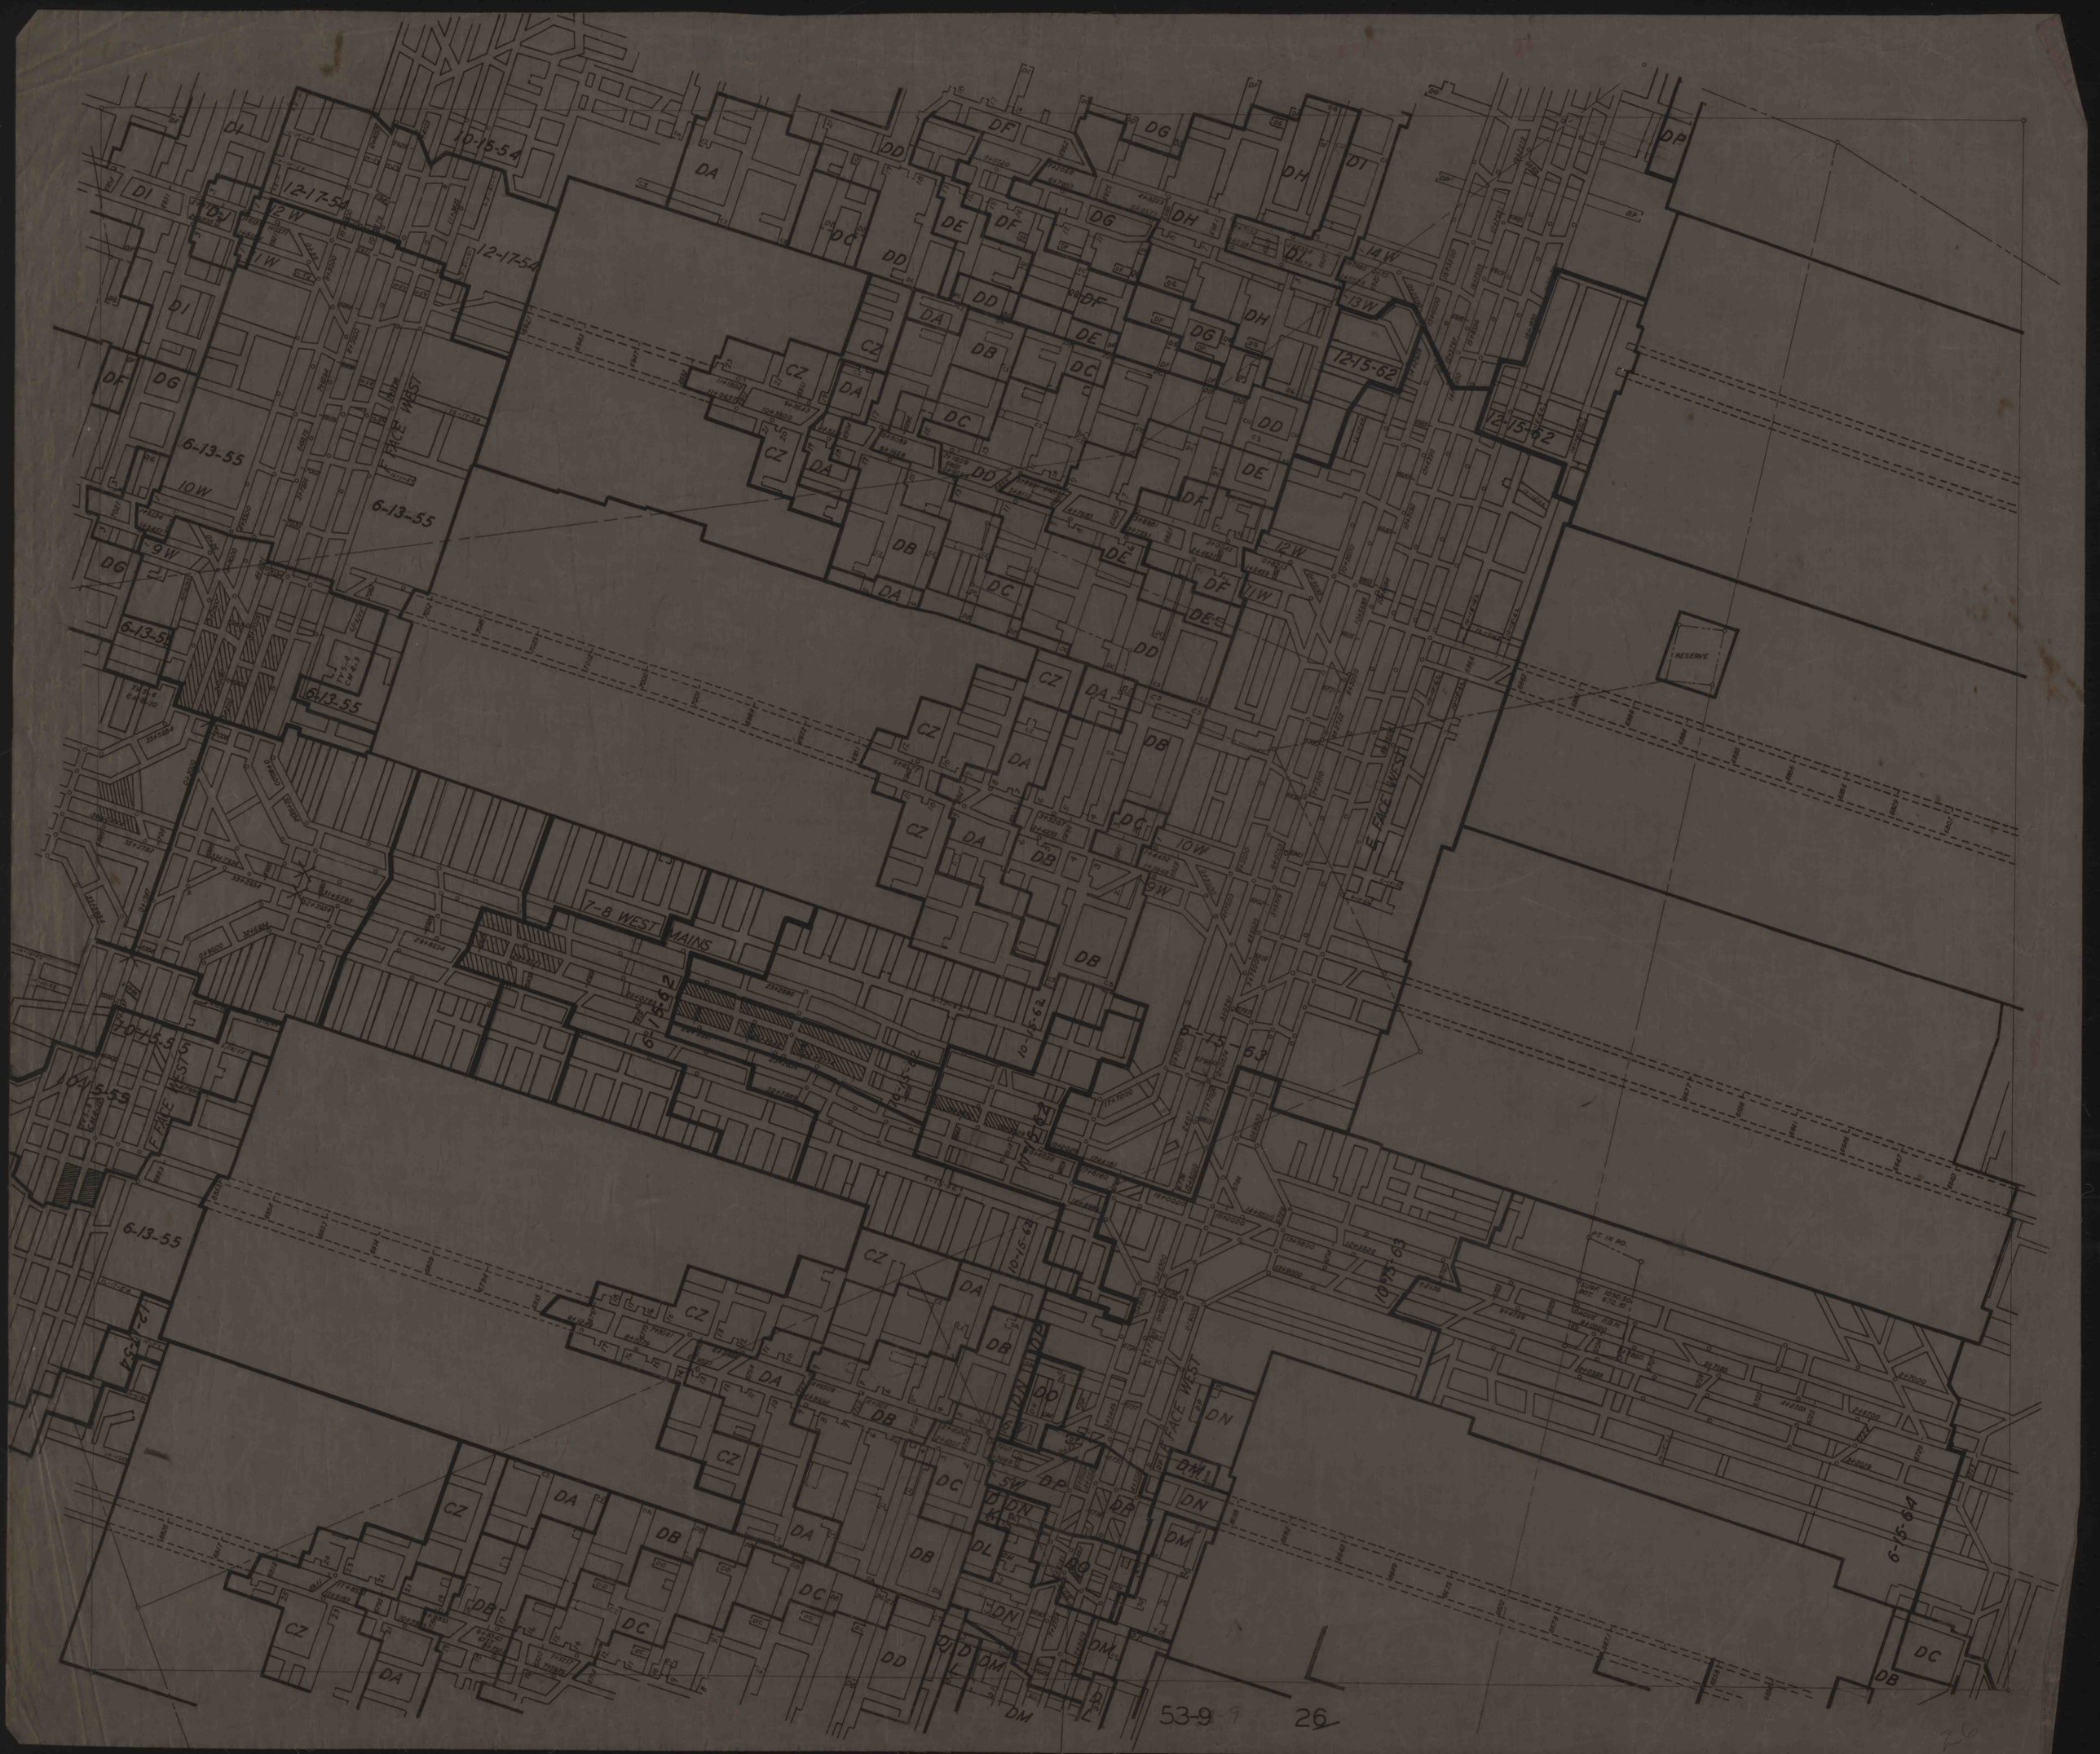
10-15-54
12-17-54
12-17-54
6-13-55
6-13-55
6-13-55
6-13-55
6-13-55
6-13-55
12-15-62
12-15-62
E FACE WEST
E FACE WEST
E FACE WEST
E FACE WEST
E FACE WEST
7-8 WEST MAINS
RESERVE
PT. IN PO.
DA
DB
DC
DD
DE
DF
DG
DH
DI
DJ
DL
DM
DN
DP
CZ
1W
2W
9W
10W
12W
13W
14W
53-9
26