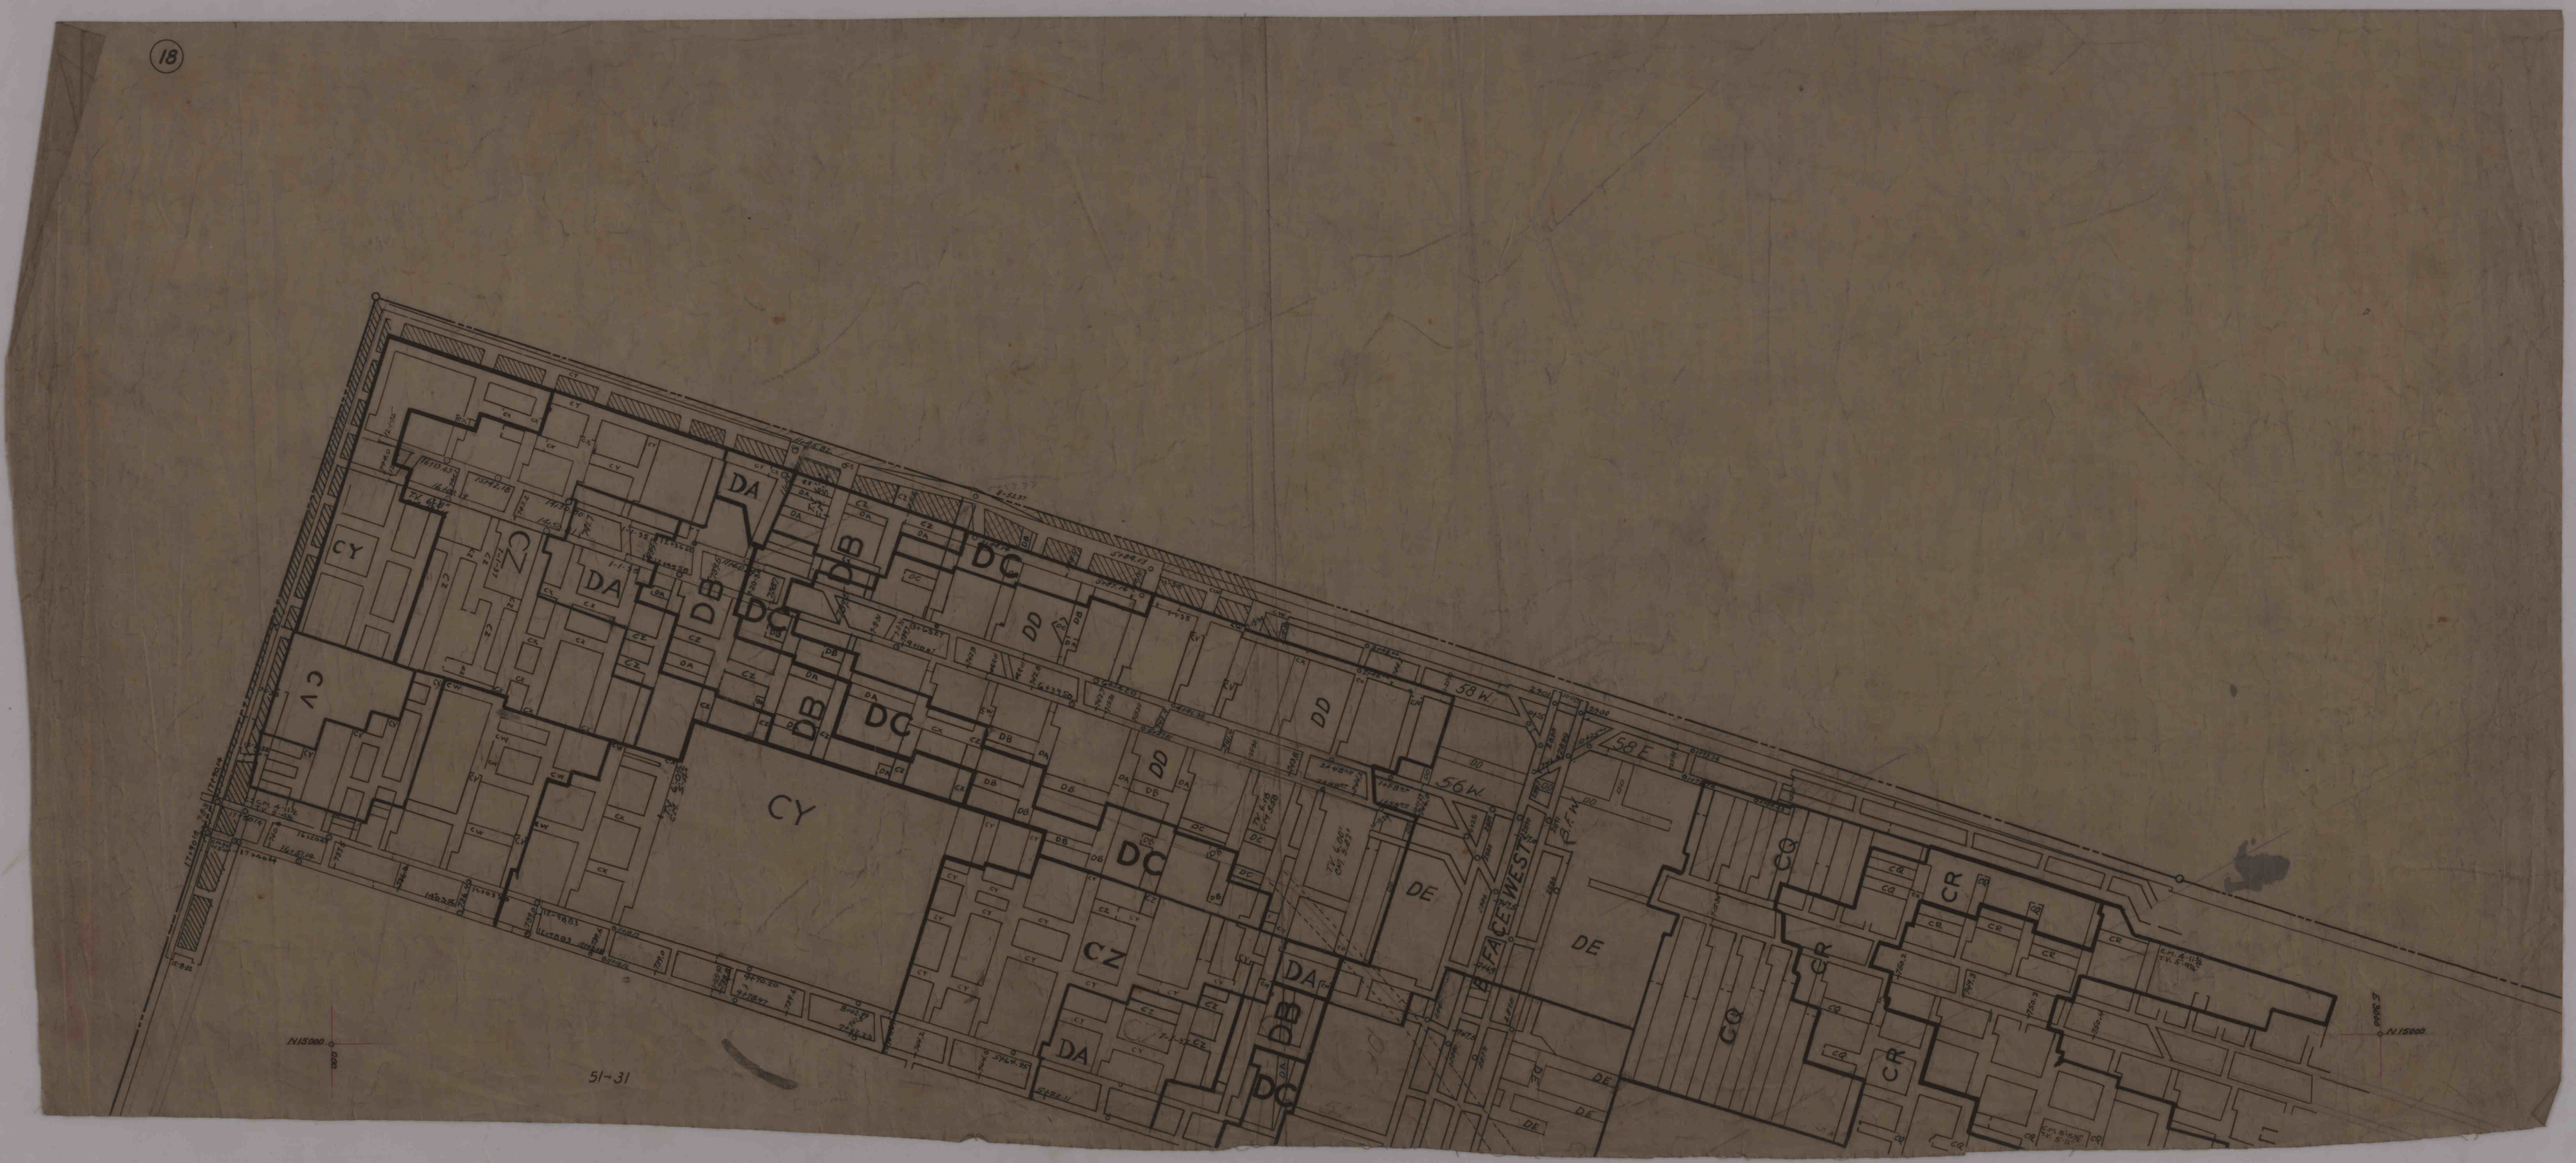
CY
CZ
DA
DB
DC
DD
DE
CQ
CR
58 W
58 E
56 W
N 15000
N 15000
51-31