


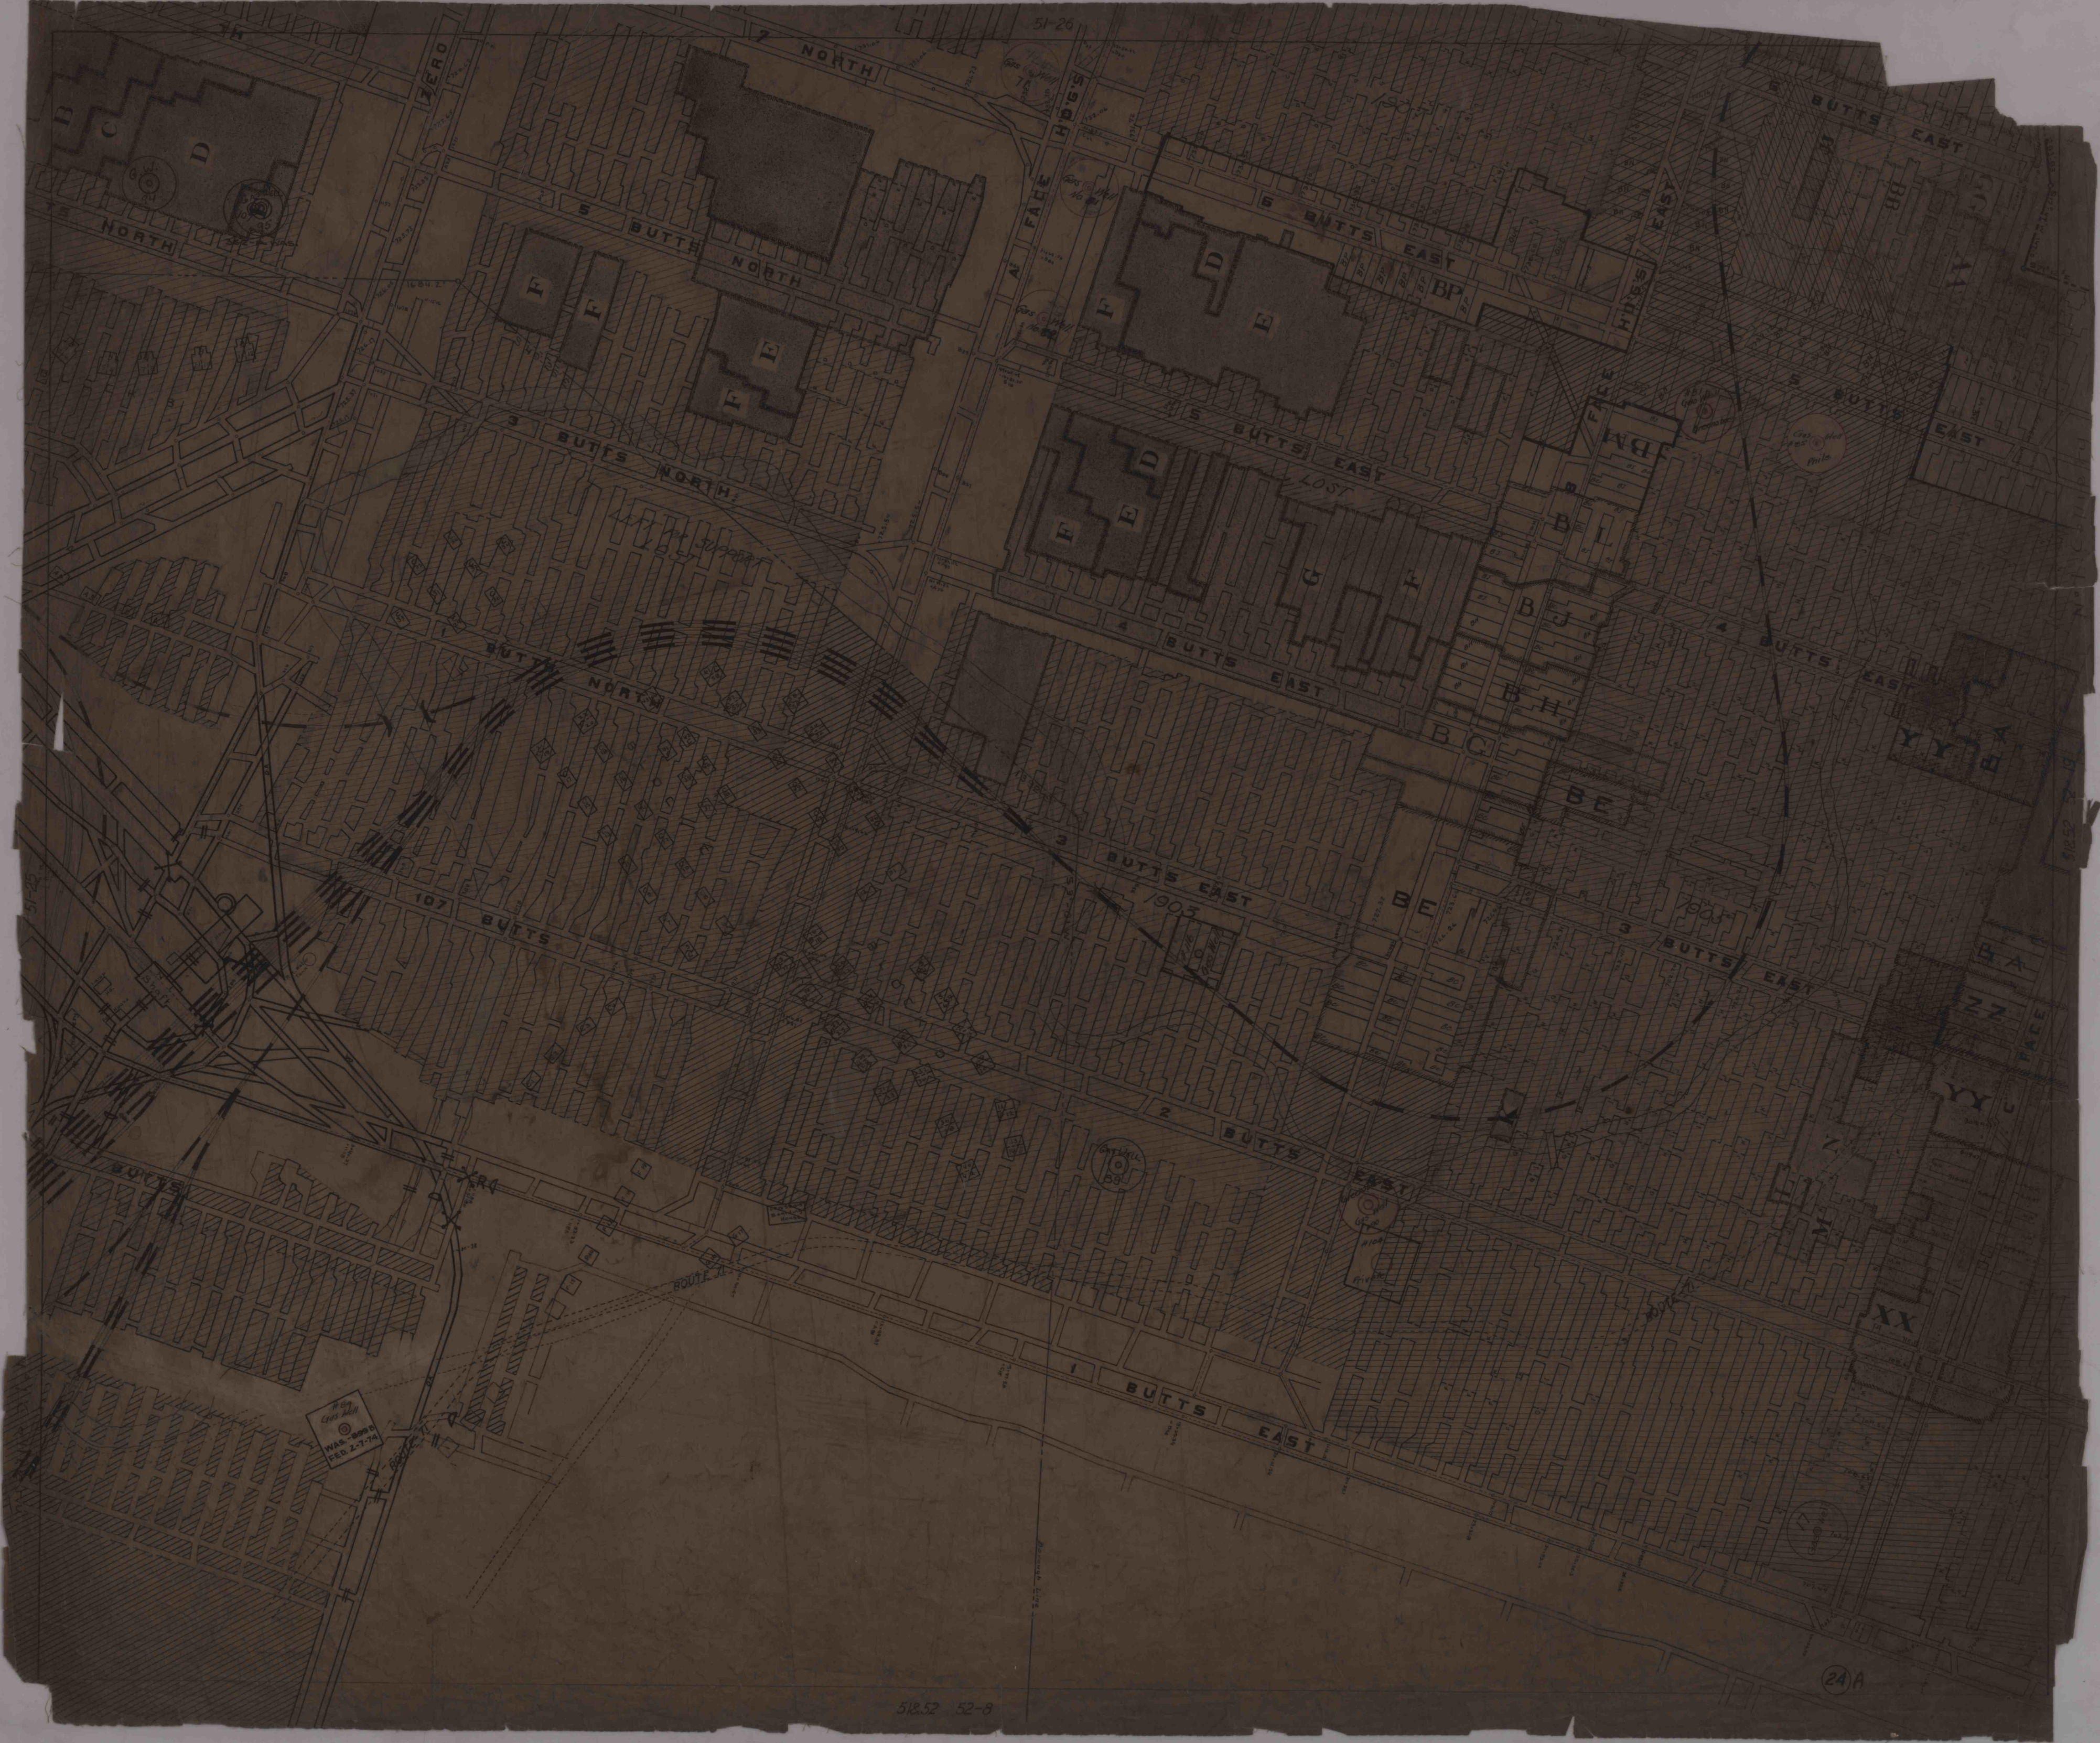

WAB 2000
FEB 2-7-74