


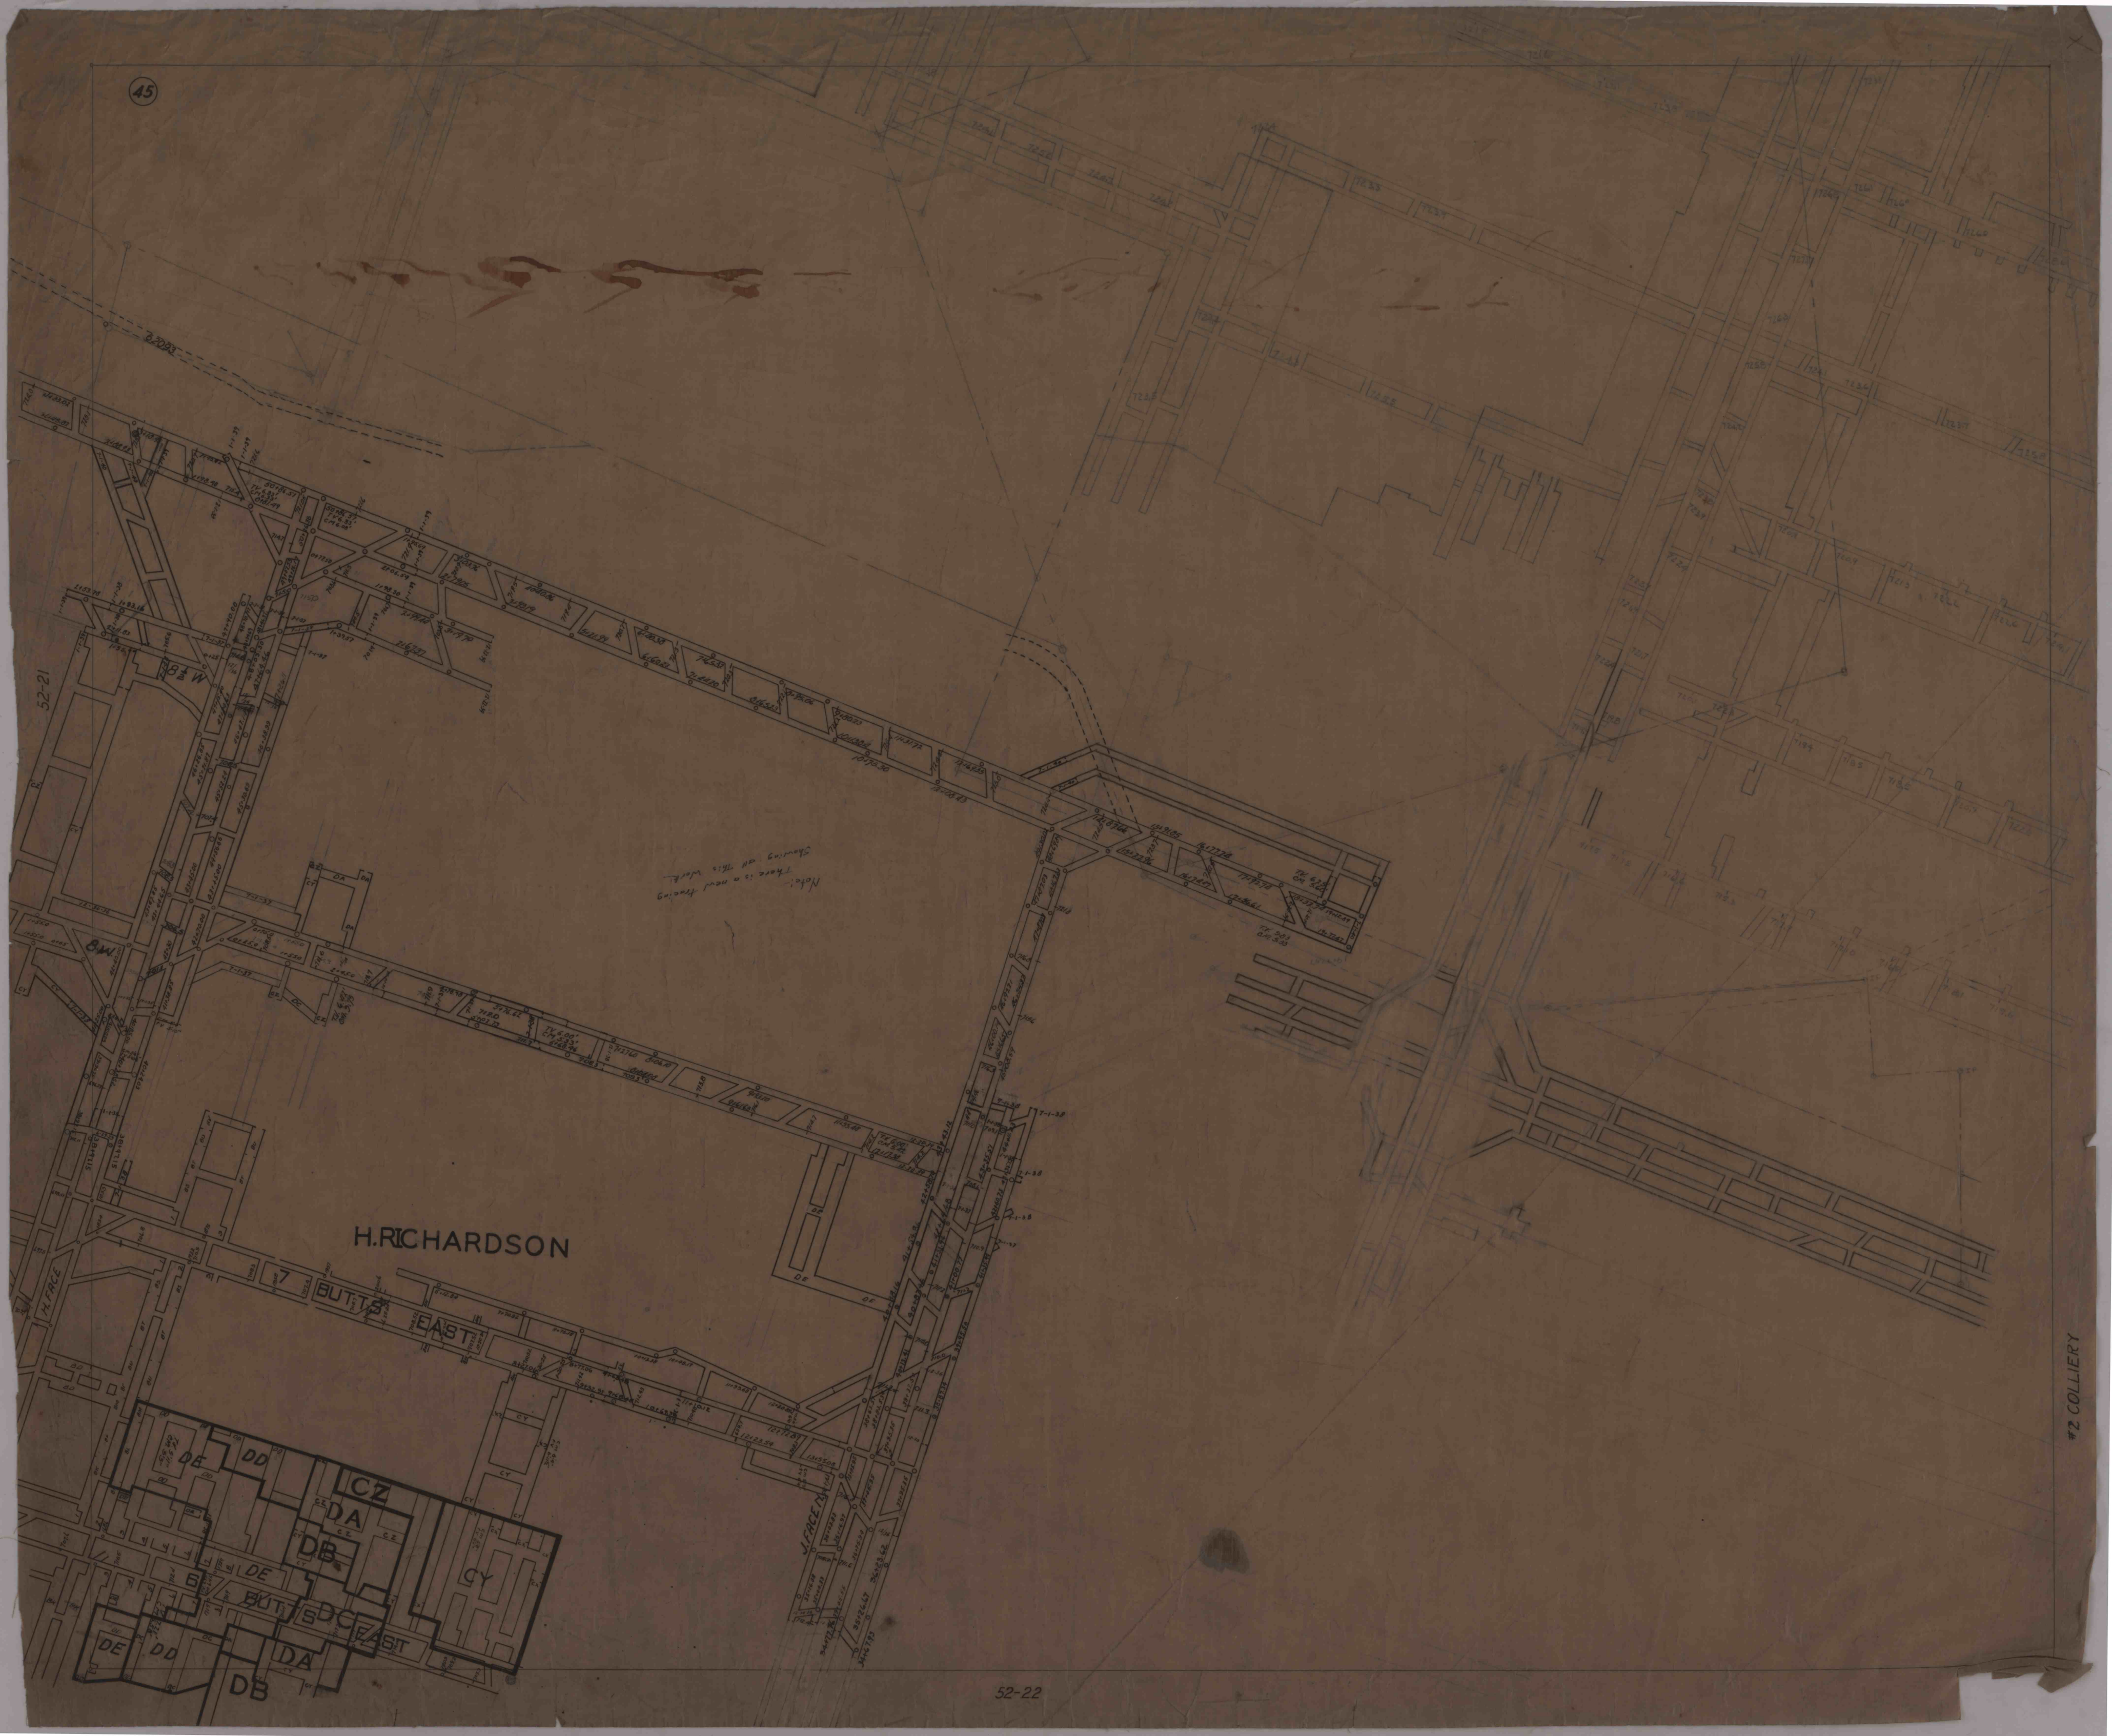

Note:
There is a new tracing
showing on this work.

H. RICHARDSON




