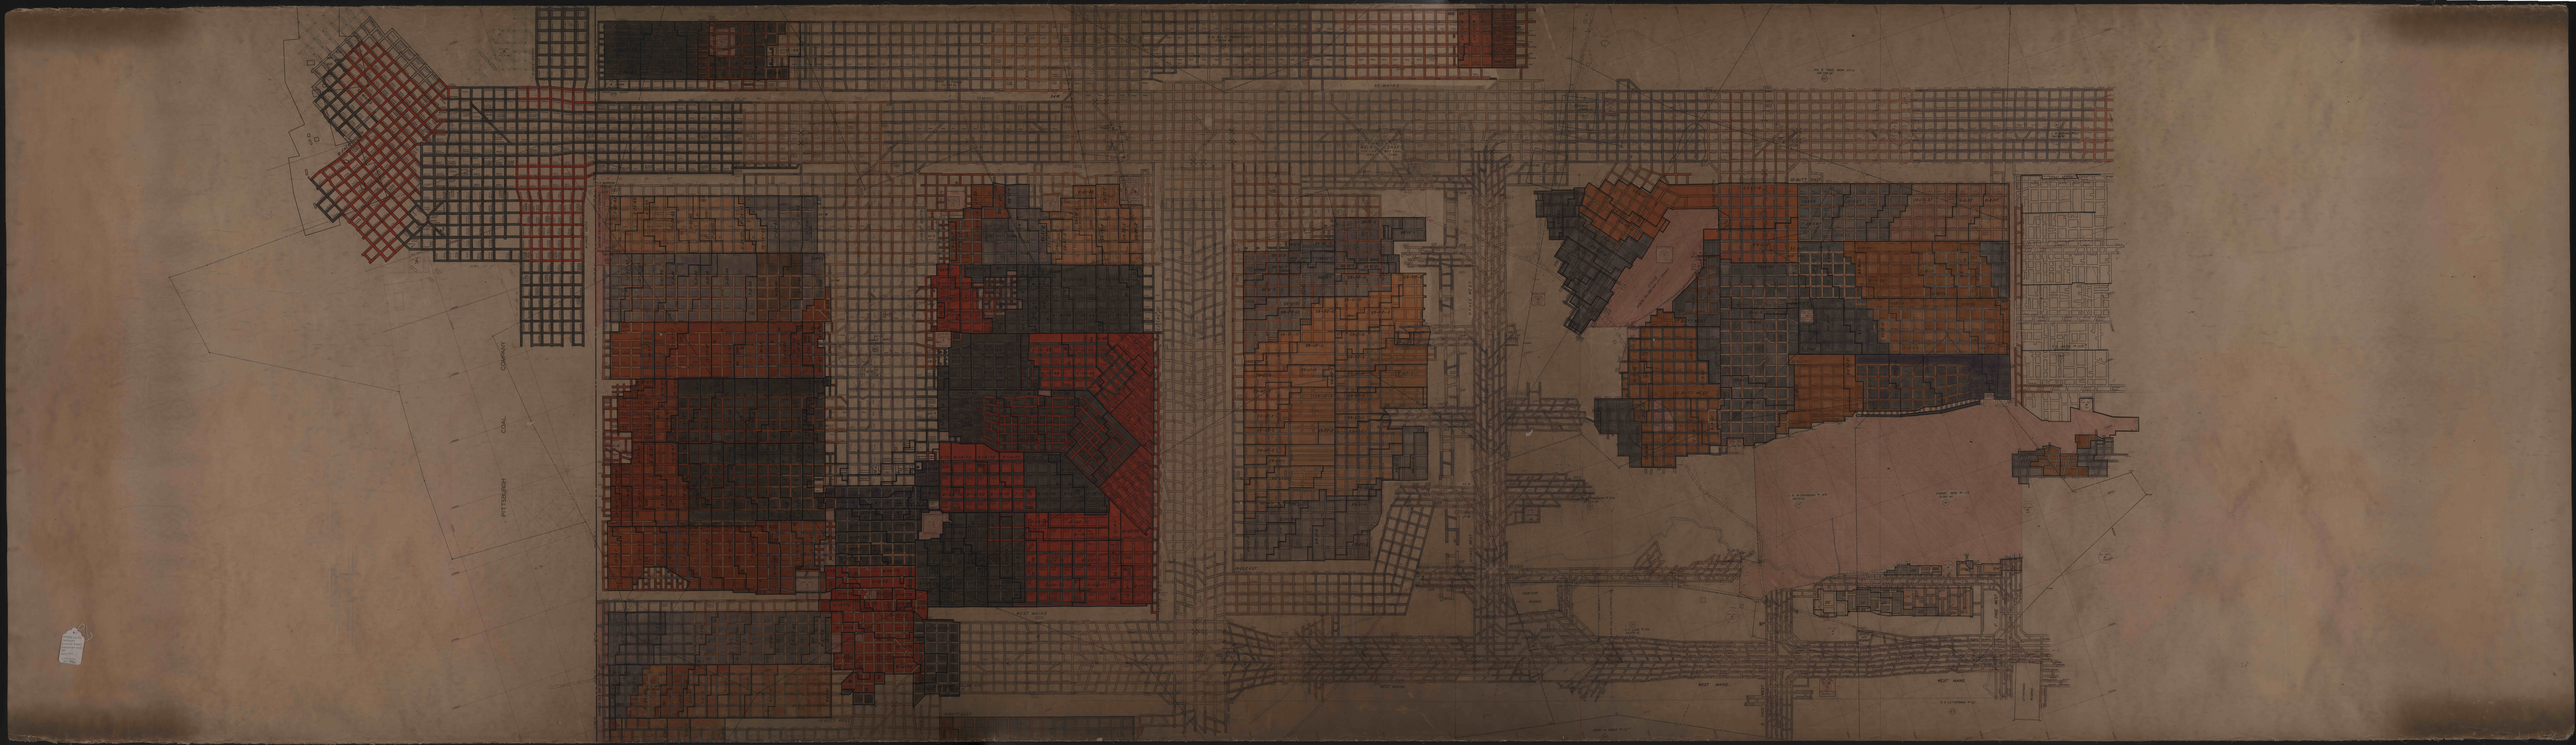
PITTSBURGH COAL COMPANY
WEST MAIN
WEST MAIN
WEST MAIN
WEST MAIN