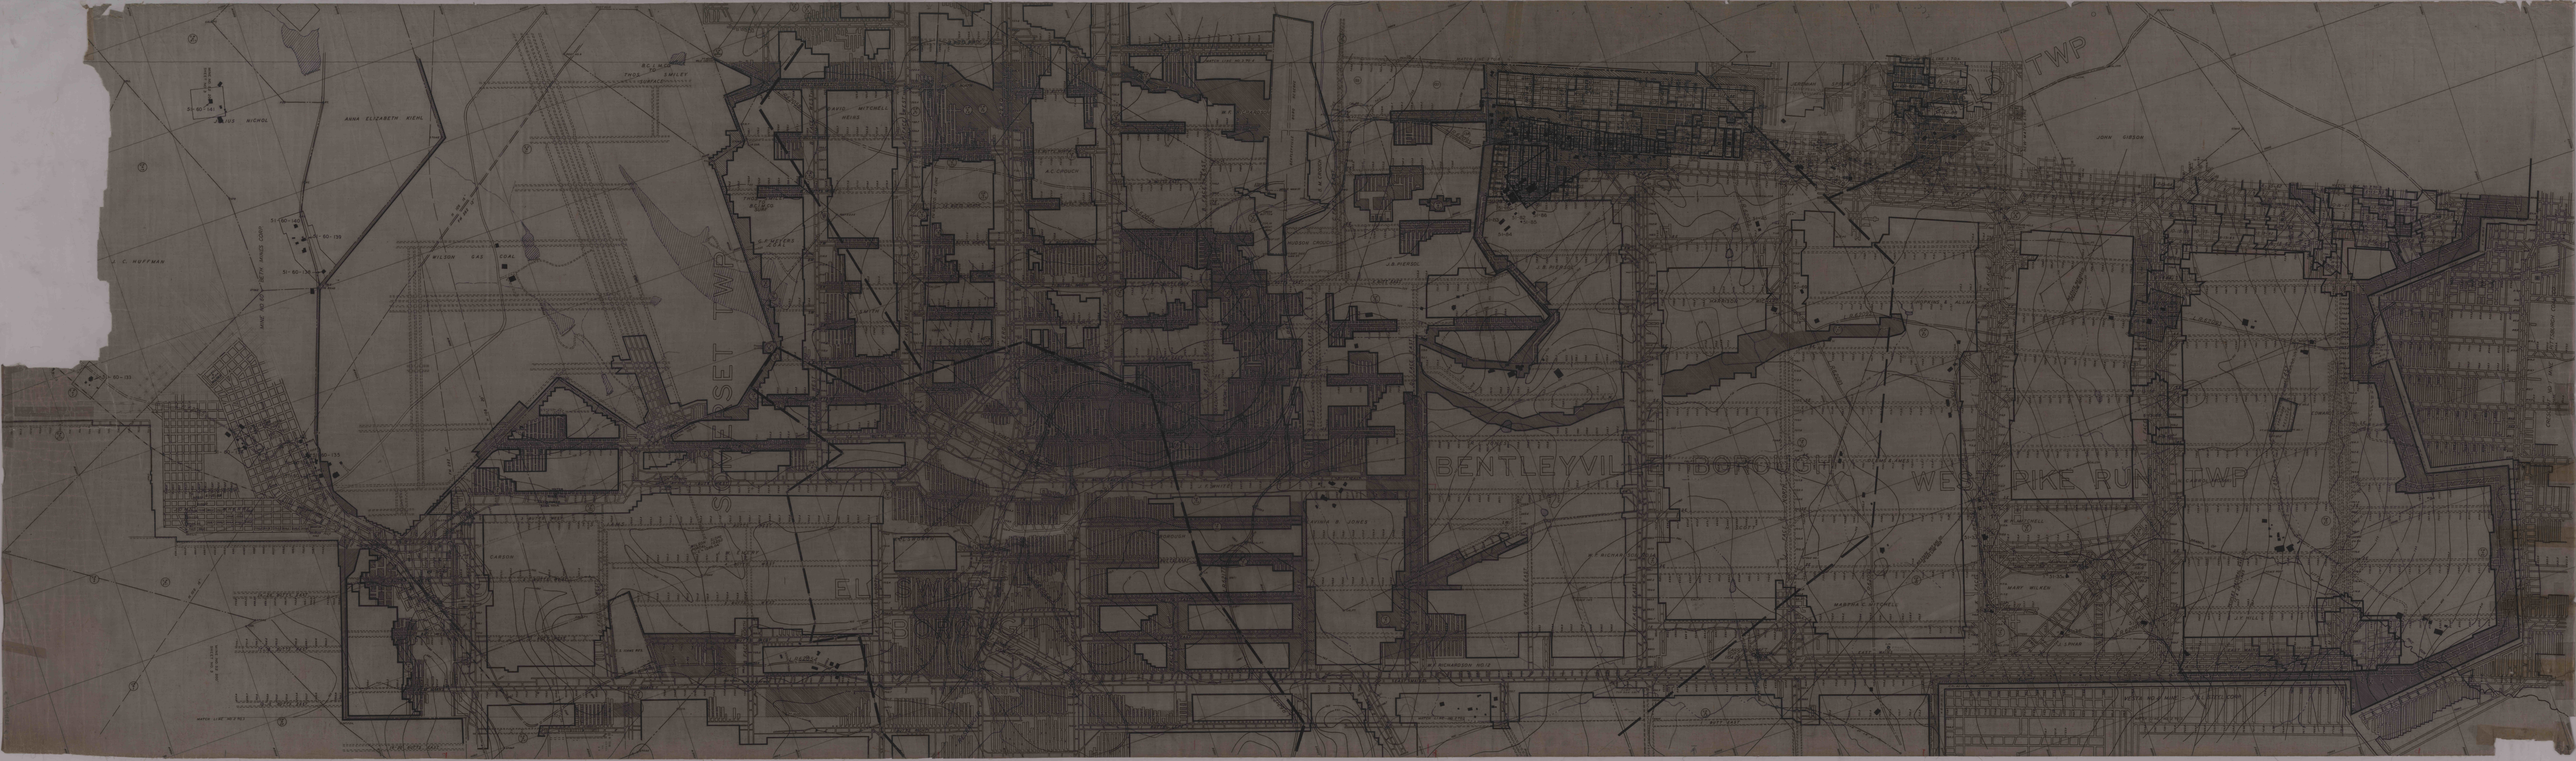
TWP
JOHN GIBSON
ANNA ELIZABETH KIEHL
C. HUFFMAN
WILSON GAS COAL
SET TWP
BENTLEYVILLE BOROUGH
WEST PIKE RUN TWP
CARSON
MARY WILKEN