


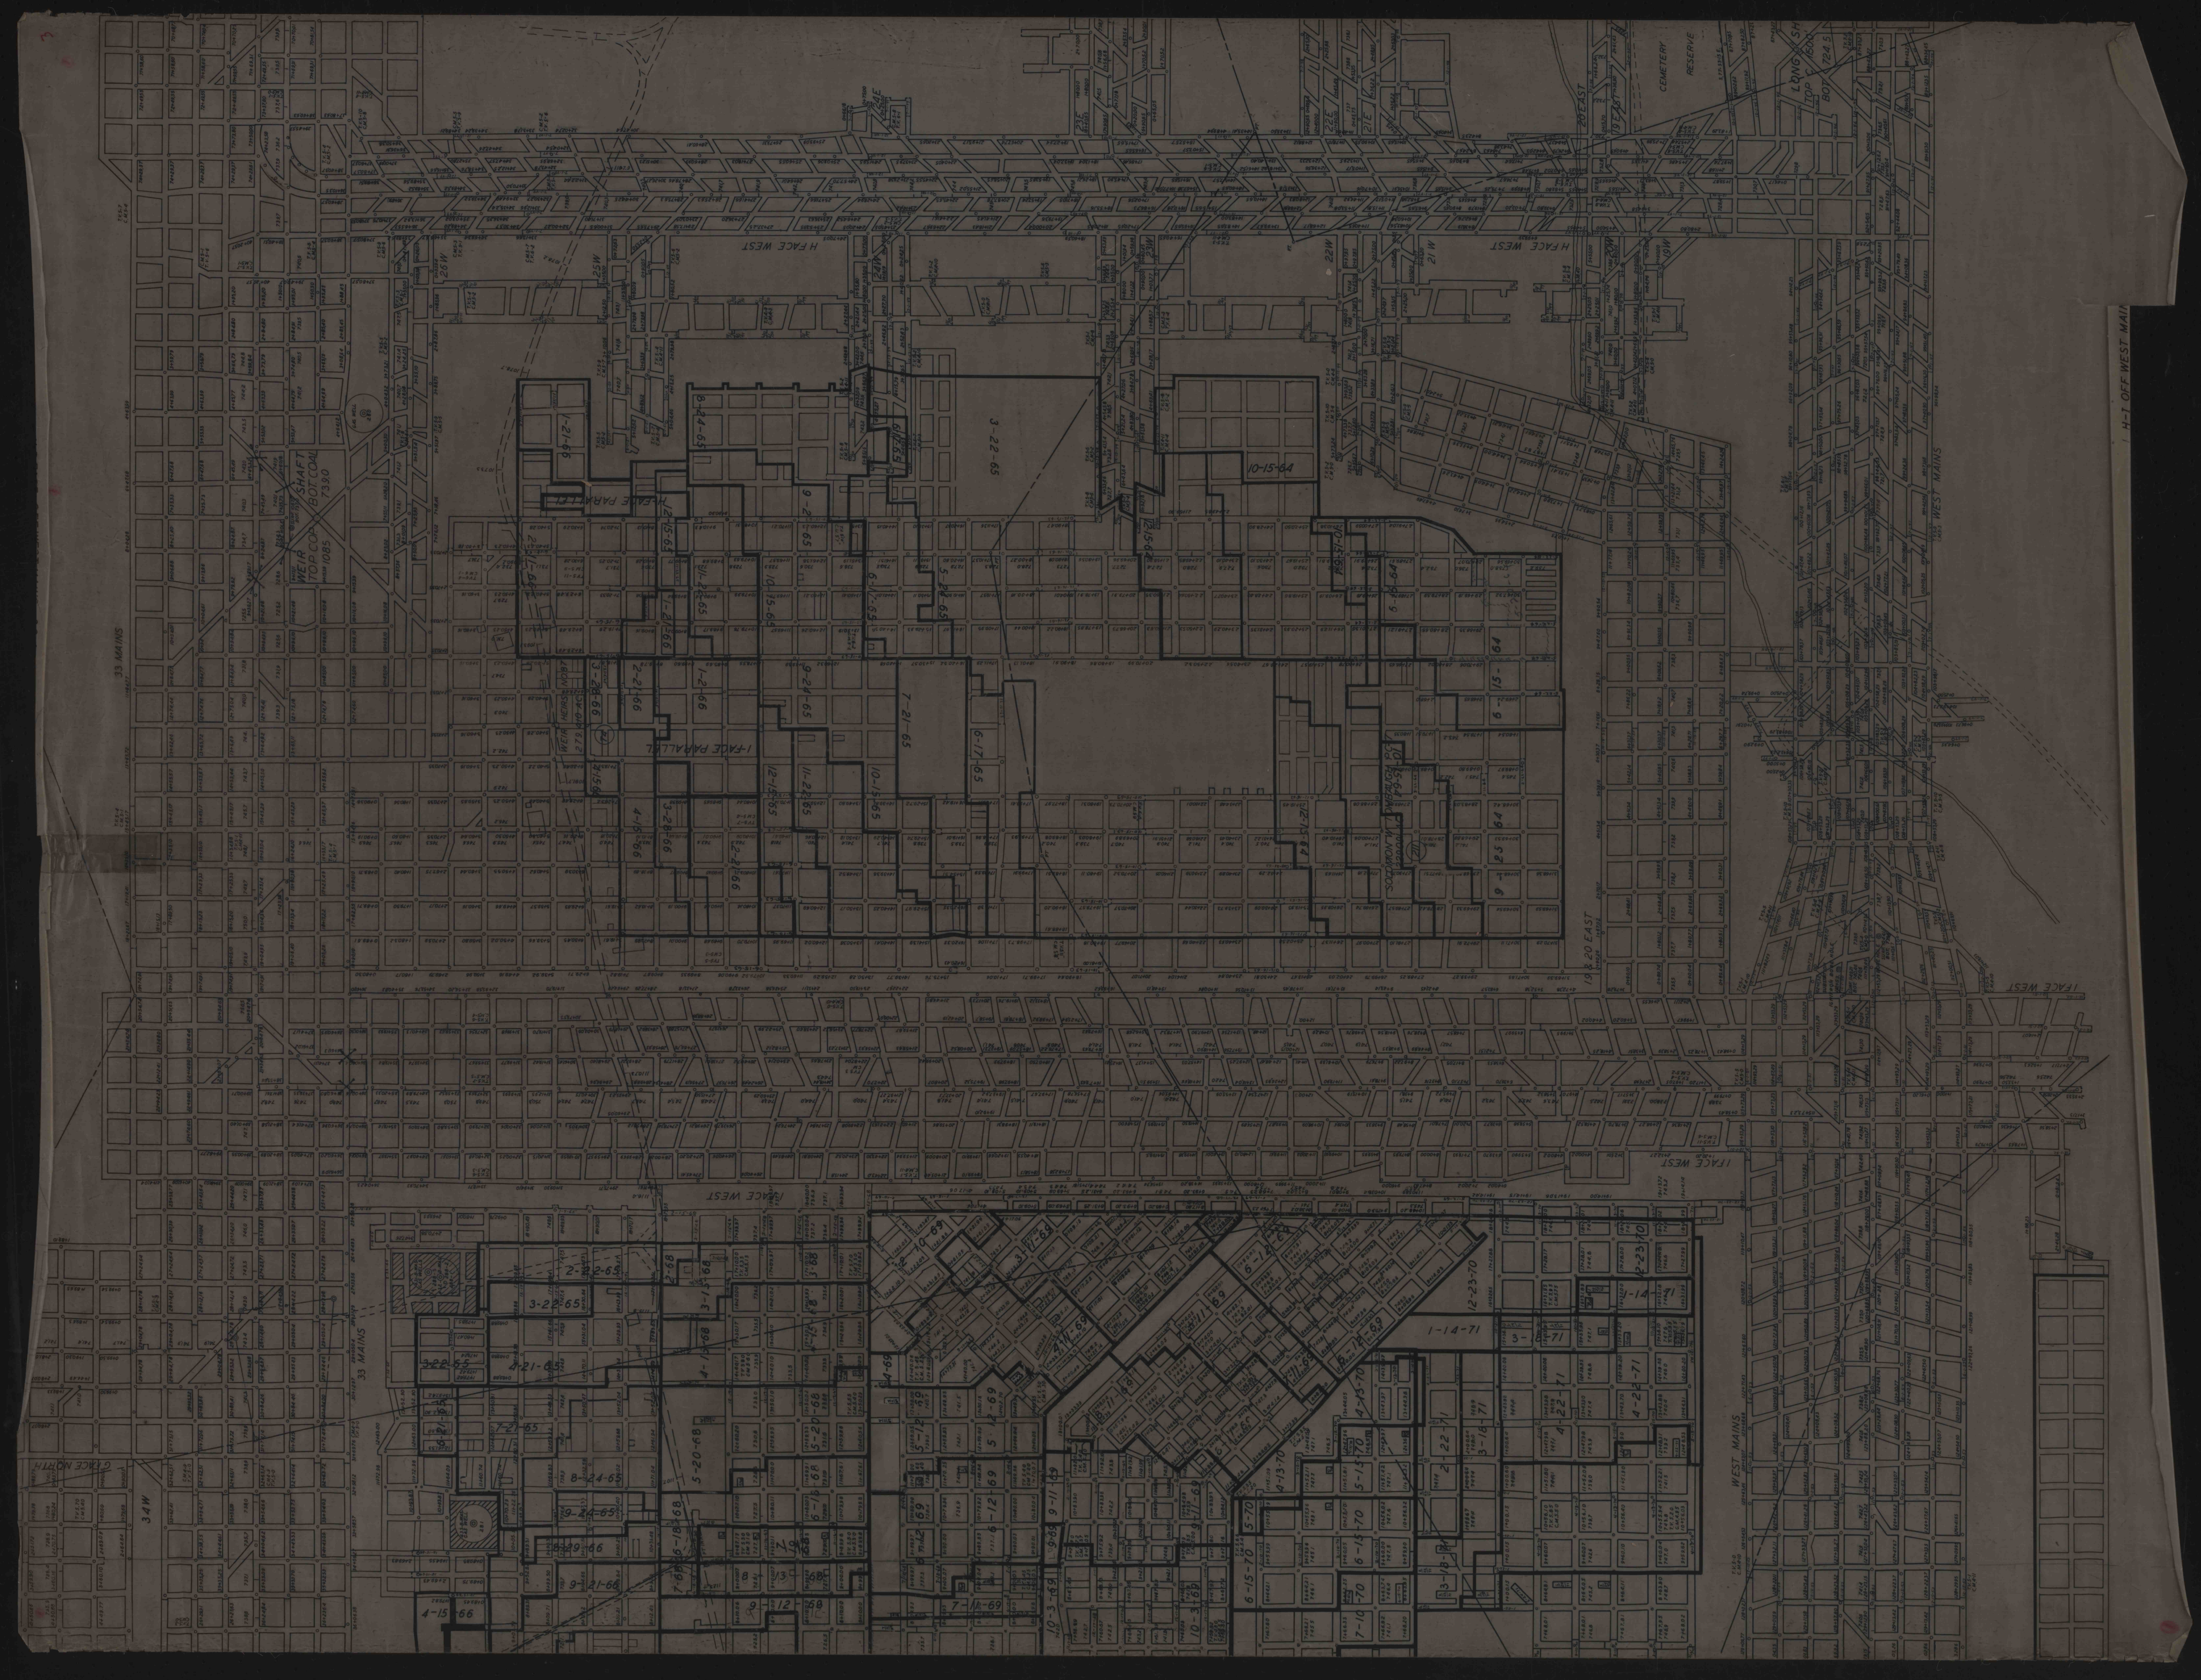

H-1 OFF WEST MAIN