


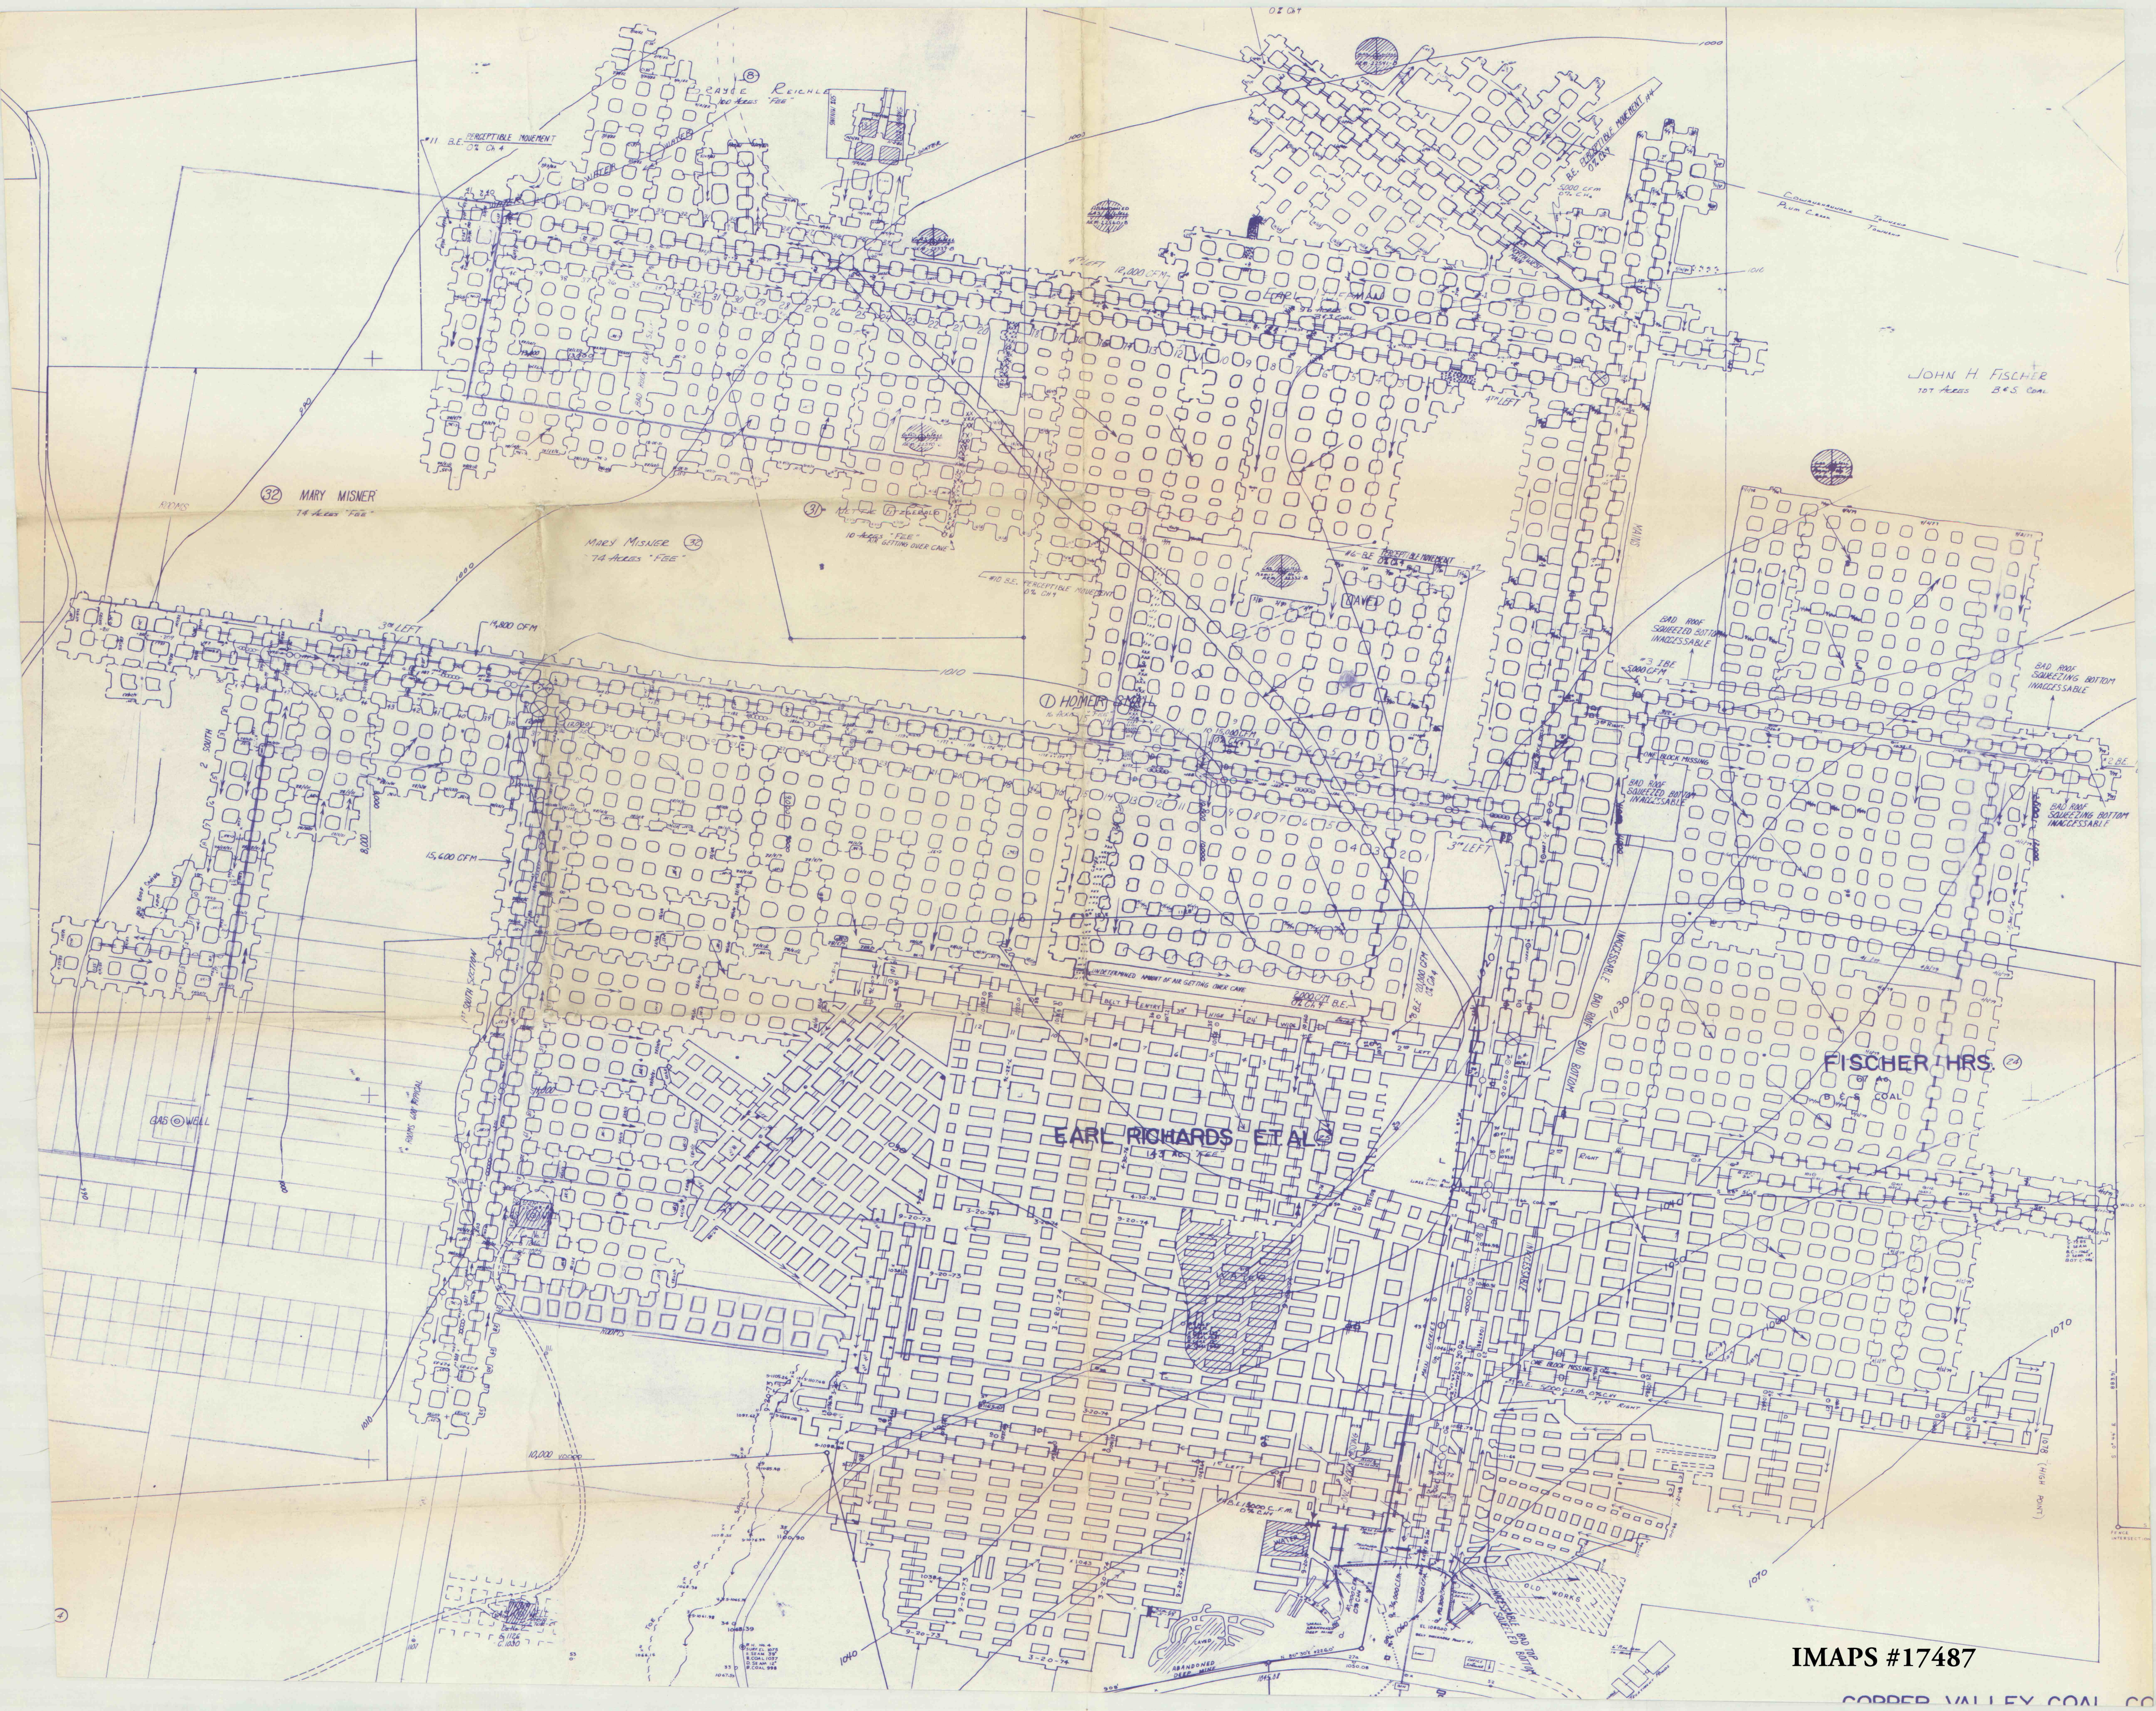

JOHN H FISCHER
107 ACRES B&S COAL

32 MARY MISNER
74 ACRES \"FEE\"

MARY MISNER 32
74 ACRES \"FEE\"

31
10 ACRES \"FEE\"
AIR GETTING OVER CAVE

1 HOMER SMITH
16 ACRES \"FEE\"

EARL RICHARDS ET AL
13.7 ACRES \"FEE\"

FISCHER HRS 24
OF B&S COAL