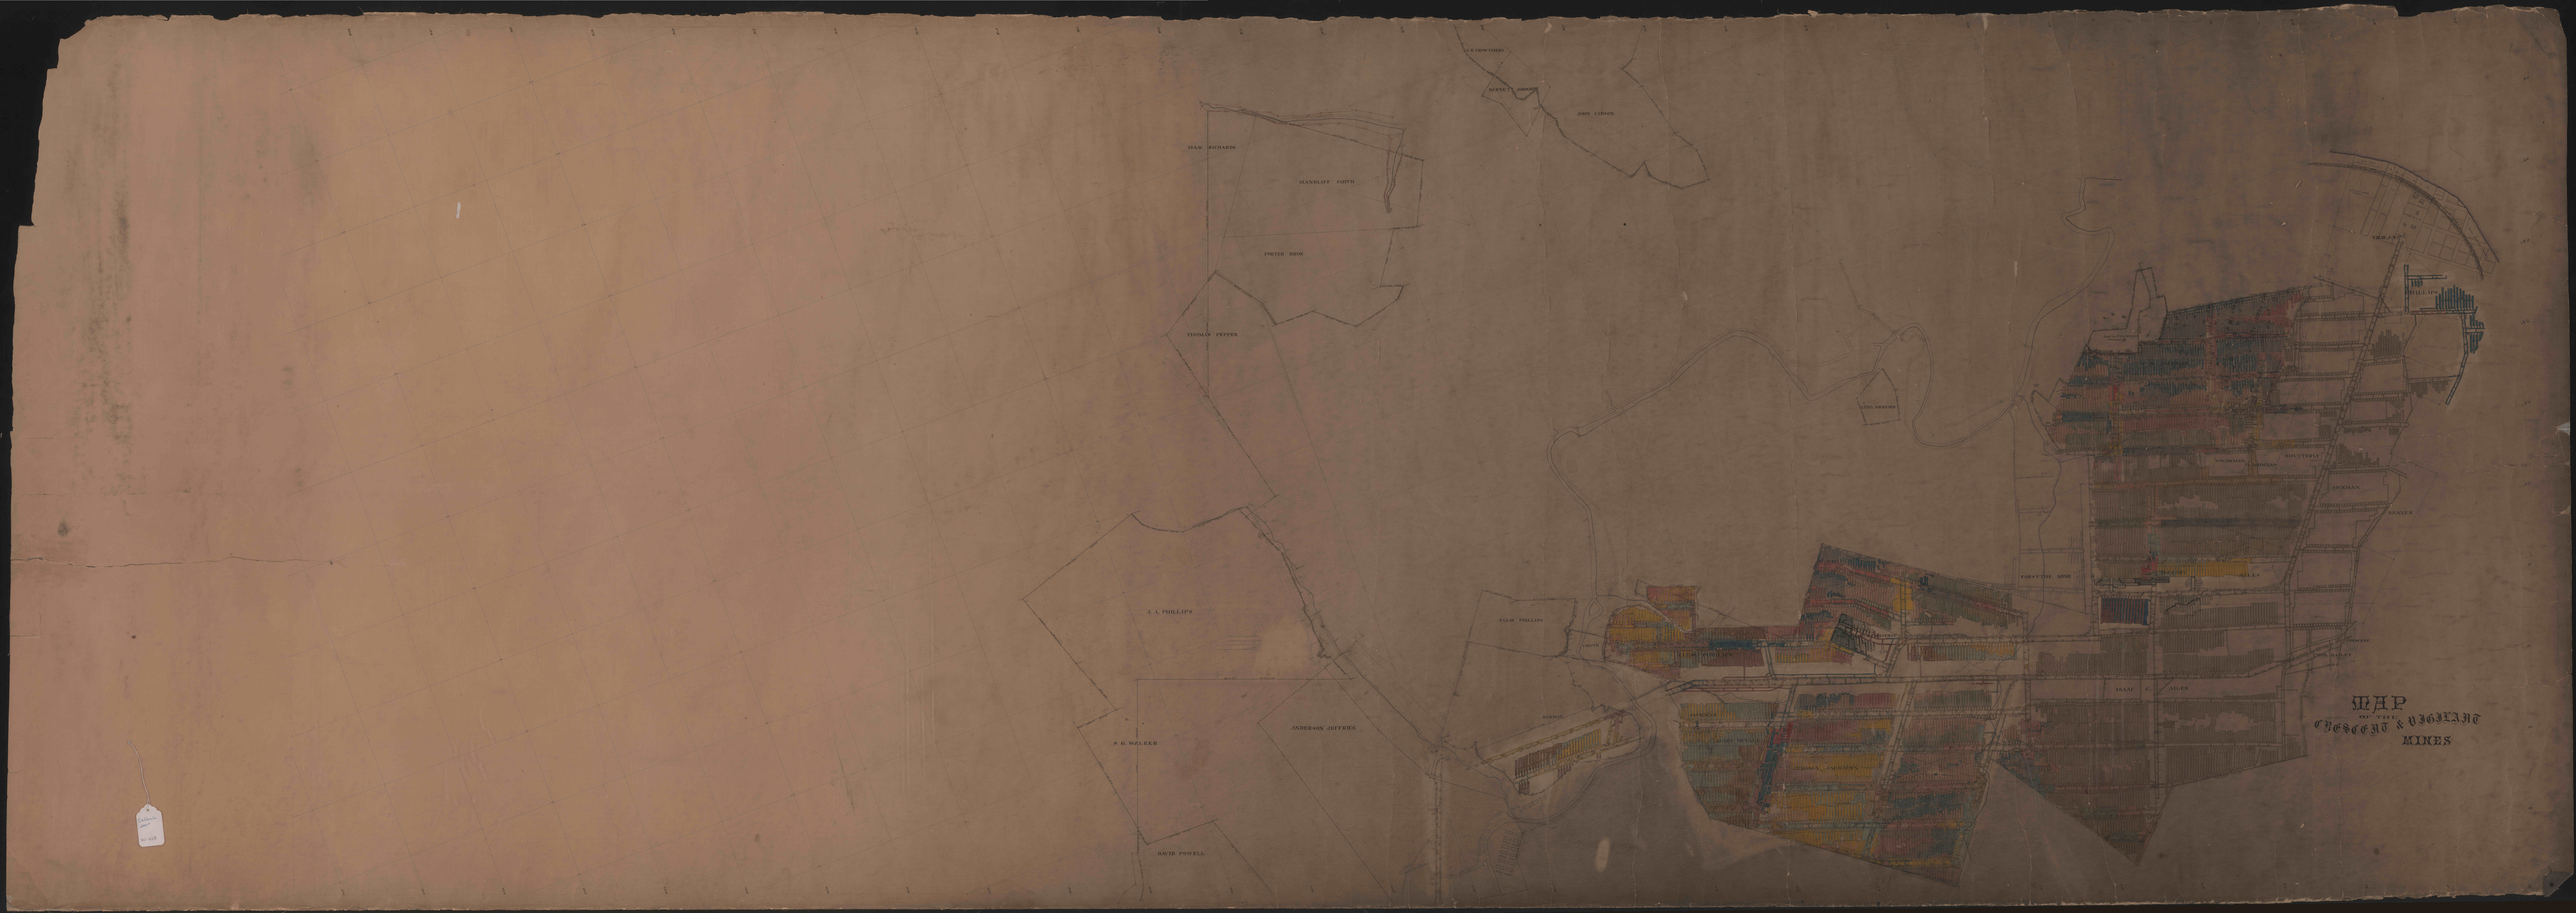
MAP
OF THE
CRESCENT & VIGILANT
MINES
A. S. CROWTHER
SORAH T. JONES
JOHN CORNIX
ISAAC RICHARDS
MANDLIFF SMITH
PETER EBOS
THOMAS PEPPER
JOHN MORRIS
A. A. PHILLIPS
ELIAS PHILLIPS
ANDERSON JEFFRIES
S. C. WALKER
DAVID POWELL
CRESCENT
VIGILANT
PRIMITIVE MINE
ISAAC C. ATLEE
SOUTHERN
HUNNAN
BLOWER
ATLEE
PHILLIPS
ATLEE