


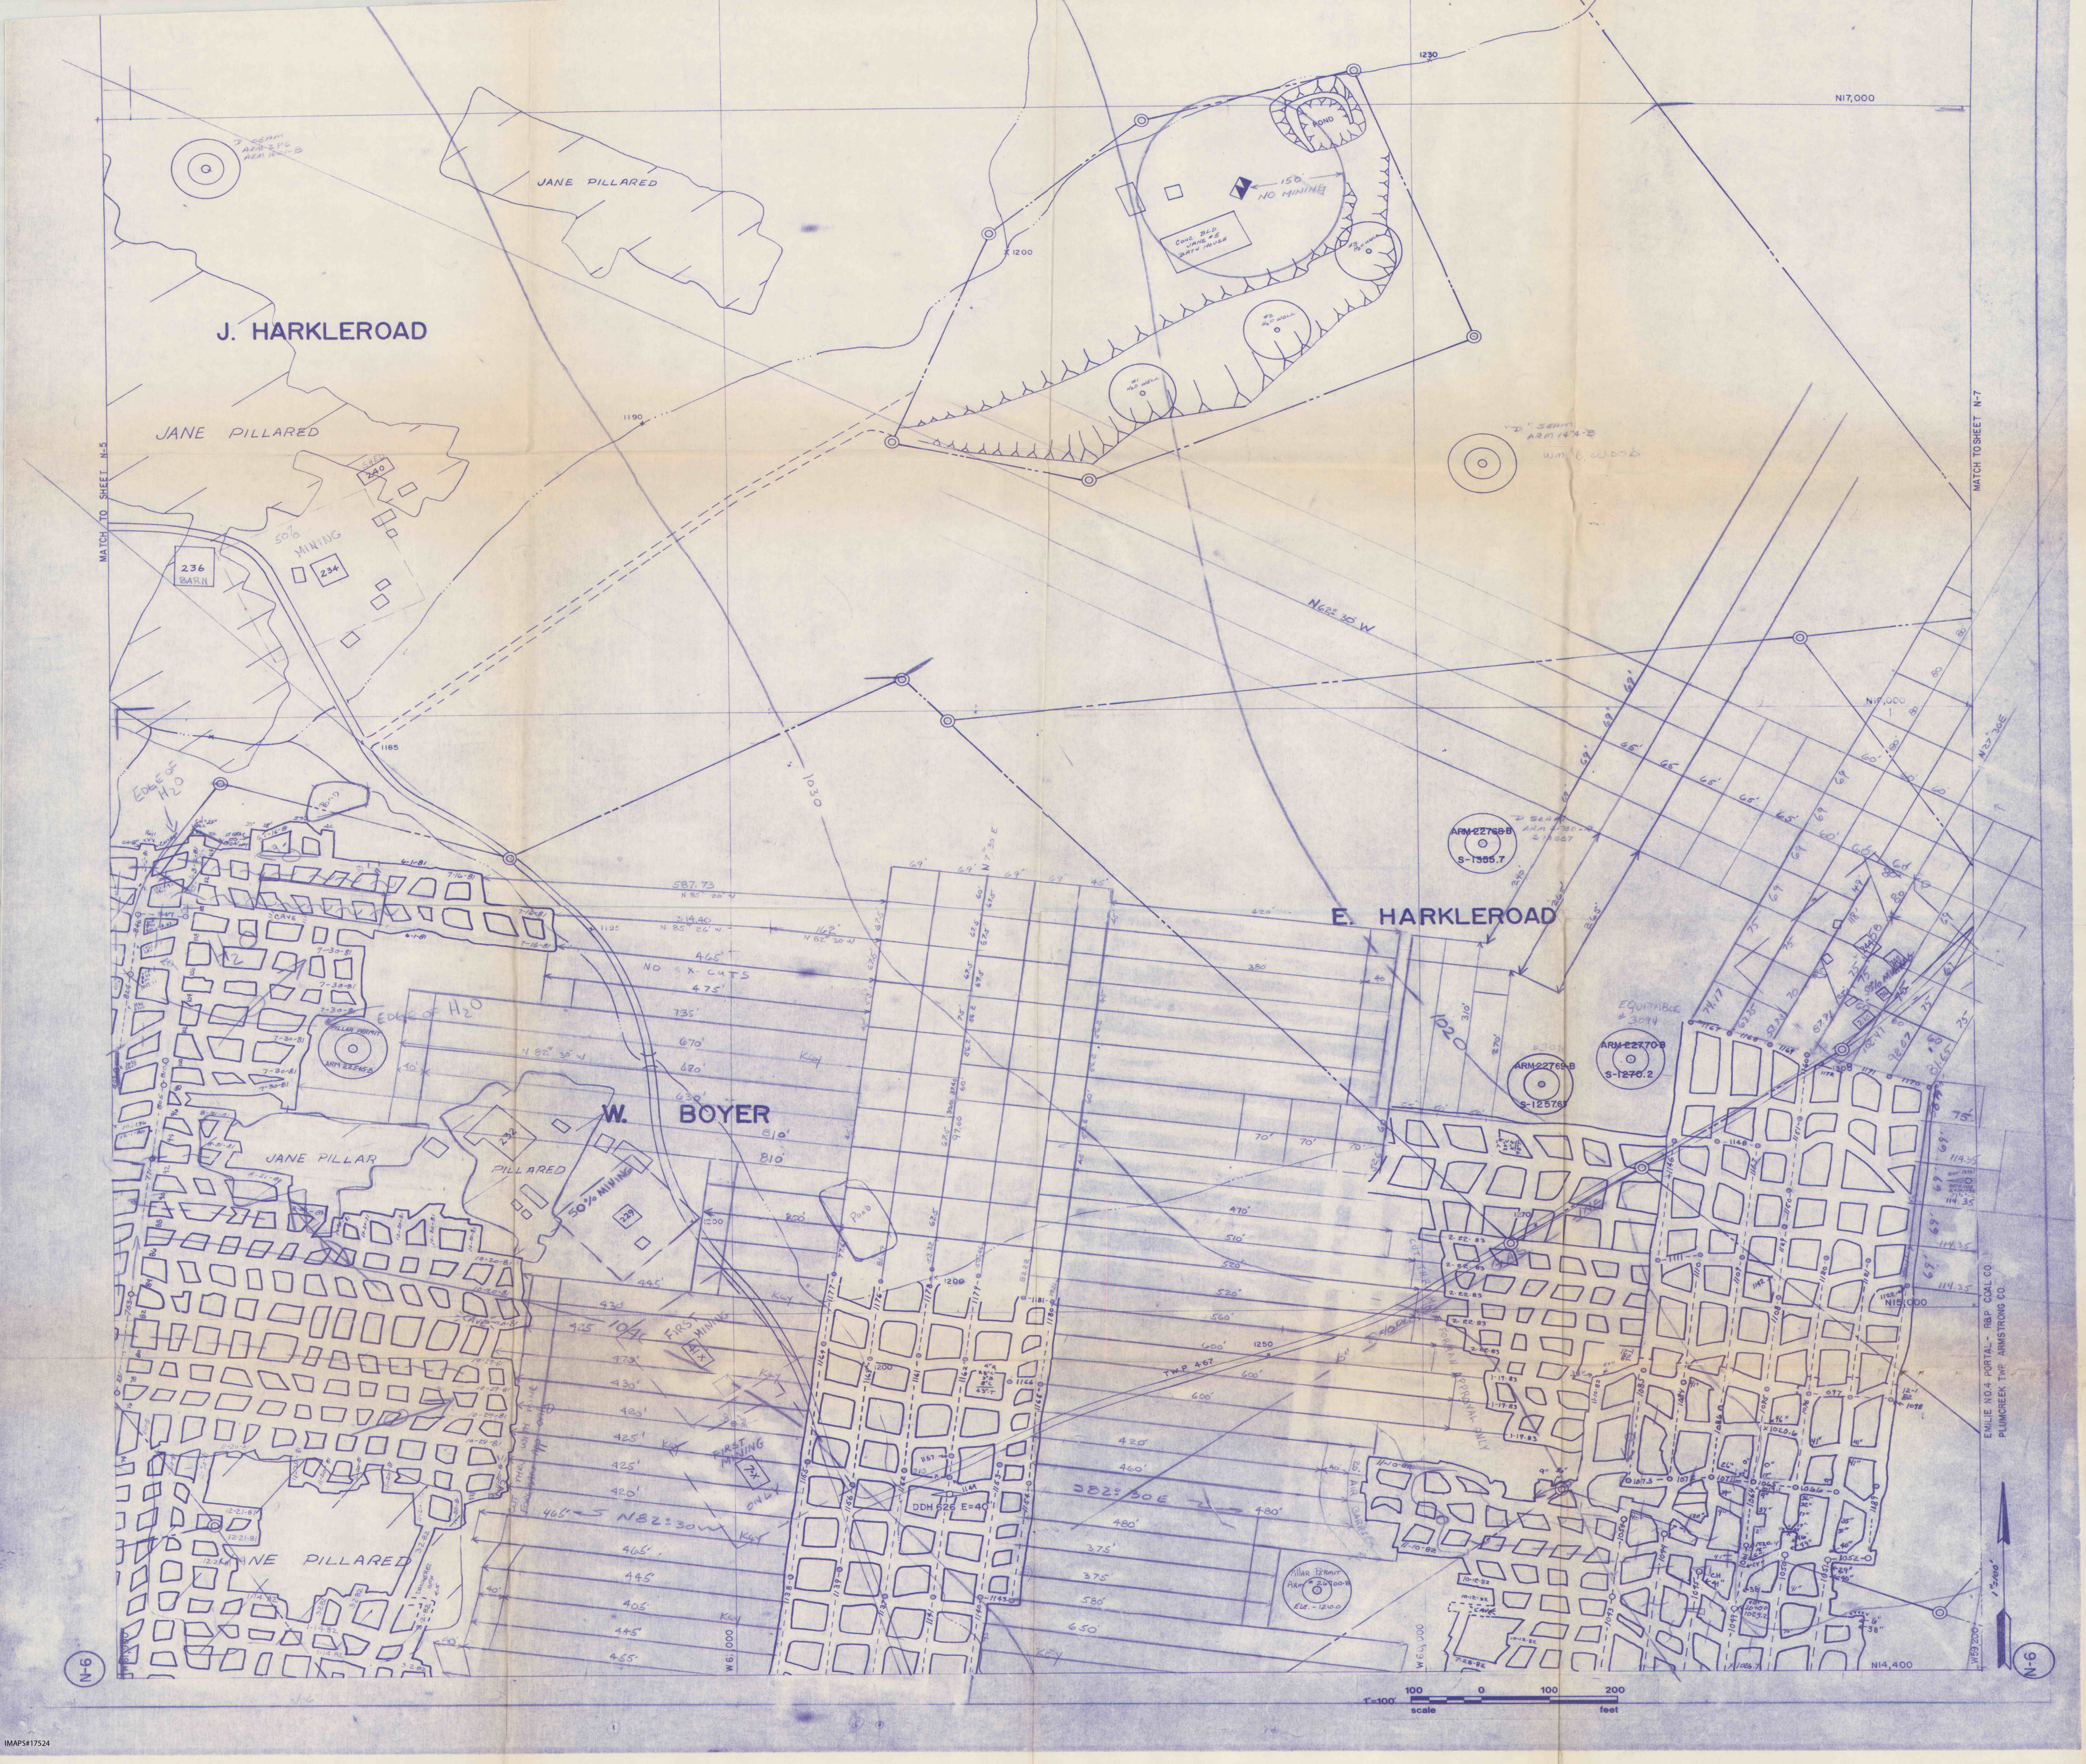

J. HARKLEROAD

JANE PILLARED

JANE PILLARED

E. HARKLEROAD

W. BOYER

JANE PILLAR

PILLARED

JANE PILLARED

1"=100' scale 0 100 200 feet

EMILIE NO. 4 PORTAL - RRP COAL CO.
PLUMCREEK TWP. ARMSTRONG CO.