


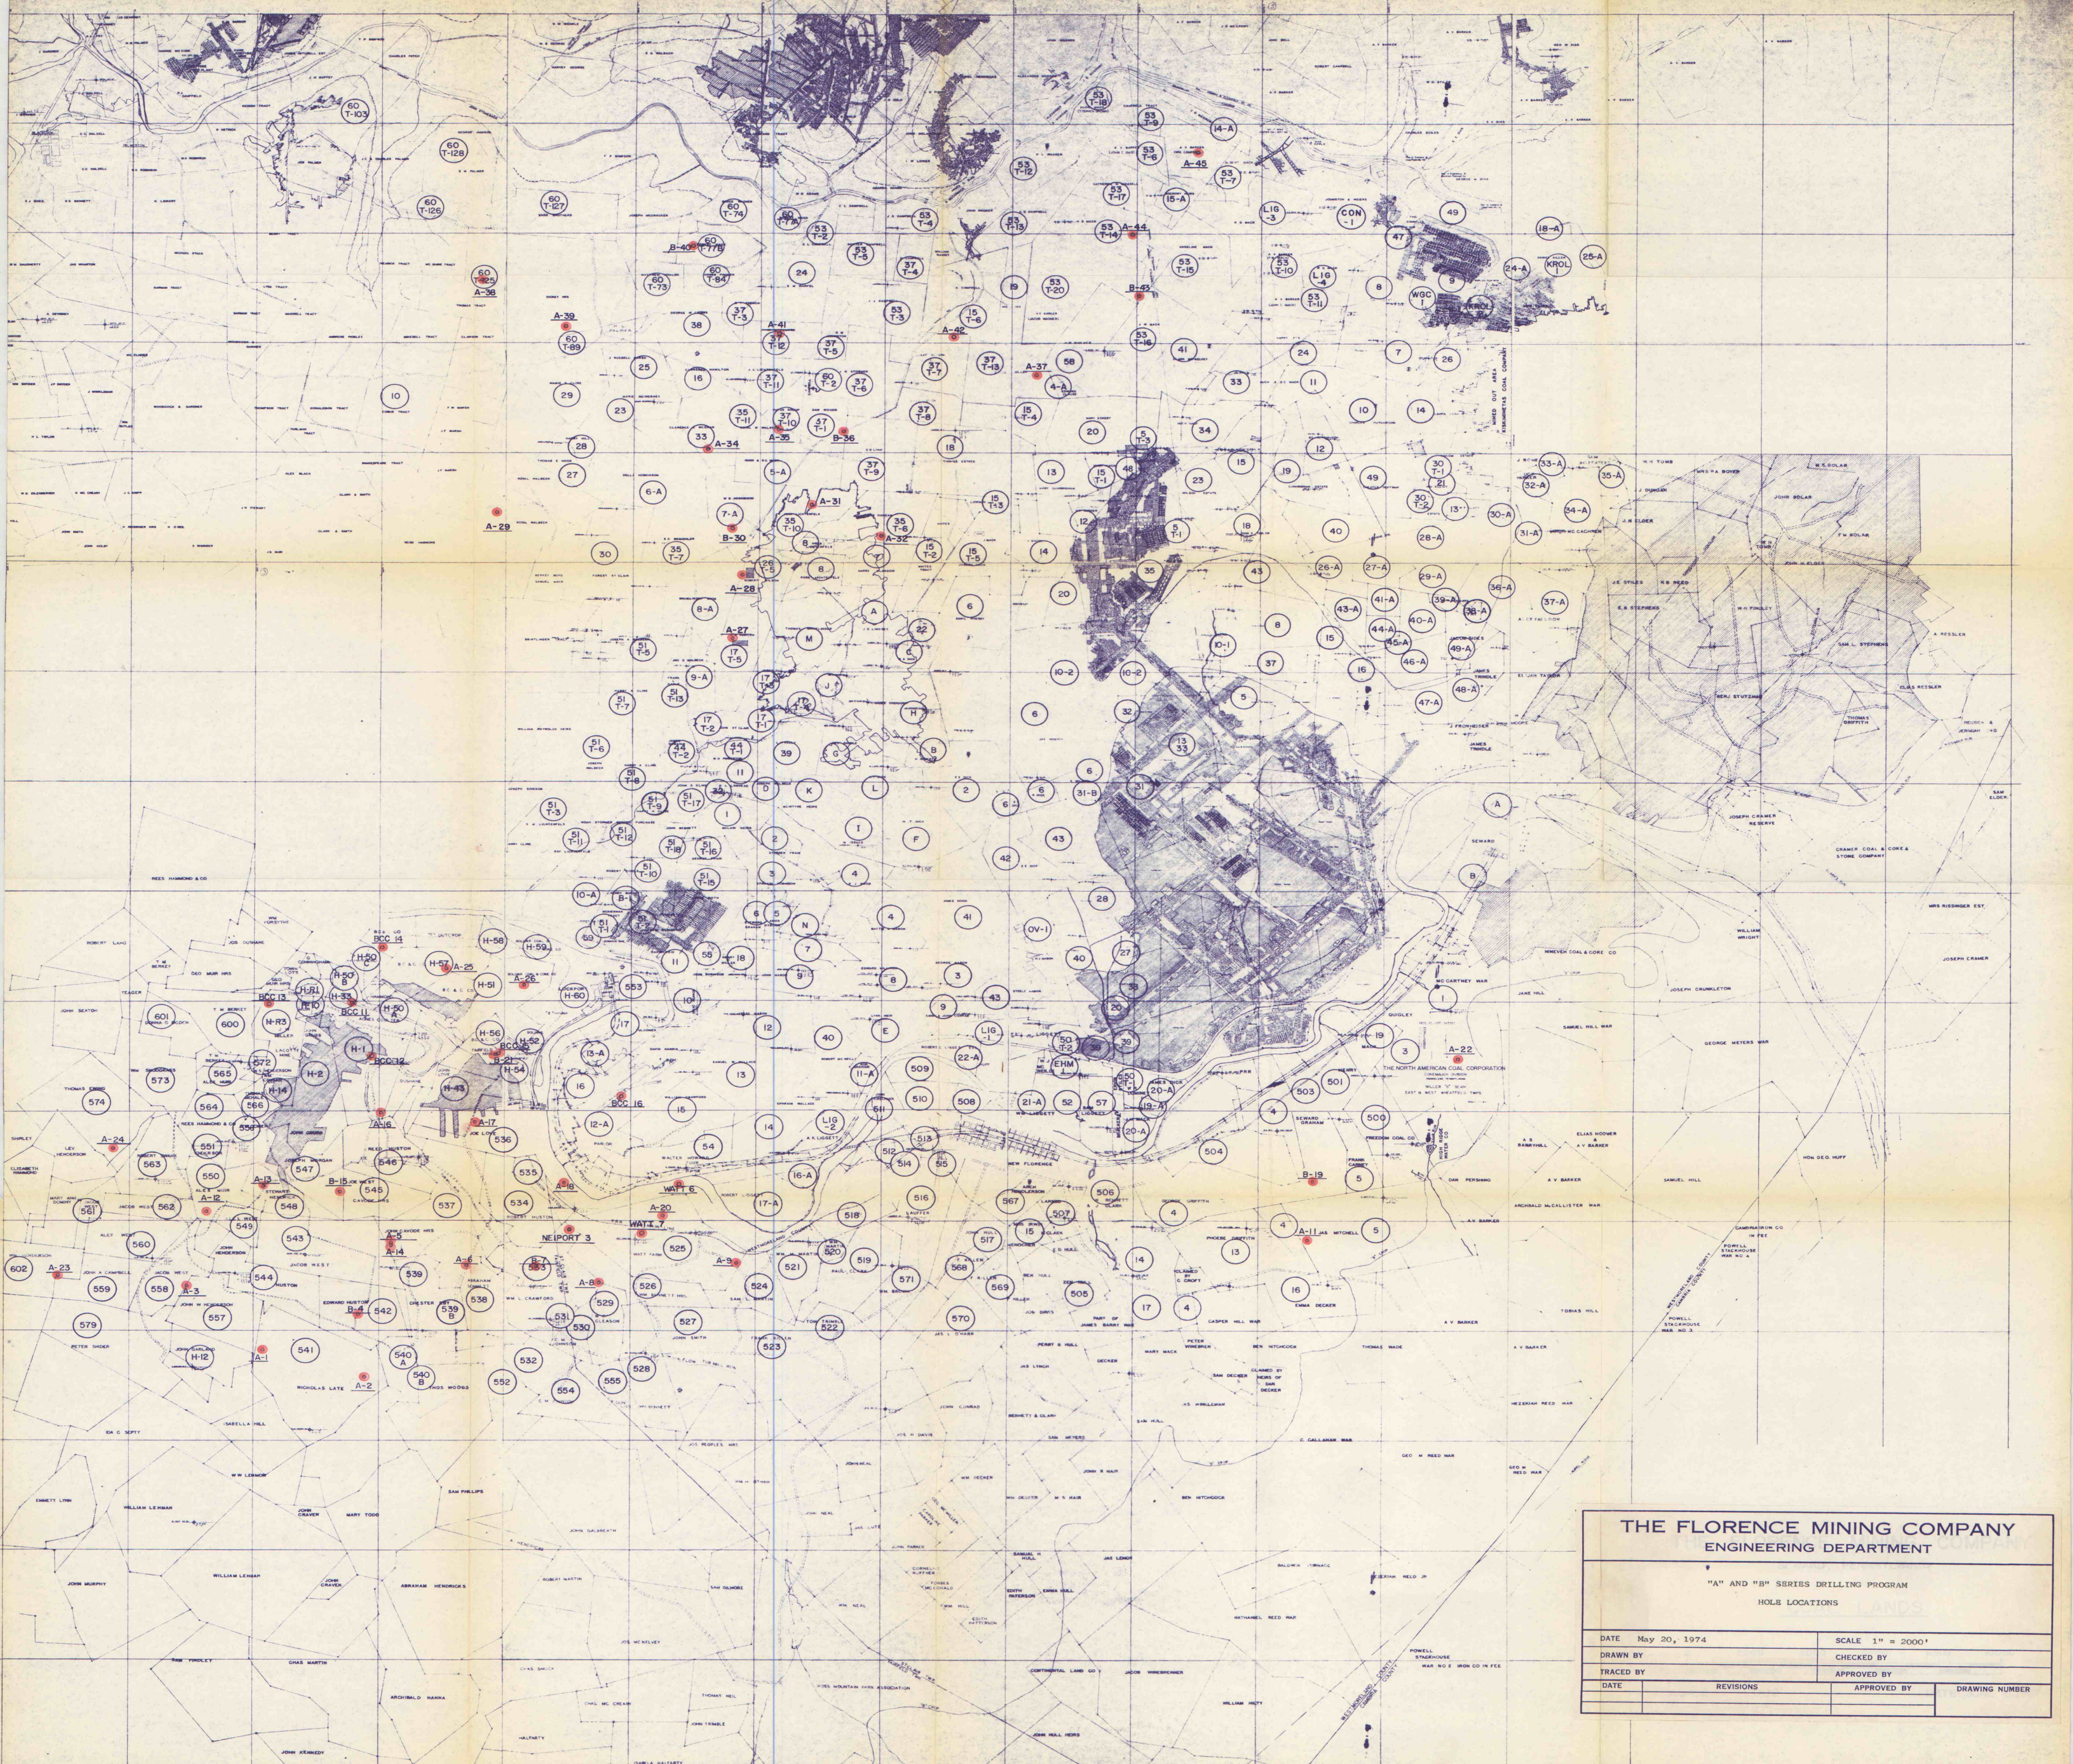

THE FLORENCE MINING COMPANY ENGINEERING DEPARTMENT			
"A" AND "B" SERIES DRILLING PROGRAM HOLE LOCATIONS			
DATE	May 20, 1974	SCALE	1" = 2000'
DRAWN BY		CHECKED BY	
TRACED BY		APPROVED BY	
DATE		REVISIONS	
		APPROVED BY	DRAWING NUMBER