


UPPER FREEPORT (E) SEAM
RAW (R.O.M.) SULFUR % (MINEABLE SEAM)
MAP 8 REVISED

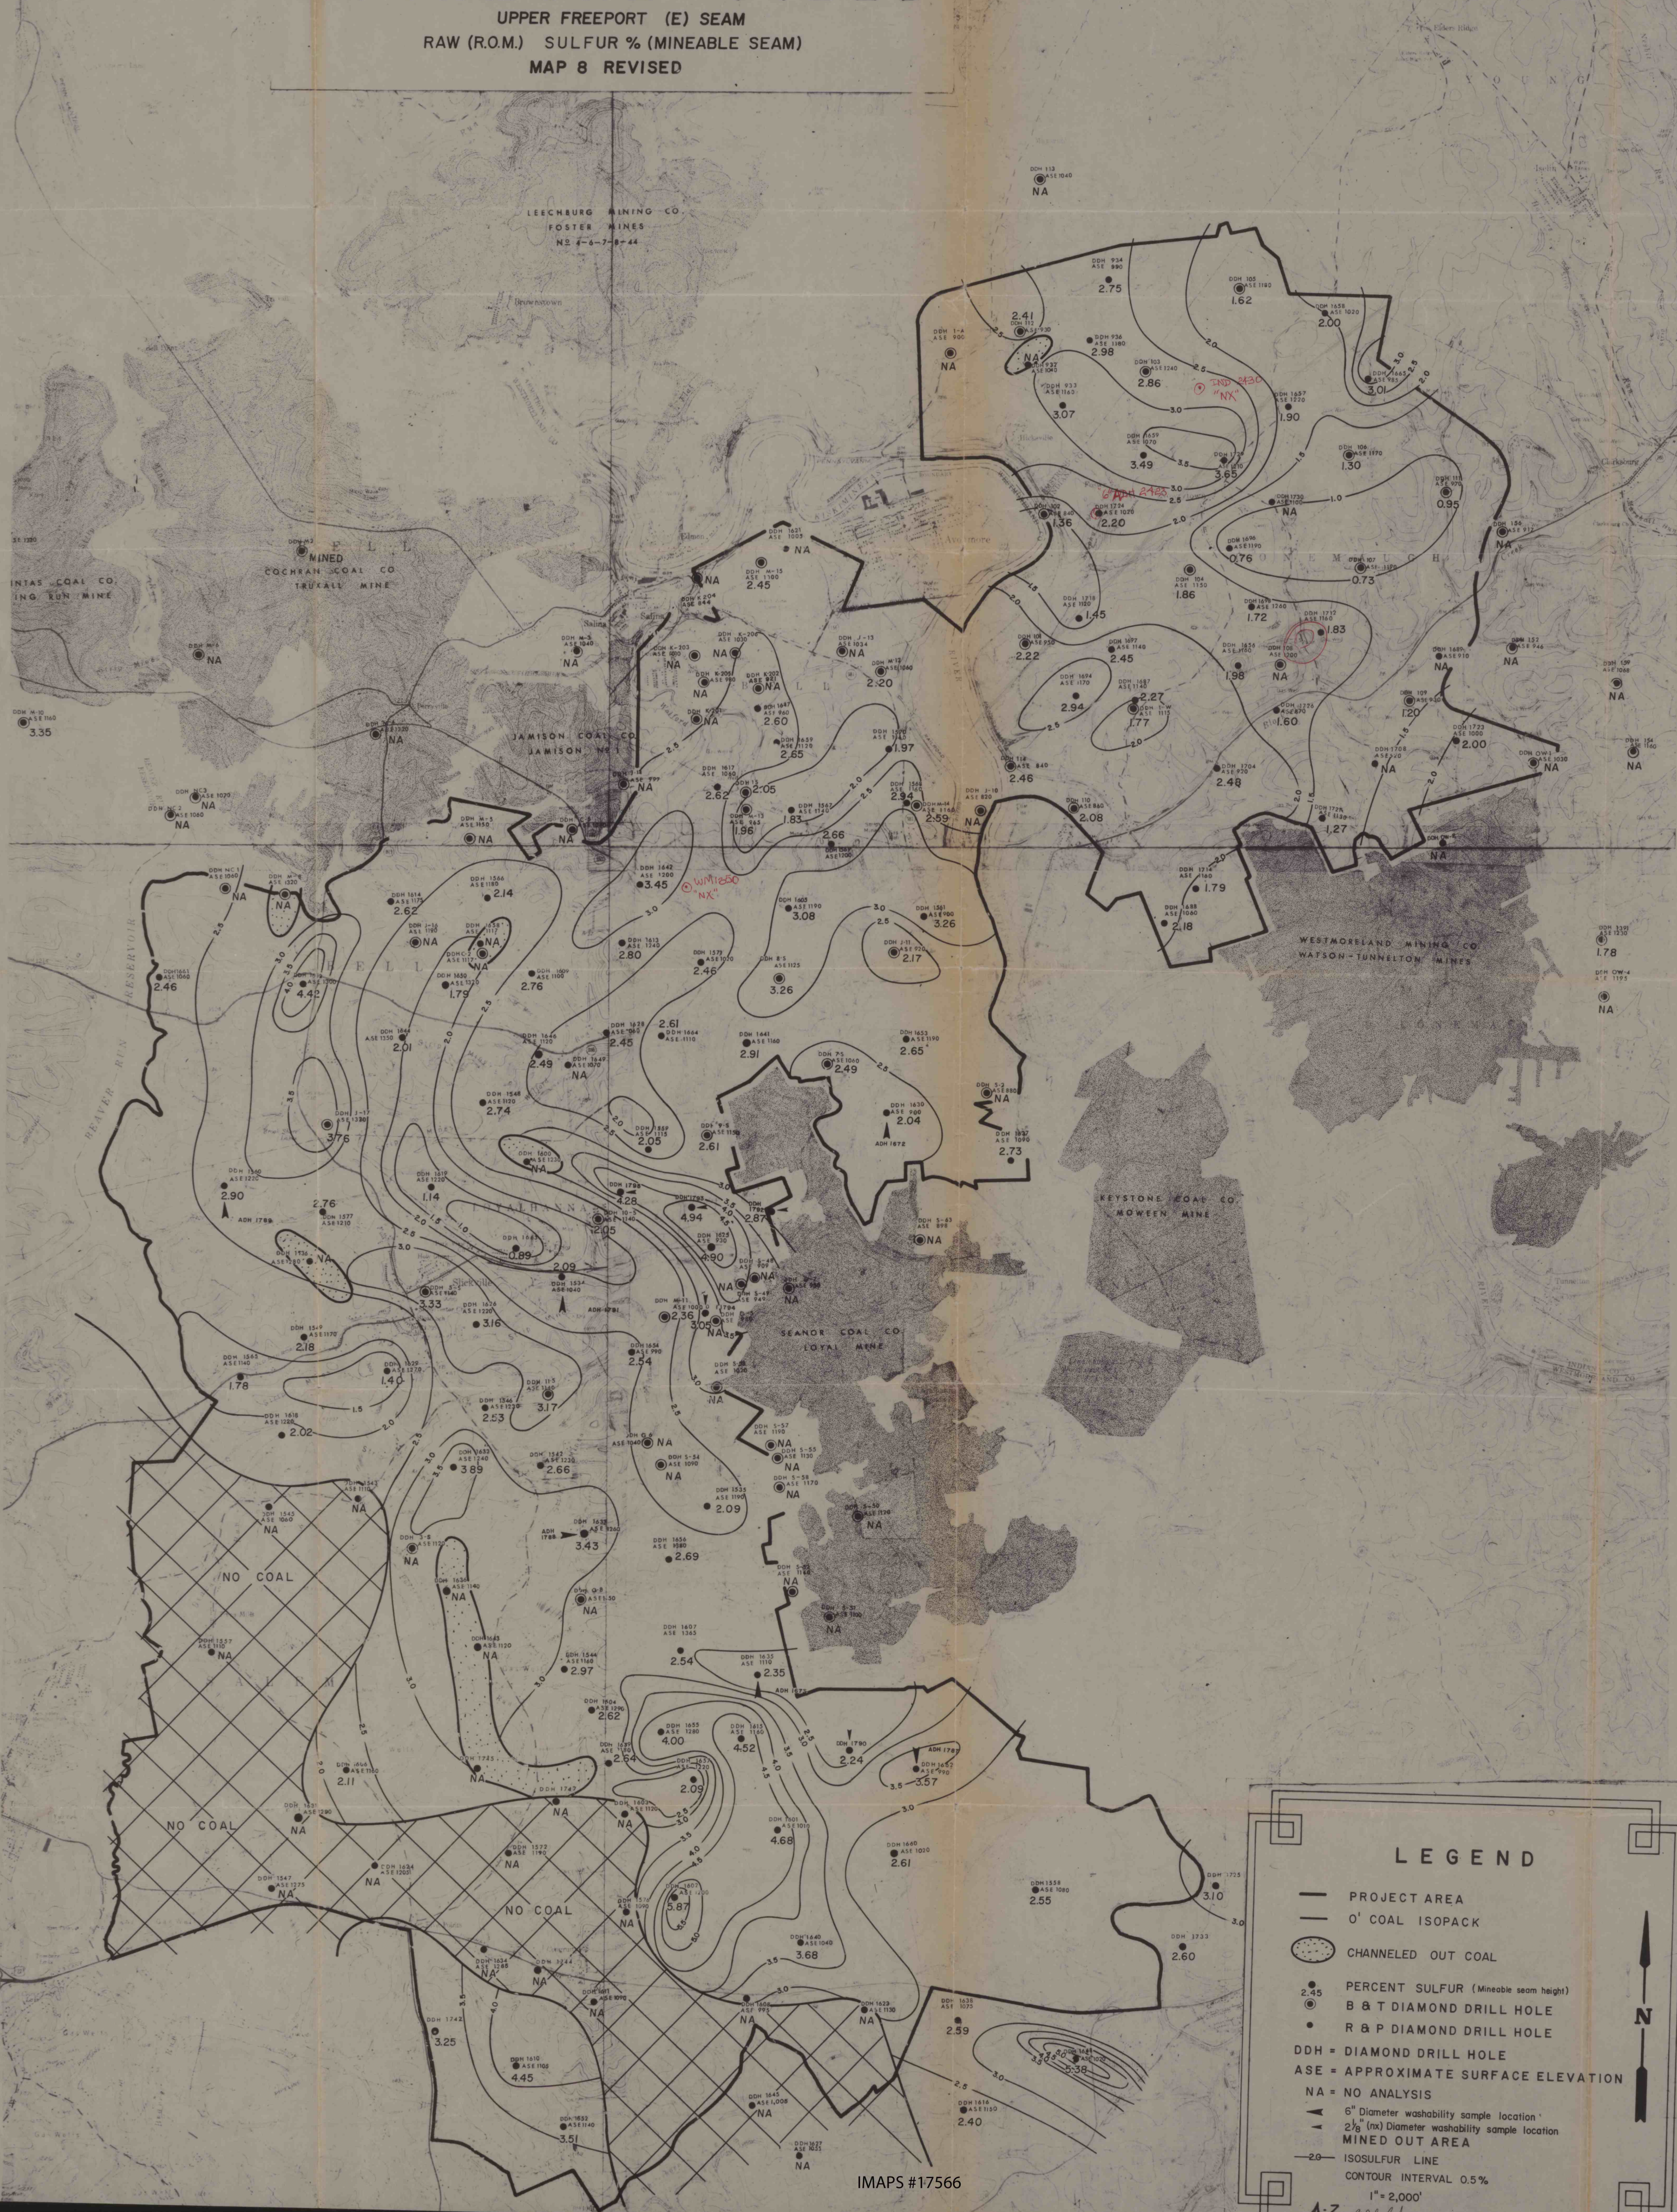

IMAPS #17566

LEGEND

-  PROJECT AREA
 0' COAL ISOPACK
 CHANNELED OUT COAL
 PERCENT SULFUR (Mineable seam height)
 B & T DIAMOND DRILL HOLE
 R & P DIAMOND DRILL HOLE
DDH = DIAMOND DRILL HOLE
ASE = APPROXIMATE SURFACE ELEVATION
NA = NO ANALYSIS
 6" Diameter washability sample location
 2 1/2" (nx) Diameter washability sample location
MINED OUT AREA
 20
CONTOUR INTERVAL 0.5%

A-7

W. A. B. REVISED 1/19/8