


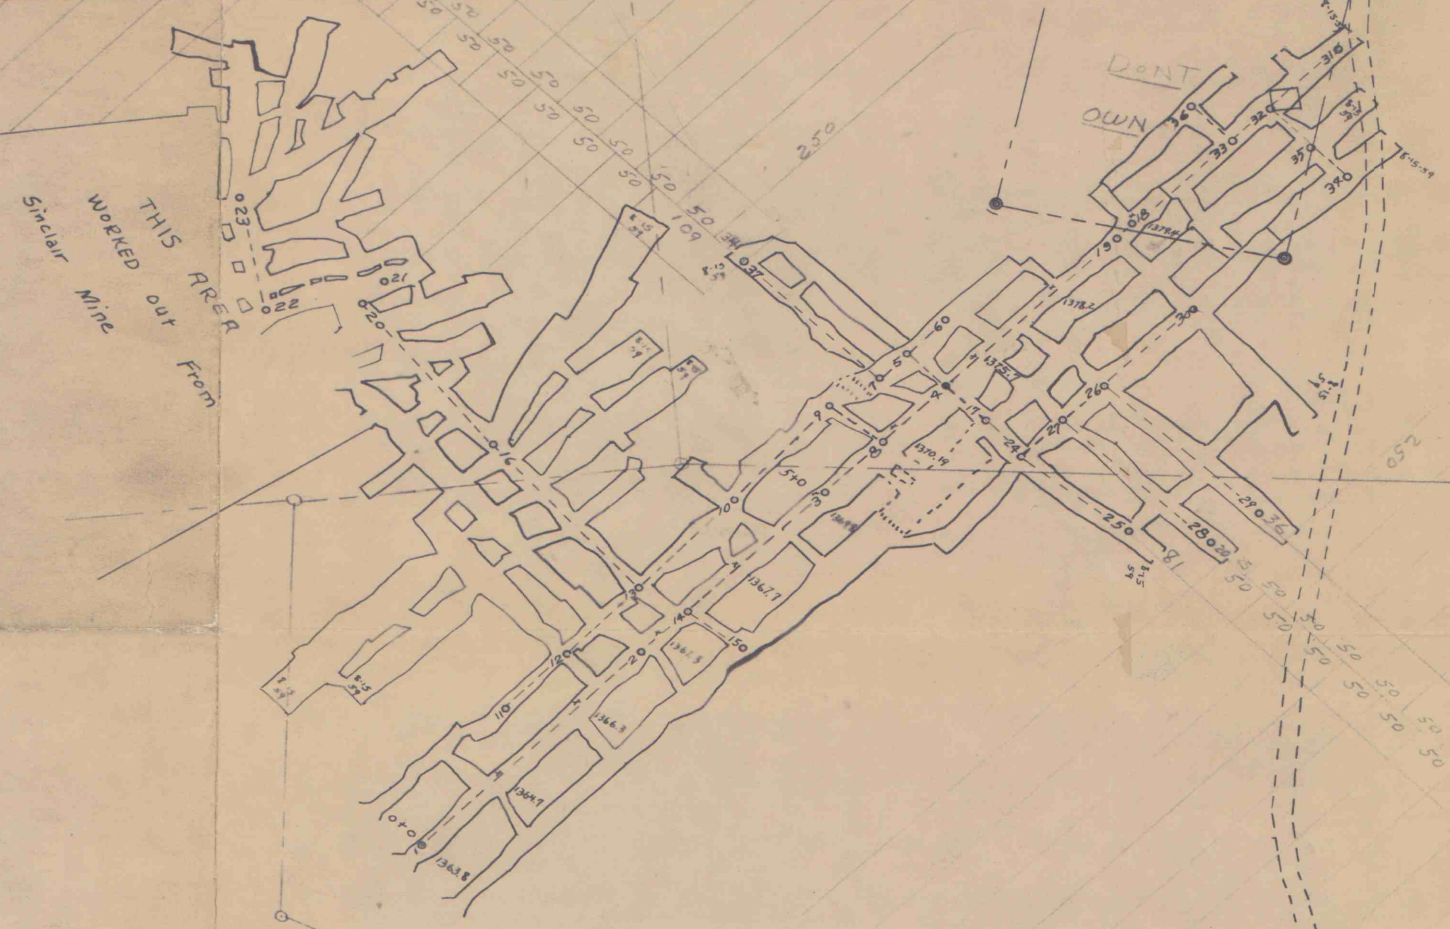

John St. Clair

James Overdorf

Dont Own

George Gamble

MILLER #2 MINE

Scale 1"=100ft
Situate West Wheatfield Township
Indiana County, Pa.