


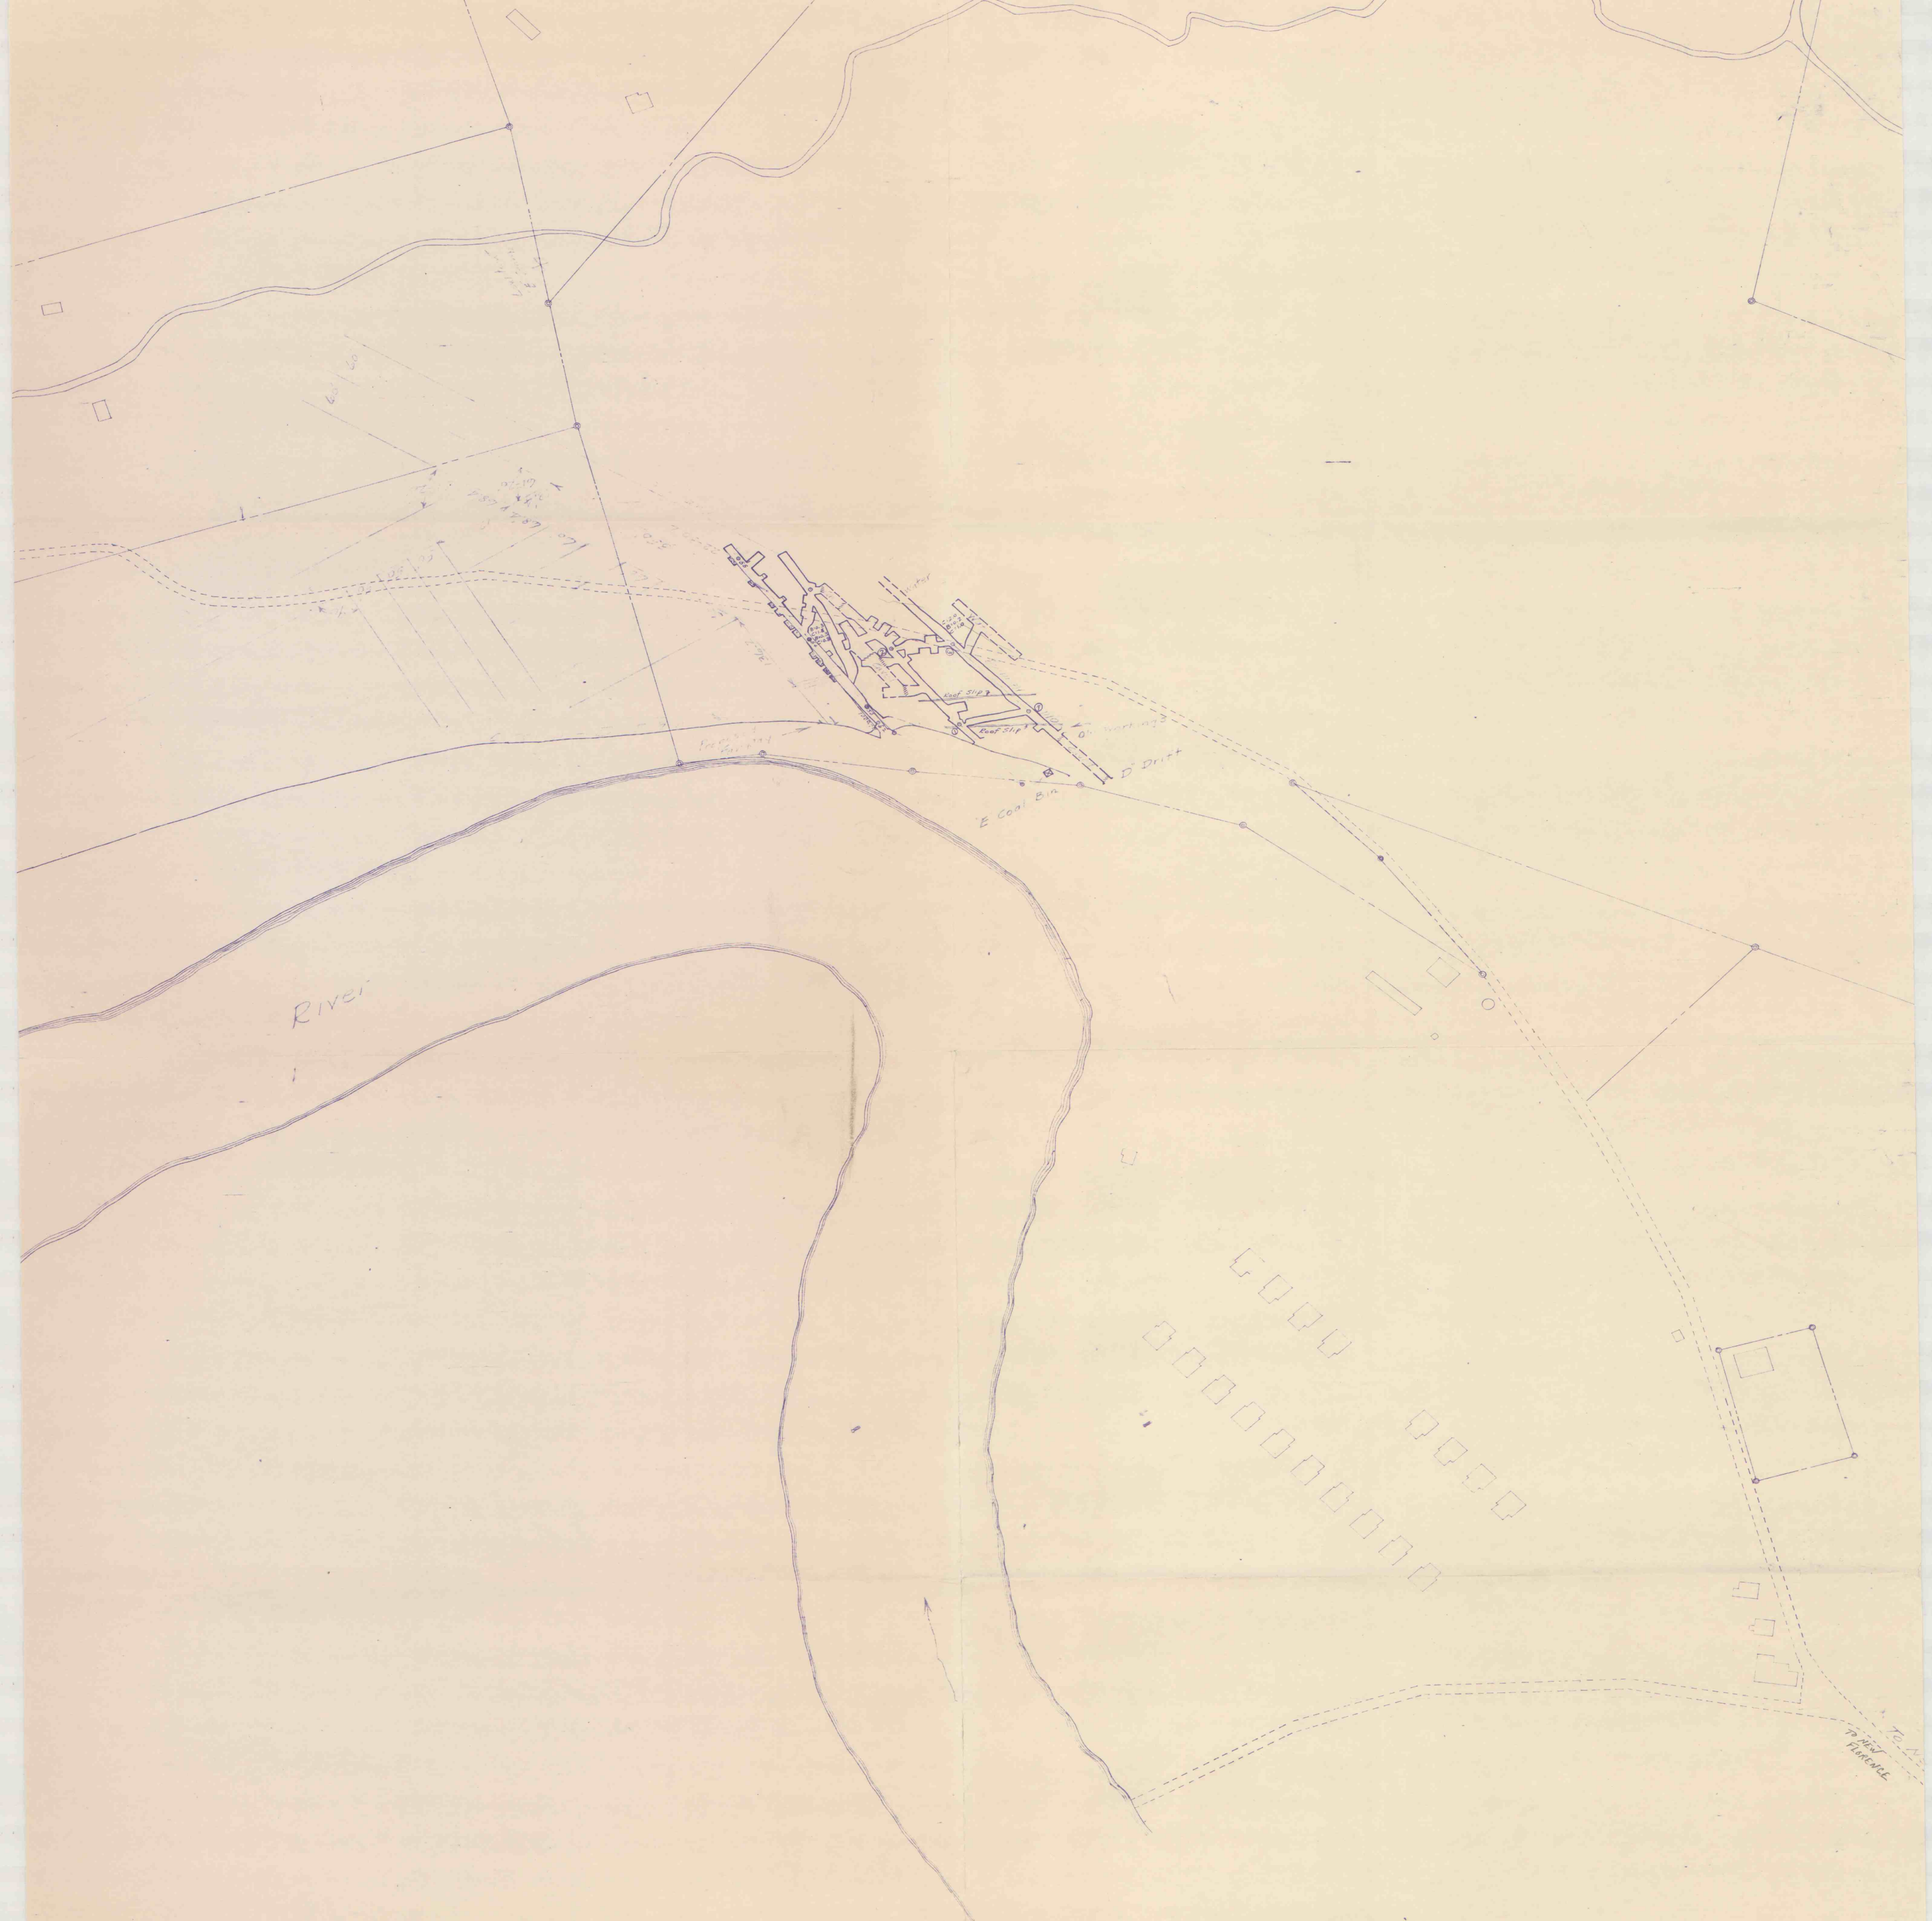

Consolidated Coal & Coke Co.
Lower Freeport or D. 5-m. Operations
Situated at
Glimax, West Wheatfield Township,
Indiana Co., Pa.