IMAPS #17614

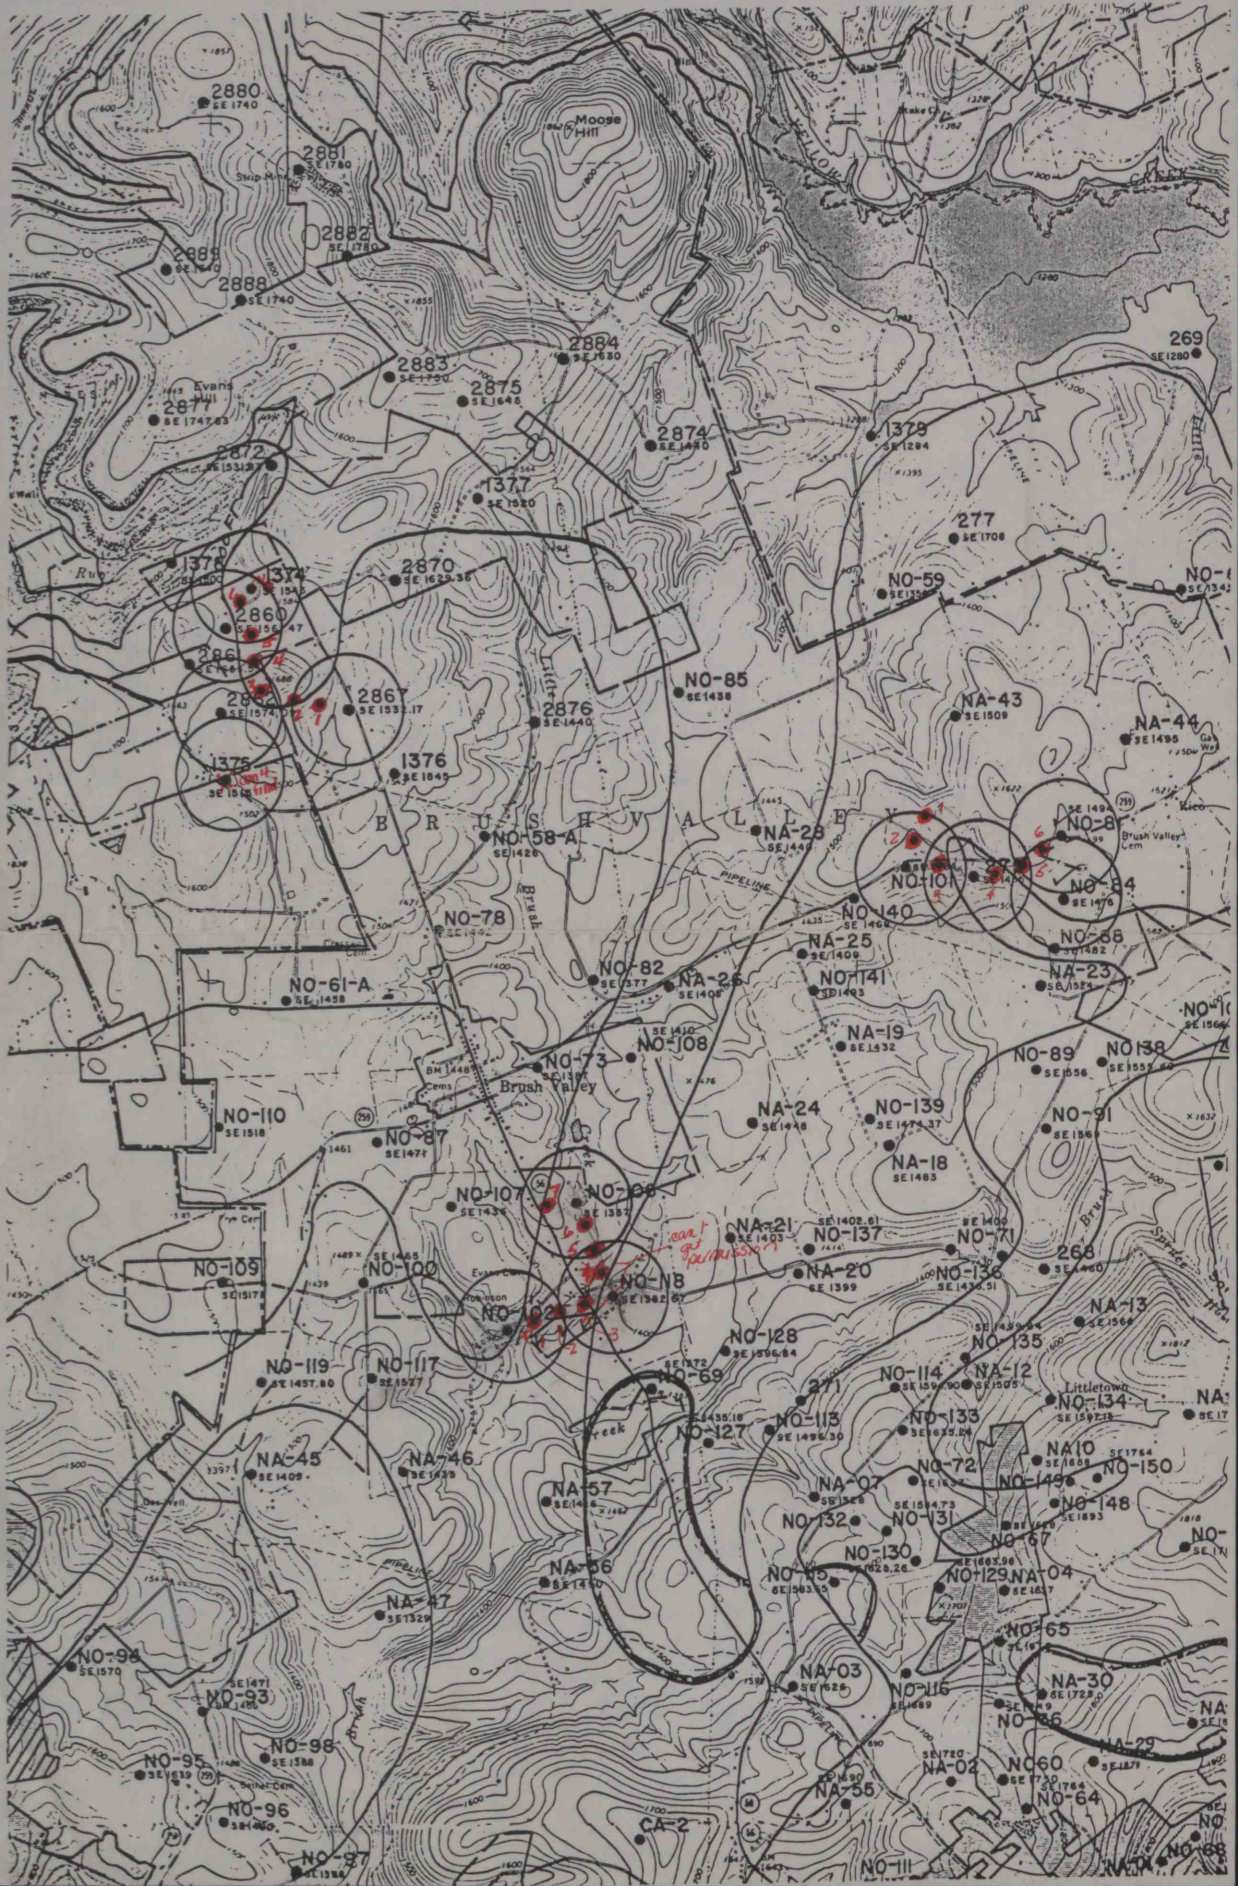
Moose Hill
Brush Valley
Brush Valley Cem
Littletown
Evans
Robinson
PIPELINE
2880
2881
2882
2888
2884
2883
2875
2874
2872
1377
1378
2870
2860
2867
2876
1376
1375
269
277
NO-59
NO-85
NA-43
NA-44
NO-8
NO-84
NO-101
NO-140
NO-58
NA-23
NA-28
NO-58-A
NO-78
NO-82
NA-26
NO-61-A
NO-141
NA-25
NO-108
NO-73
NA-19
NO-89
NO-138
NO-110
NO-87
NA-24
NO-139
NO-91
NA-18
NO-107
NO-106
NA-21
NO-137
NO-71
NO-136
268
NO-105
NO-100
NO-18
NA-20
NA-13
NO-128
NO-135
NO-119
NO-117
NO-69
NO-114
NA-12
271
NO-134
NO-113
NO-133
NO-127
NA-45
NA-46
NA-57
NA-07
NO-72
NA10
NO-150
NO-149
NO-148
NO-132
NO-131
NO-67
NO-130
NA-56
NO-129
NA-04
NA-47
NO-65
NO-94
NO-93
NA-03
NO-116
NA-30
NO-66
NO-98
NO-95
NA-02
NO-60
NA-29
NO-96
NA-55
NO-64
CA-2
NO-97
NO-111
NO-88