


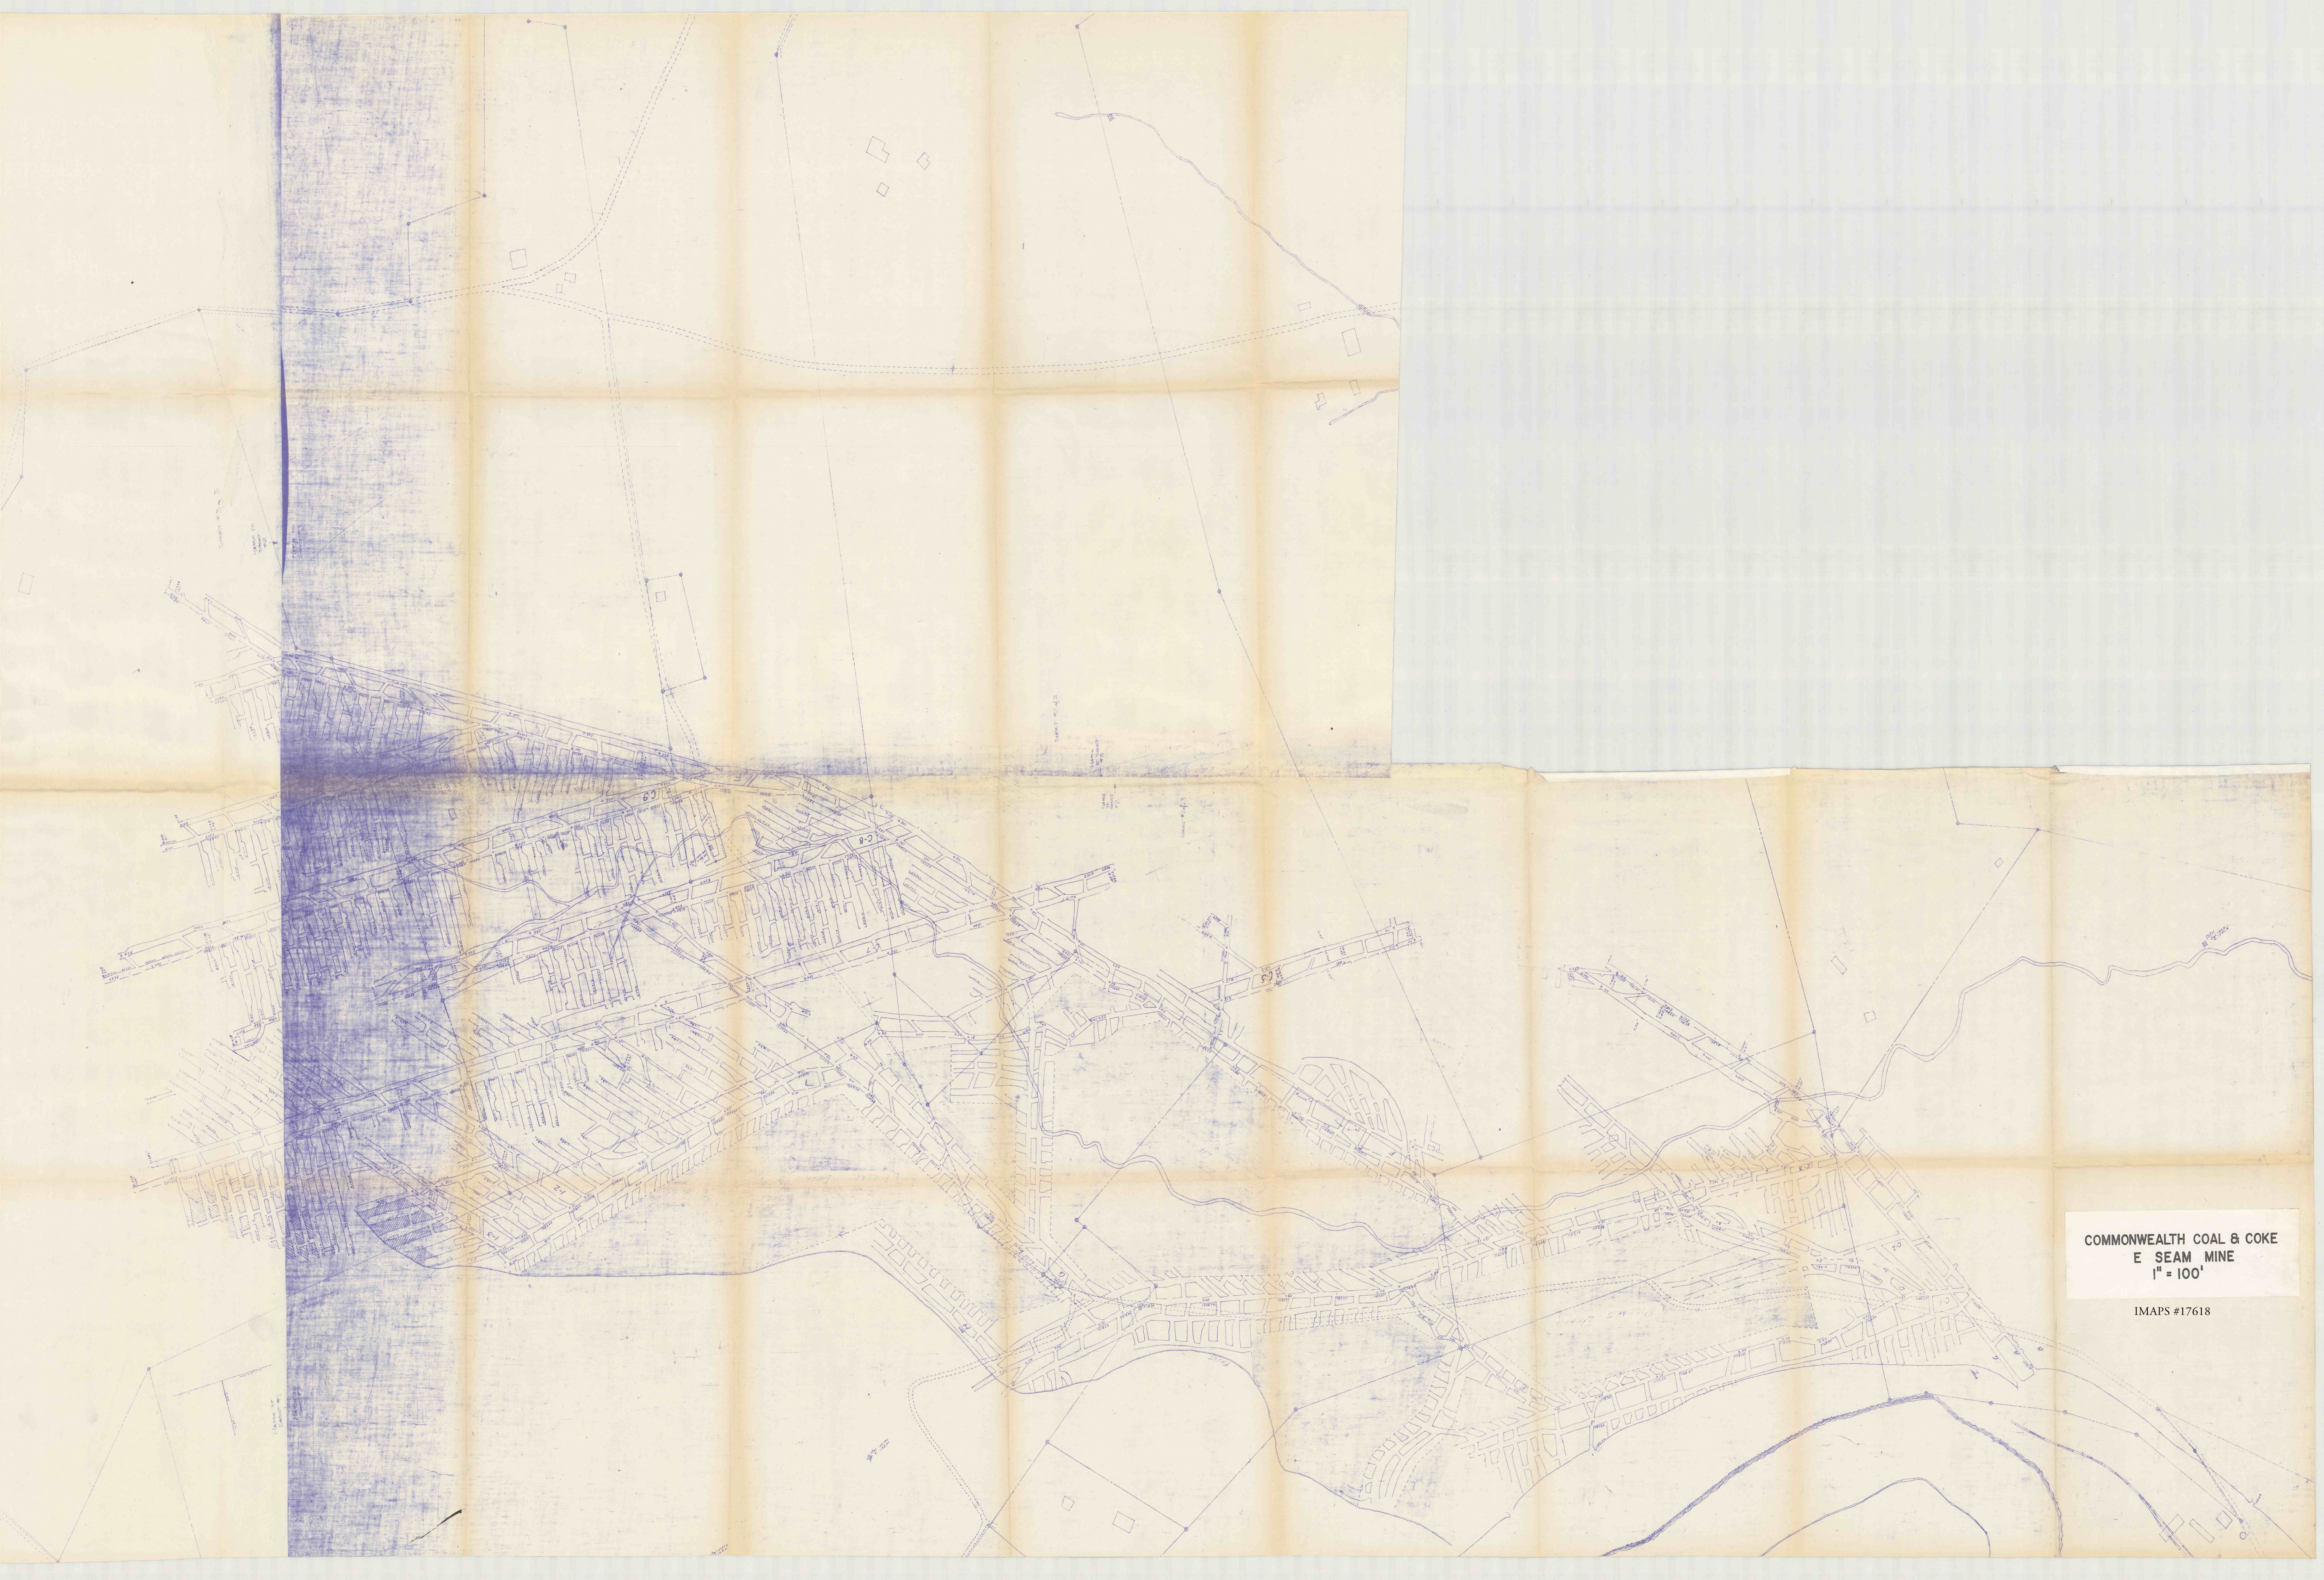

COMMONWEALTH COAL & COKE
E SEAM MINE
1" = 100'

IMAPS #17618