


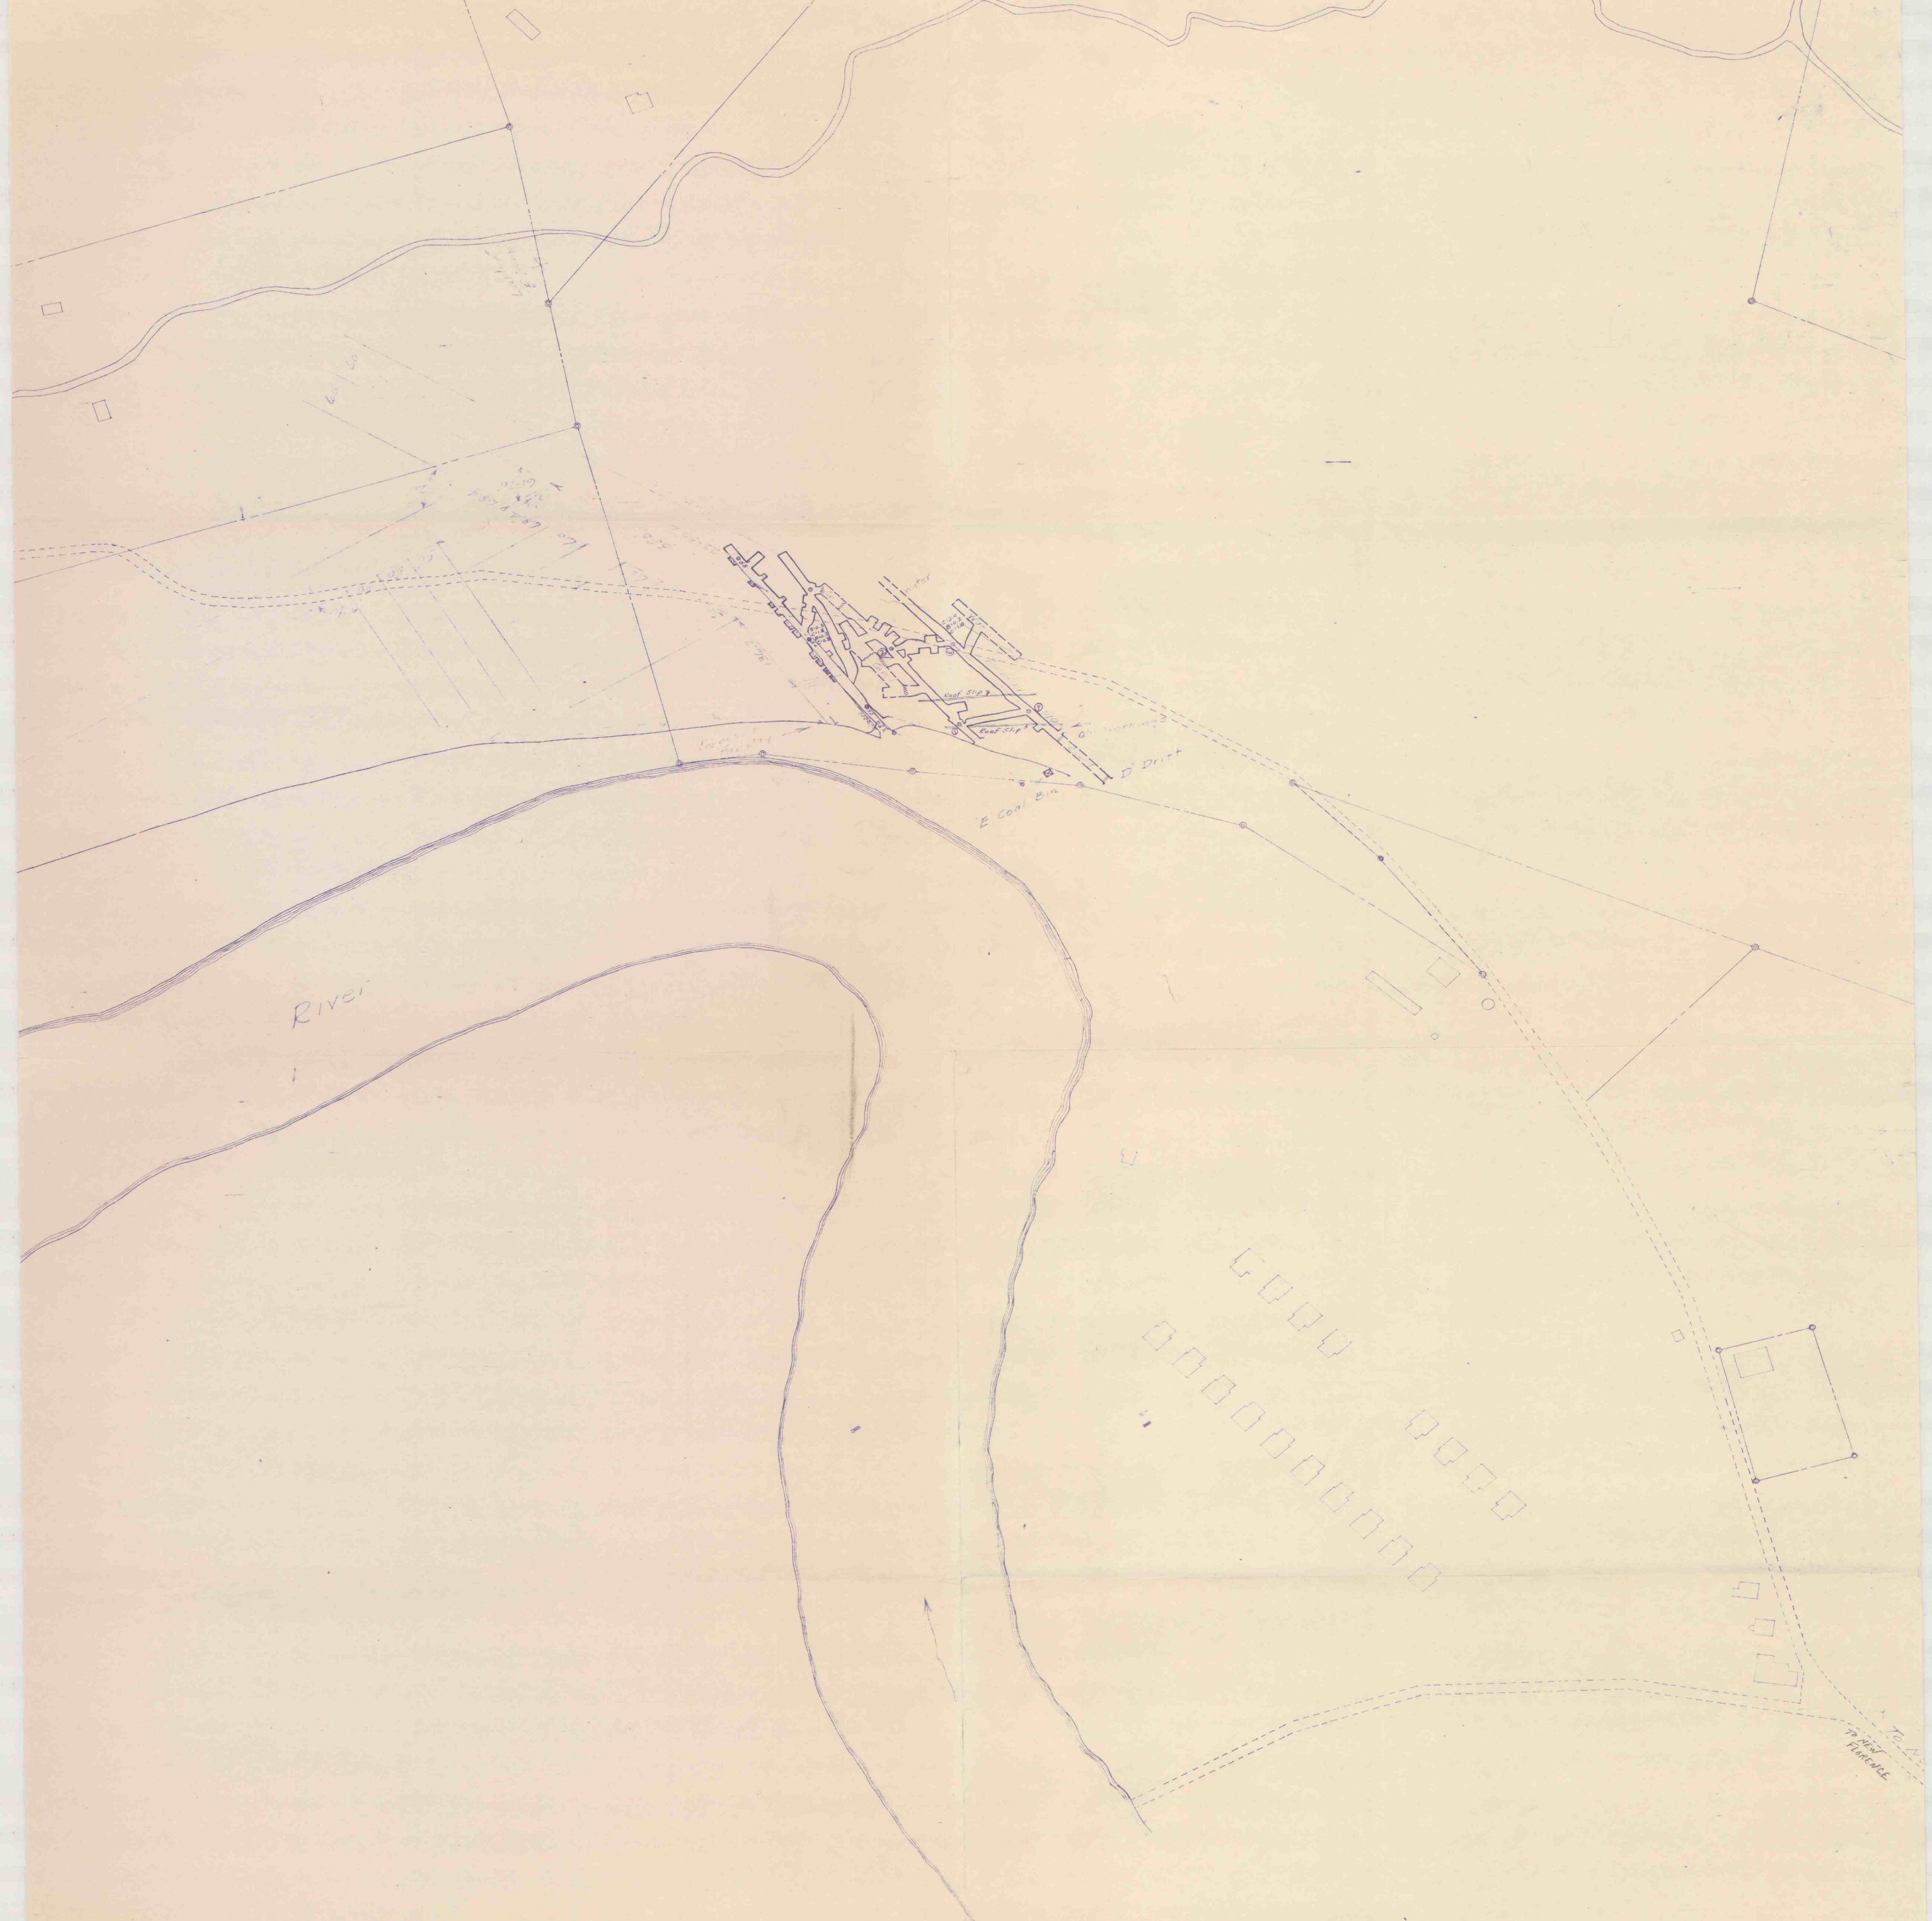

Central Western Coal & Coke Co.
Lower Freepit and D. 5-m Operations
Situated at
Glimax, West Wheatfield Township,
Indiana Co., Pa.