


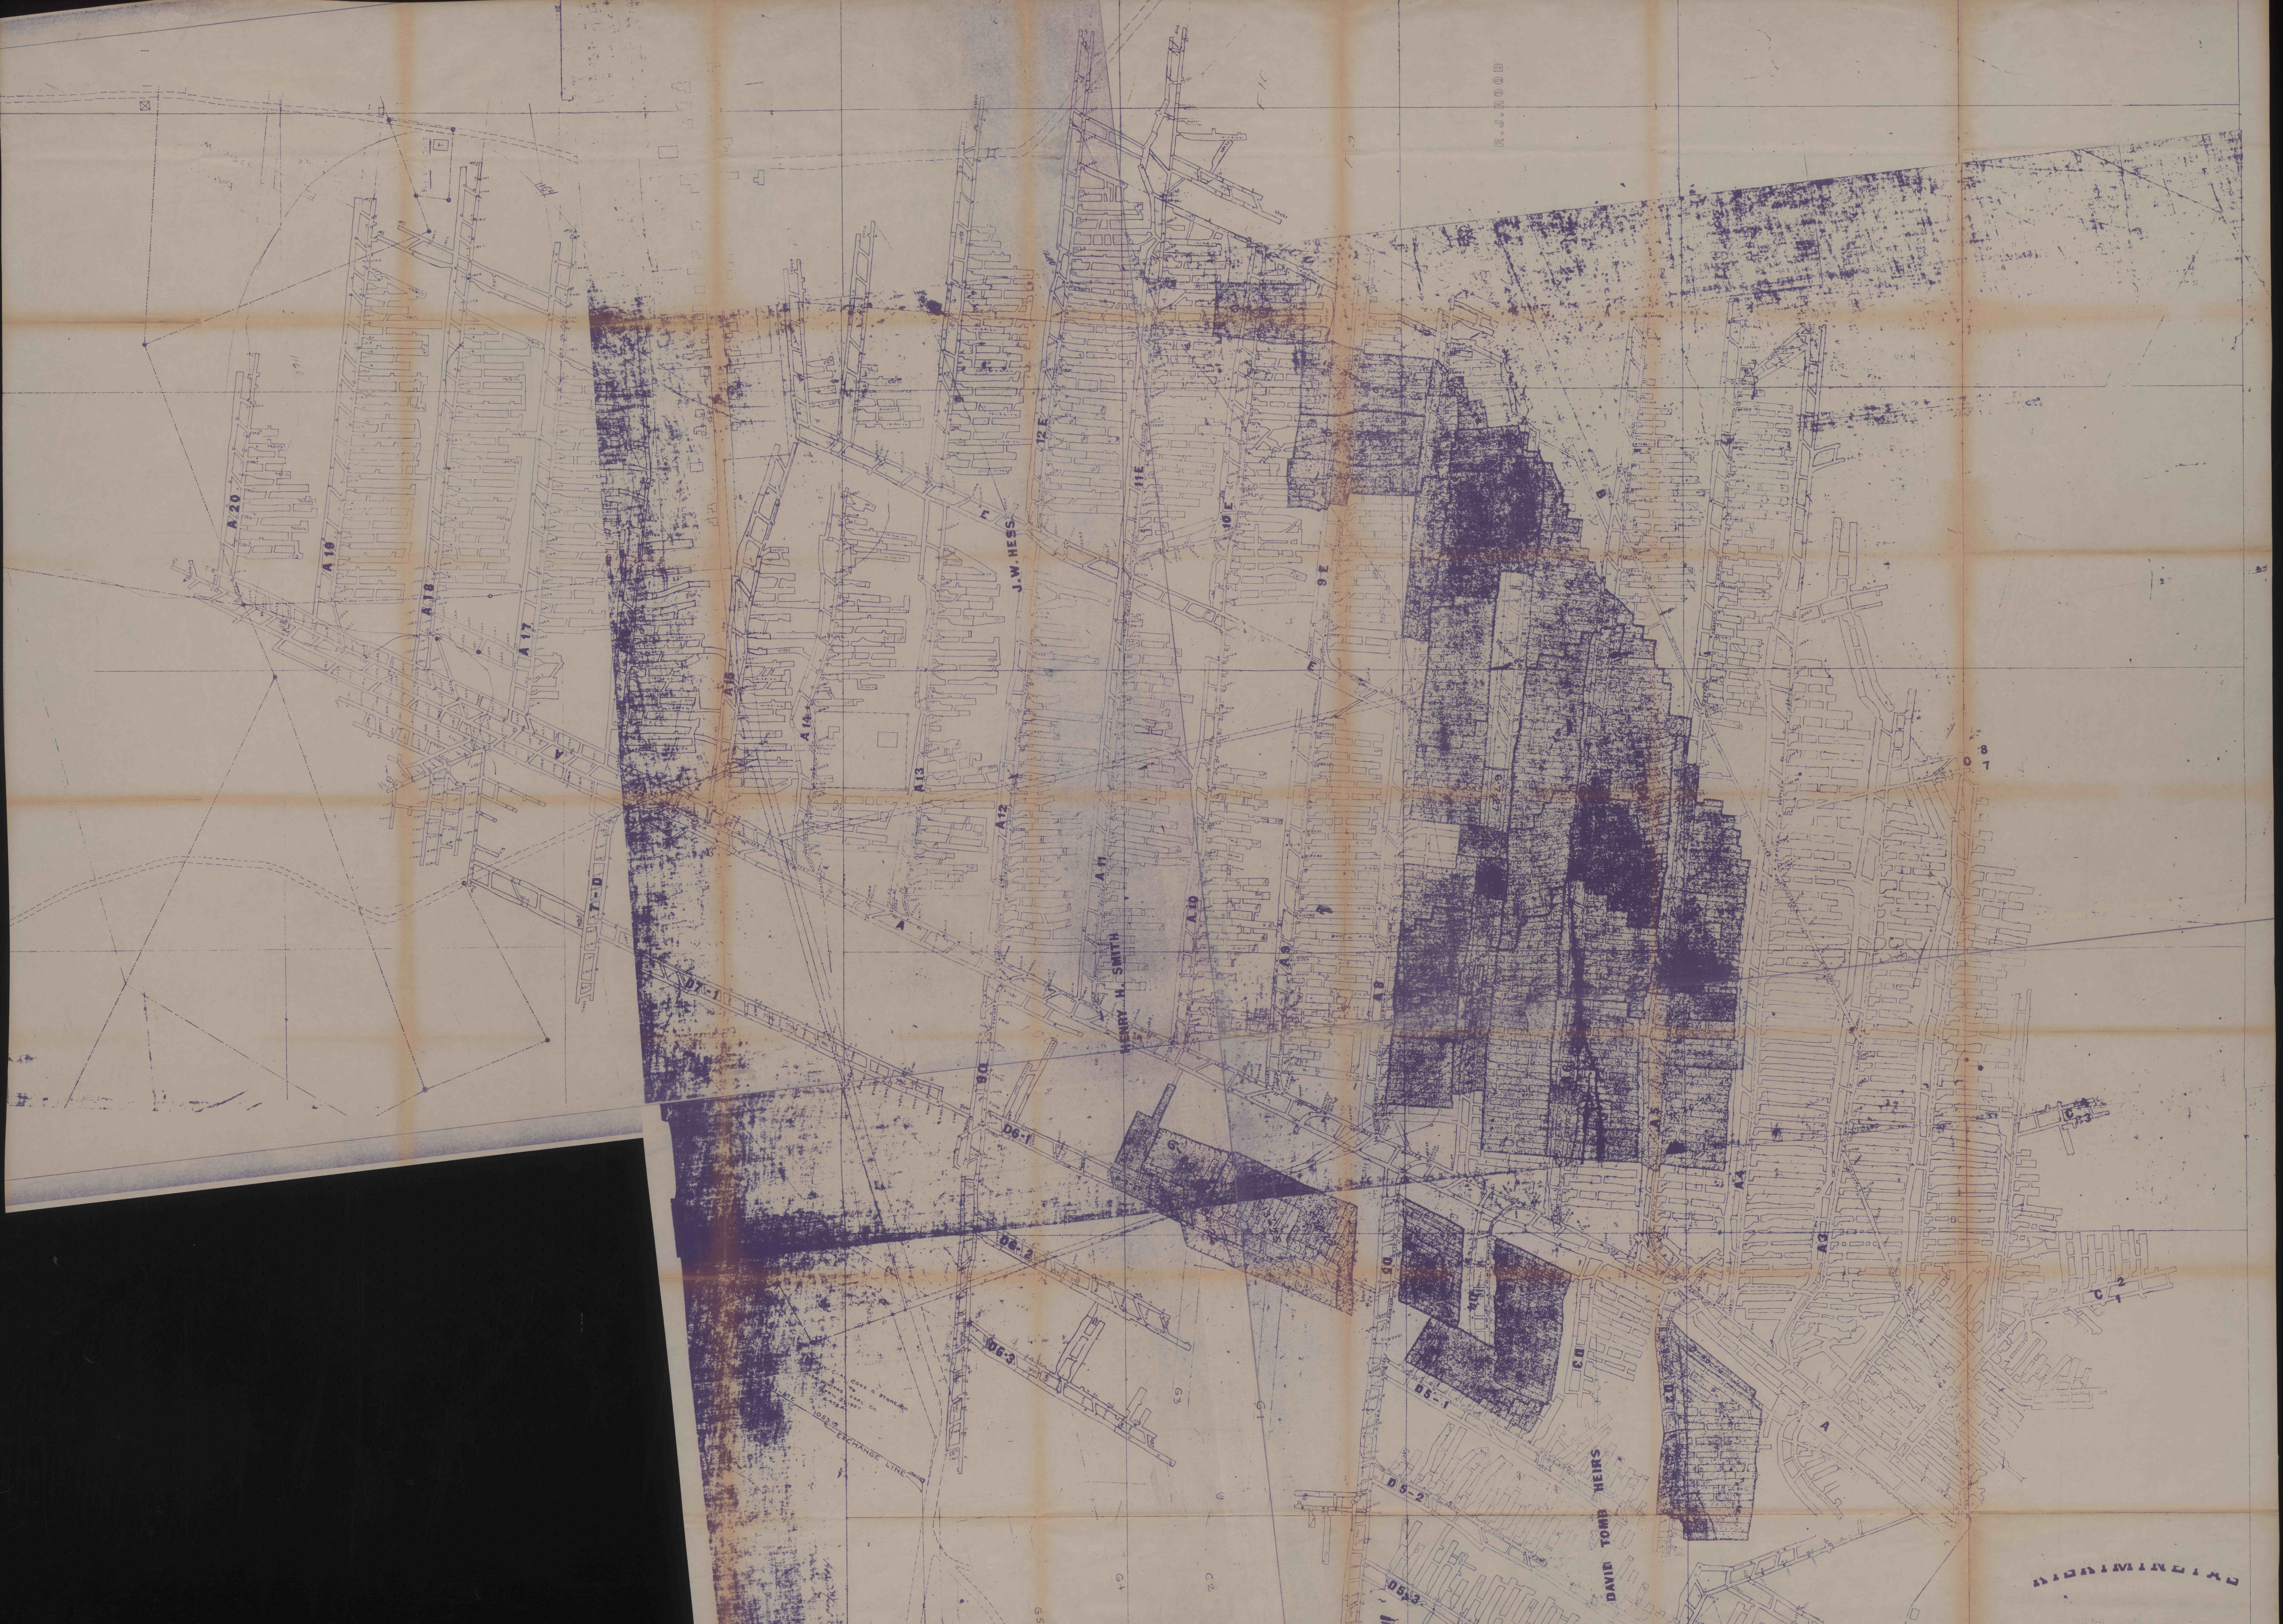

R.J. HOOD

J.W. HESS

HENRY H. SMITH

DAVID TOMB HEIRS

REPRODUCED FROM