


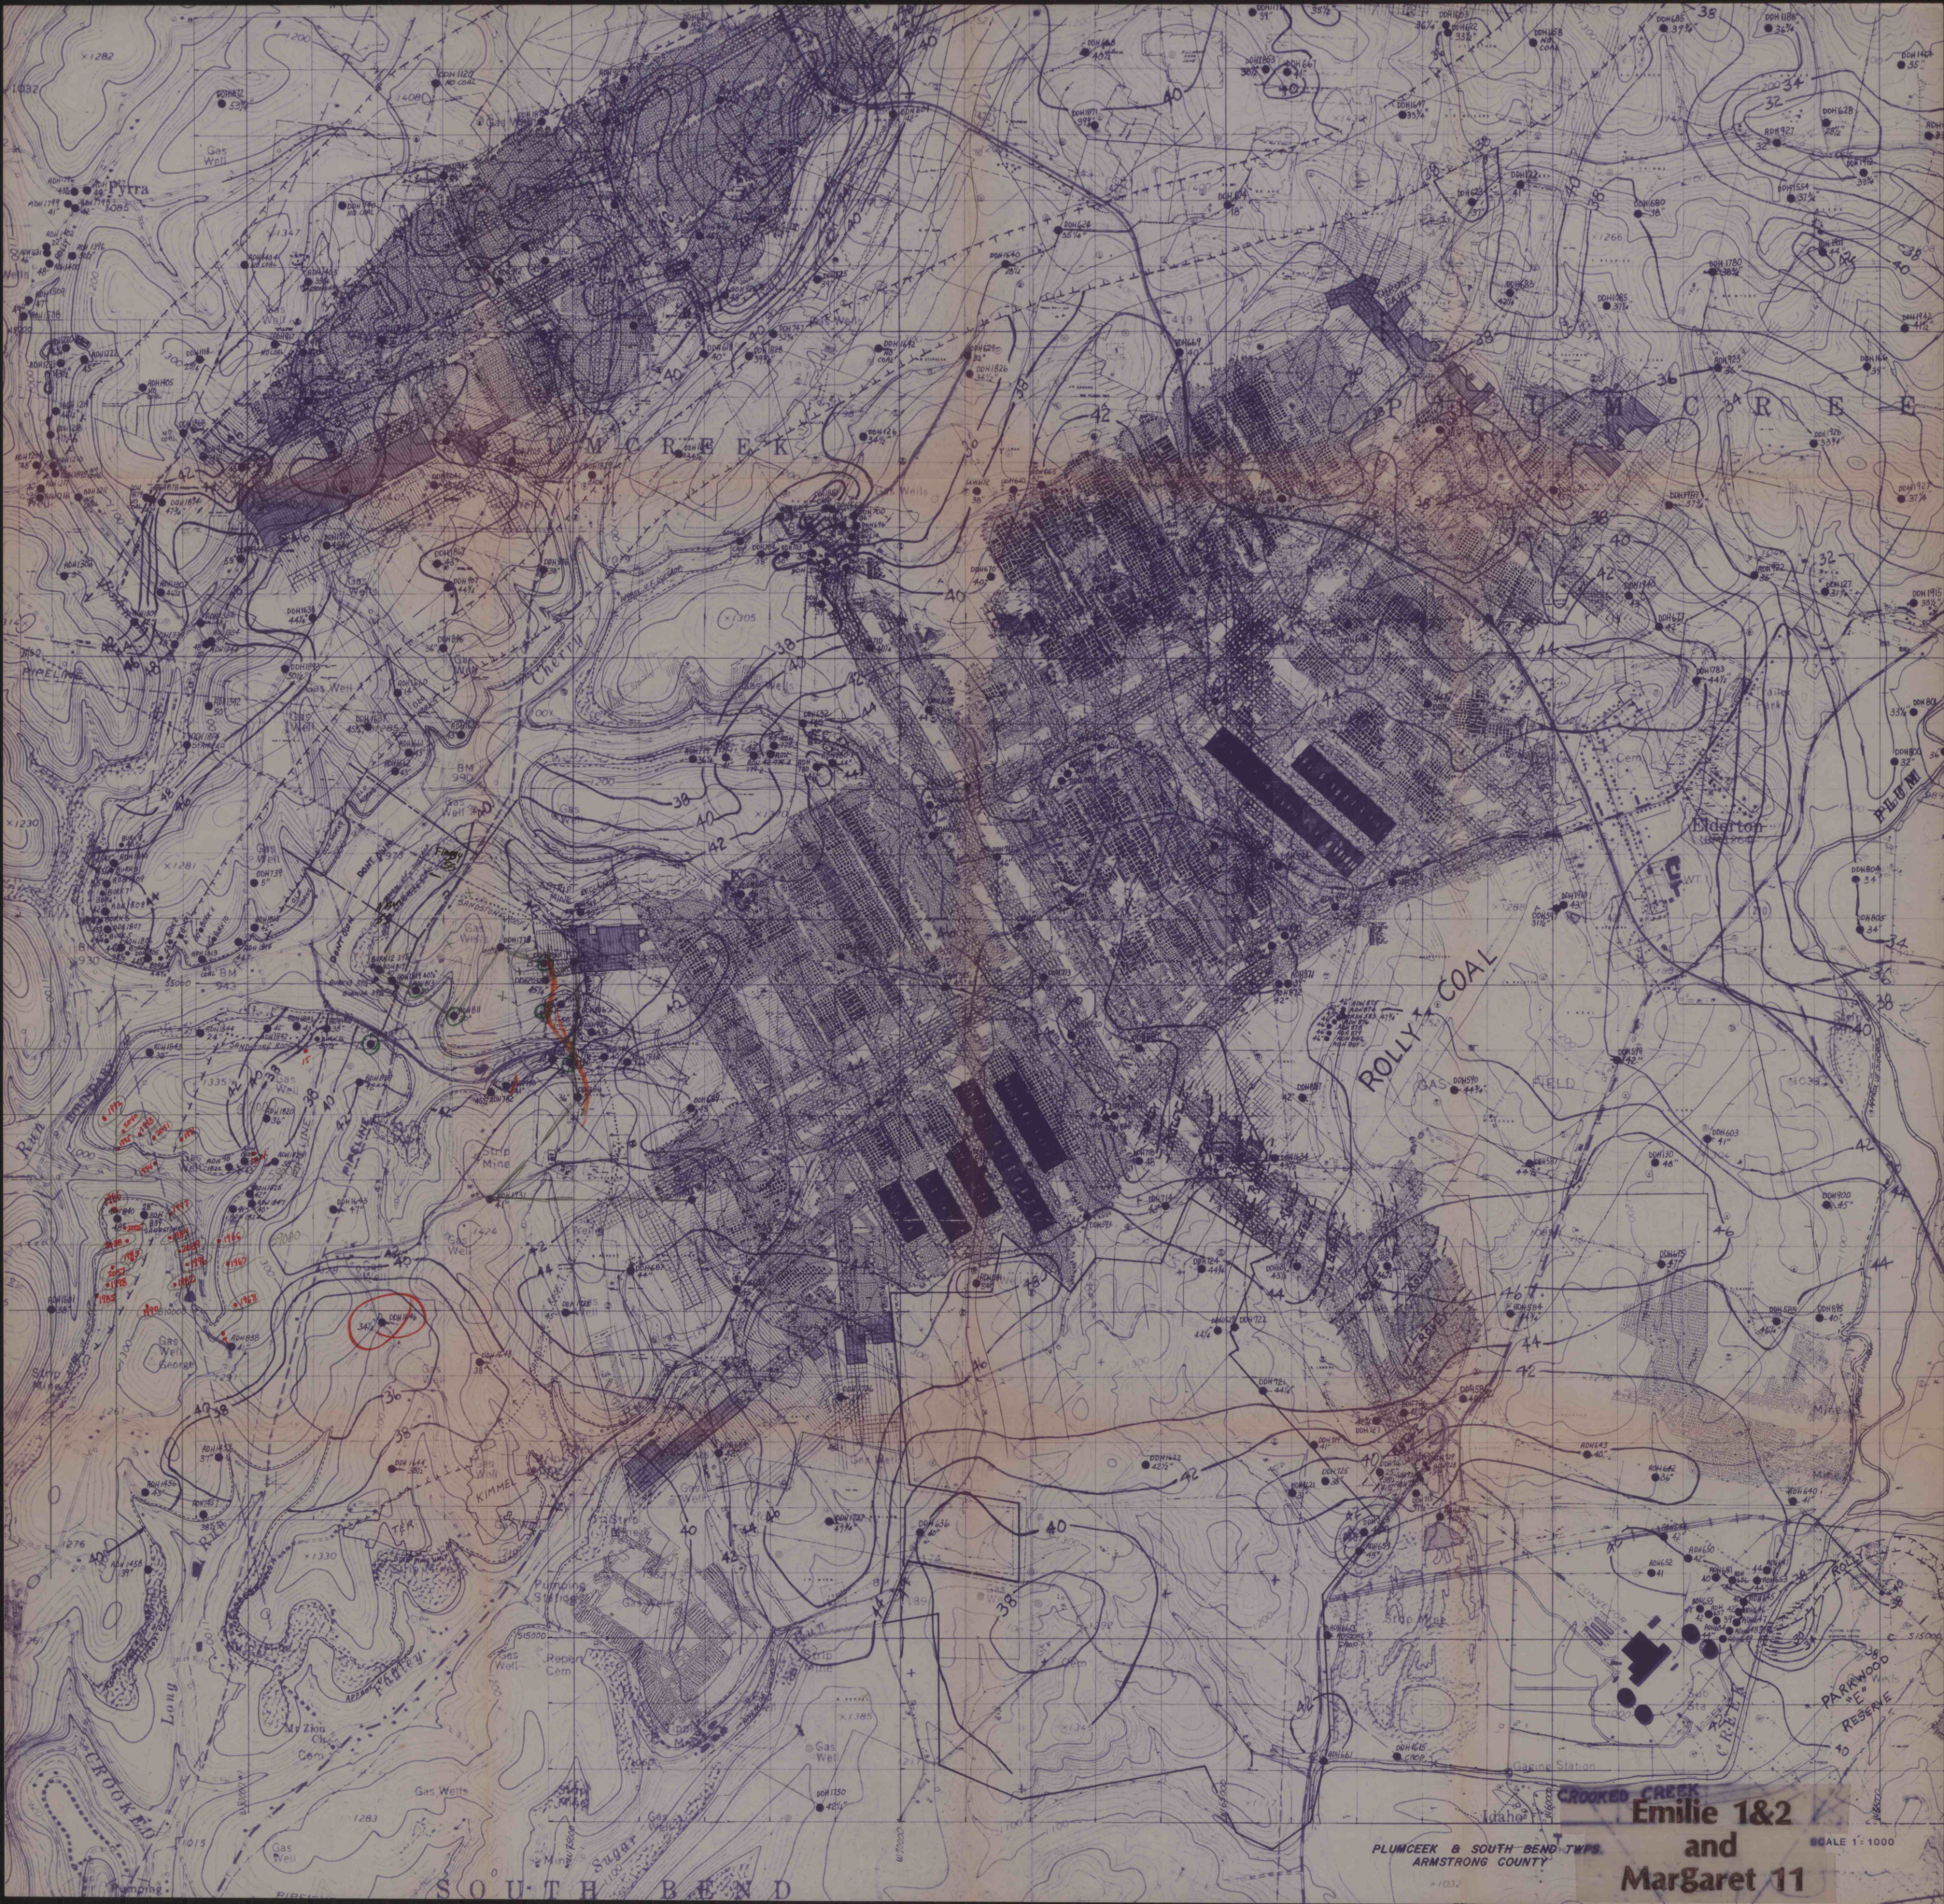

PLUM CREEK & SOUTH BEND TOWNSHIPS
ARMSTRONG COUNTY

Emilie 1&2
and
Margaret 11

SCALE 1" = 1000'