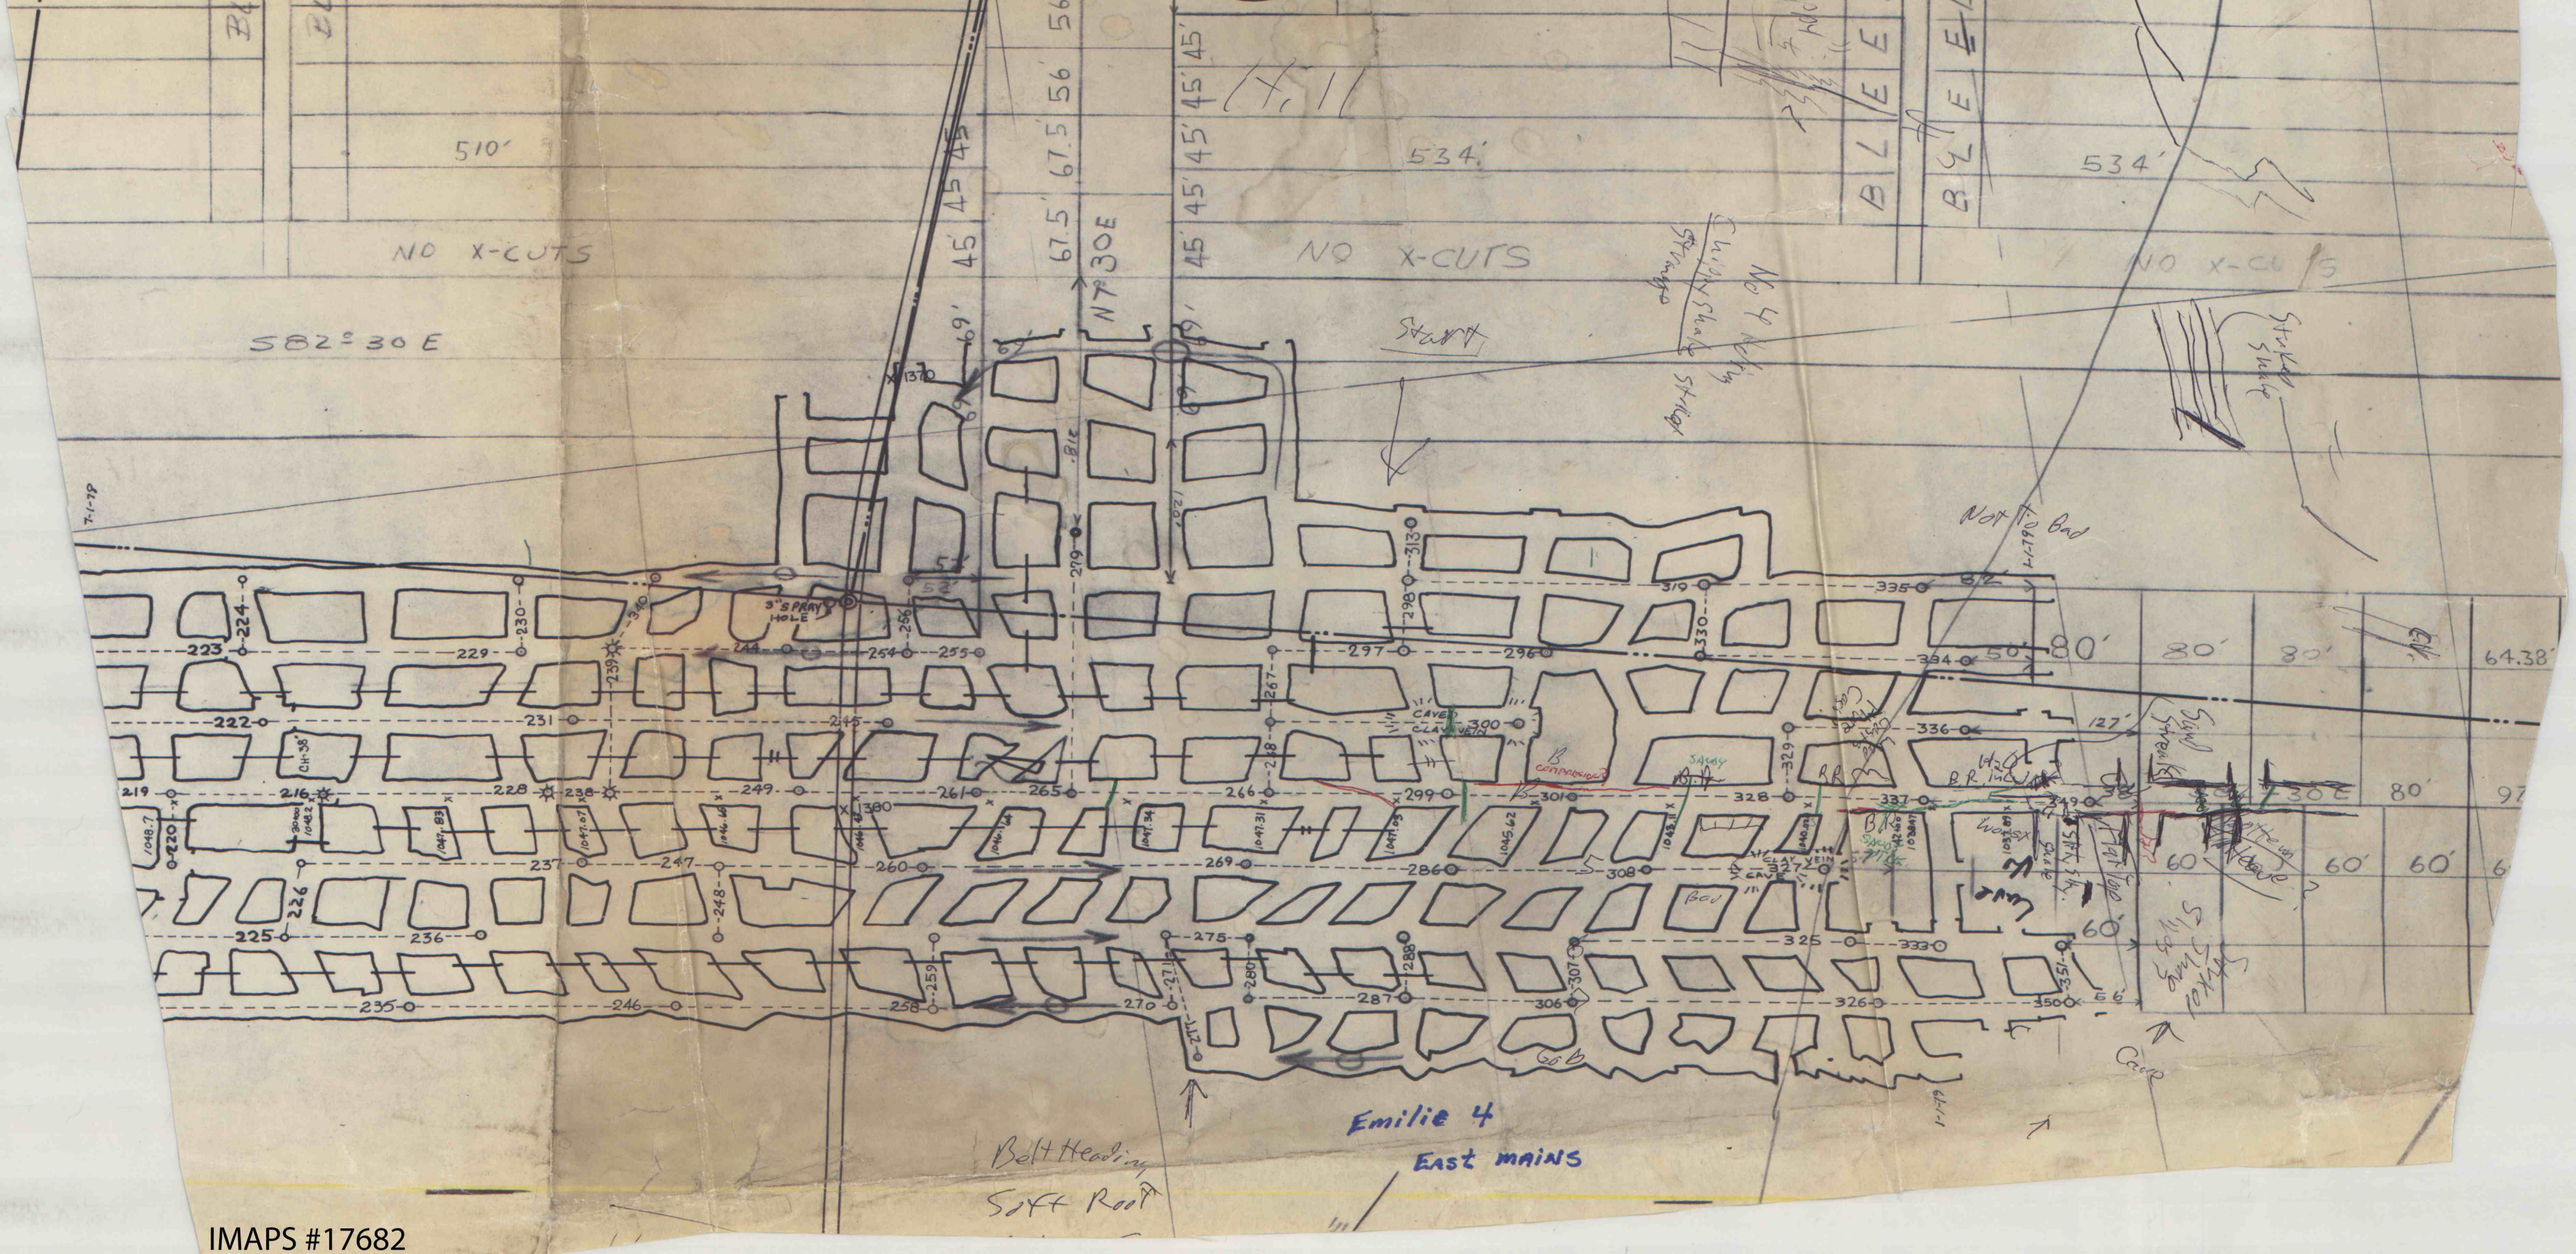
510'
NO X-CUTS
S82°30E
N7°30E
534'
NO X-CUTS
534'
NO X-CUTS
Start
Not to Bad
3" SPRAY HOLE
CAVED CLAY VEIN
Emilie 4
East mains
Belt Heading
Soft Roof
Cave

IMAPS #17682