


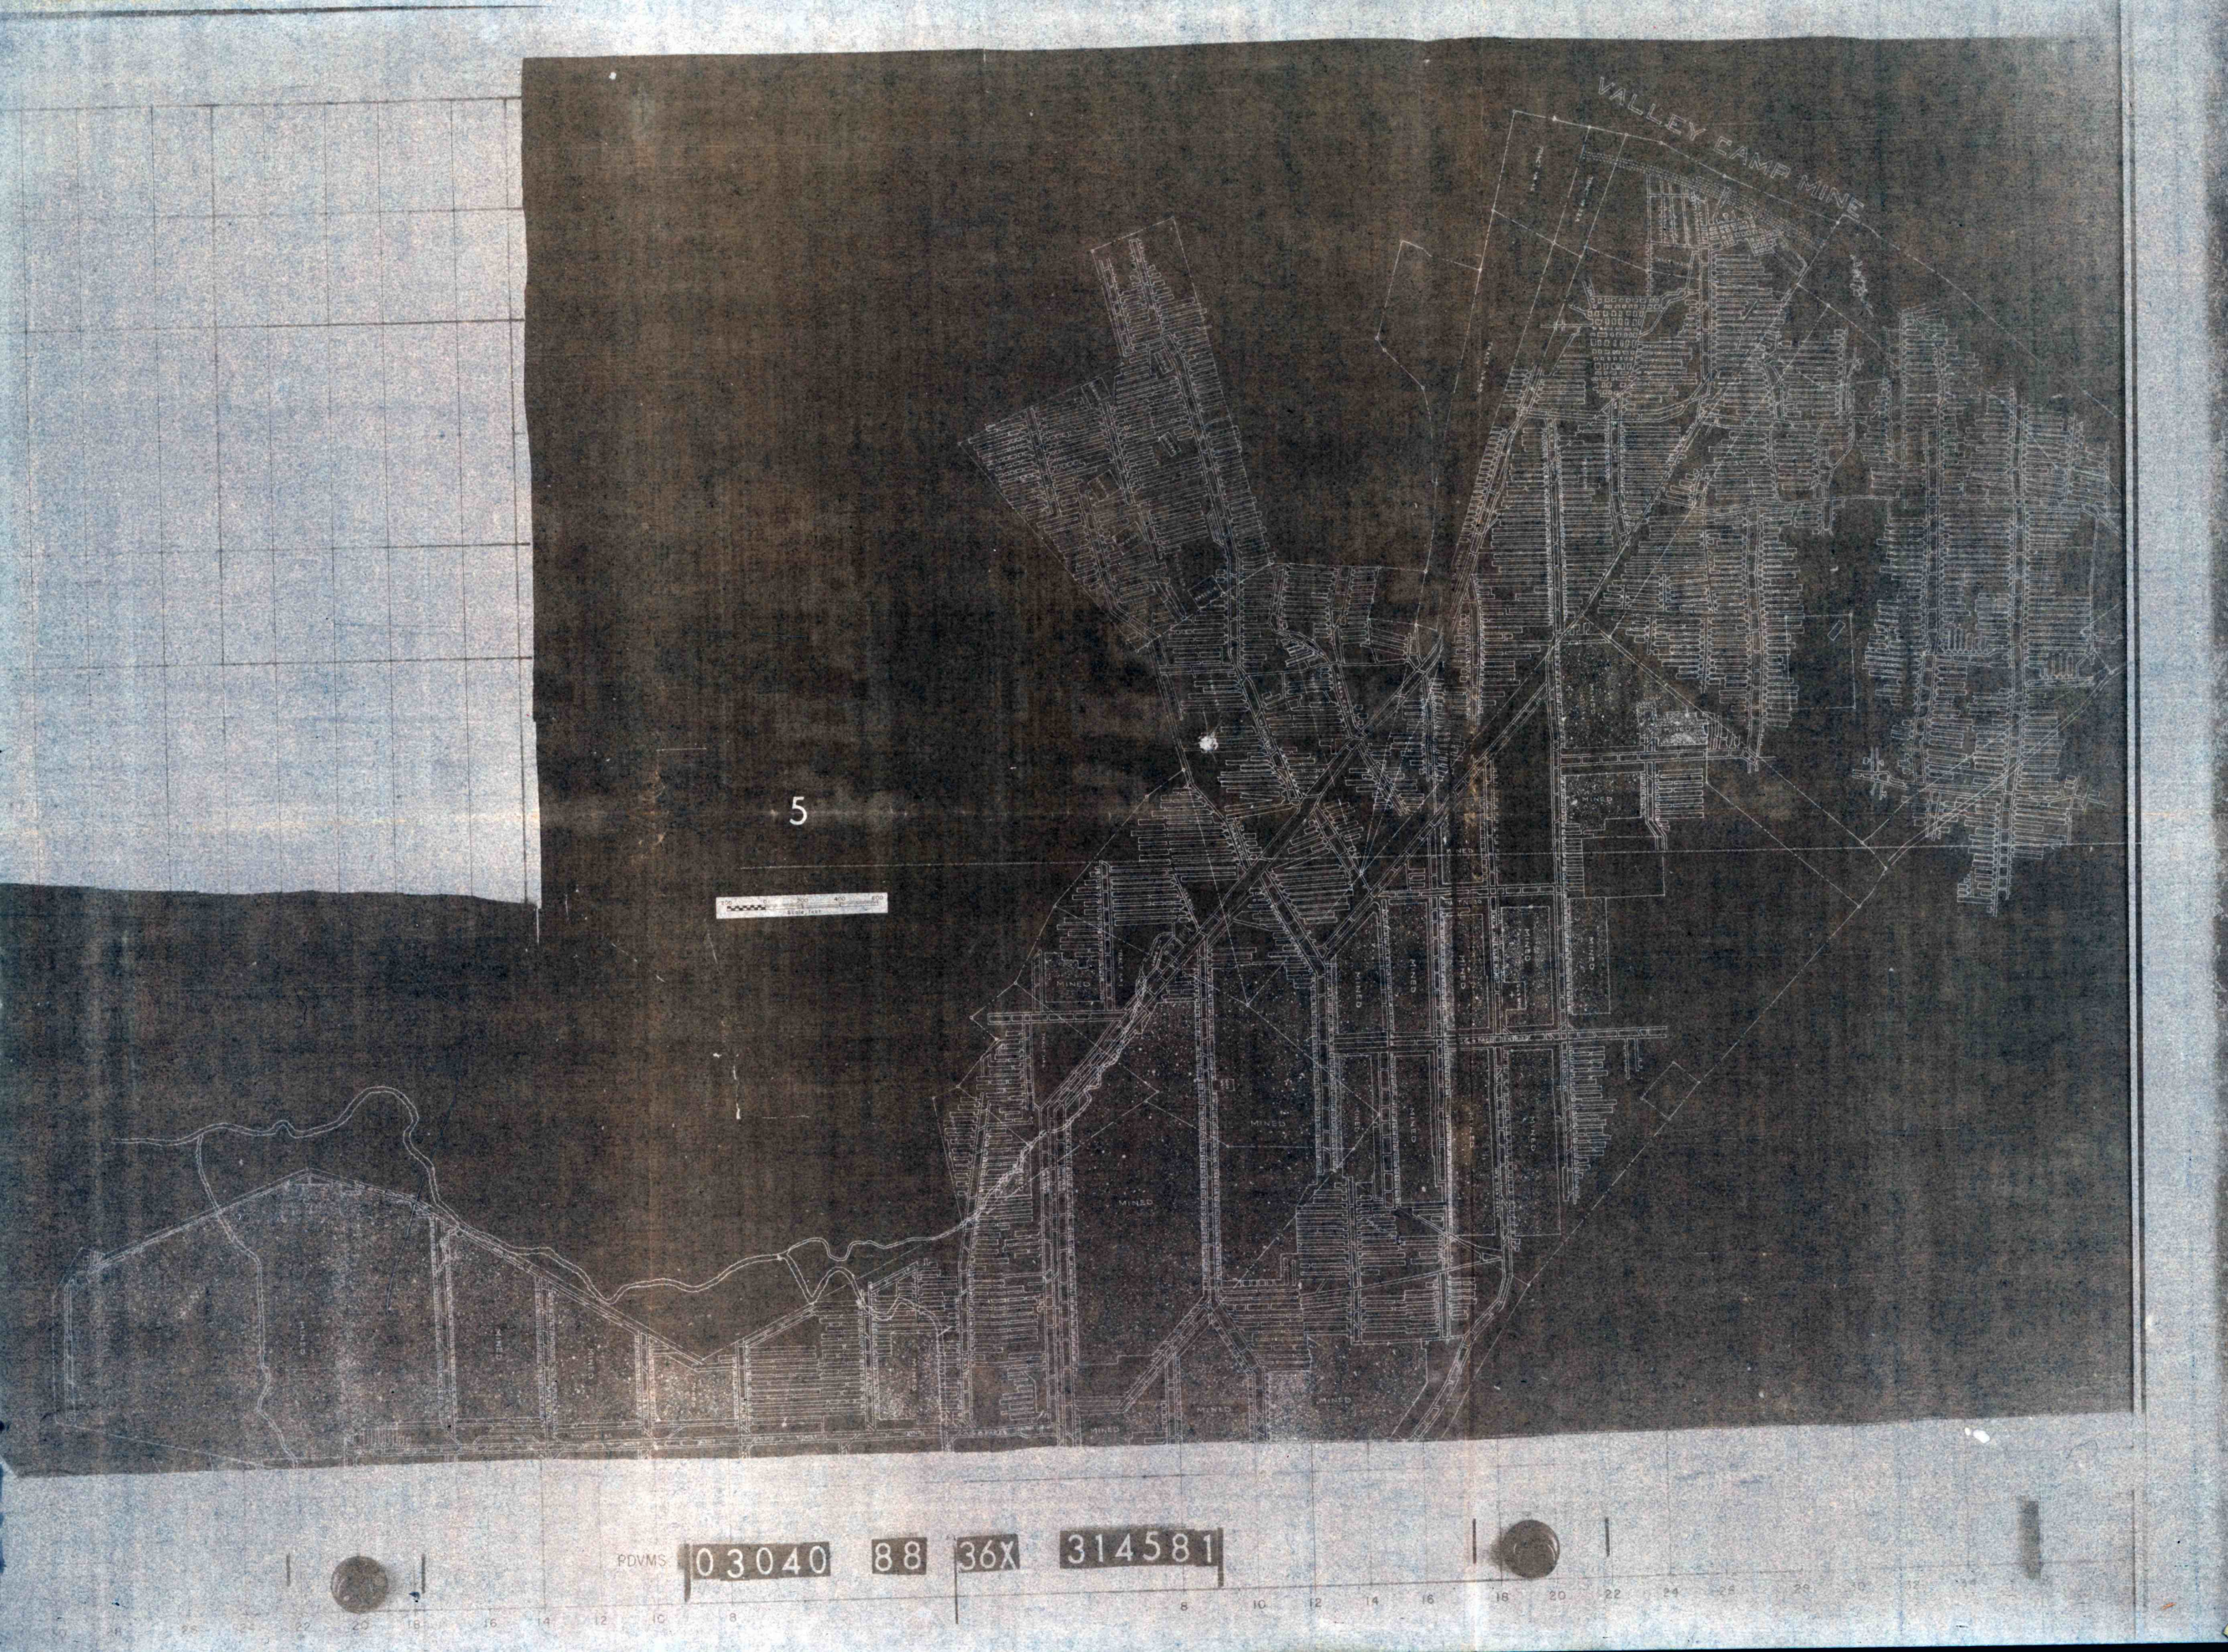

VALLEY CAMP MINE

5



PDVMS 03040 88 36X 314581

