


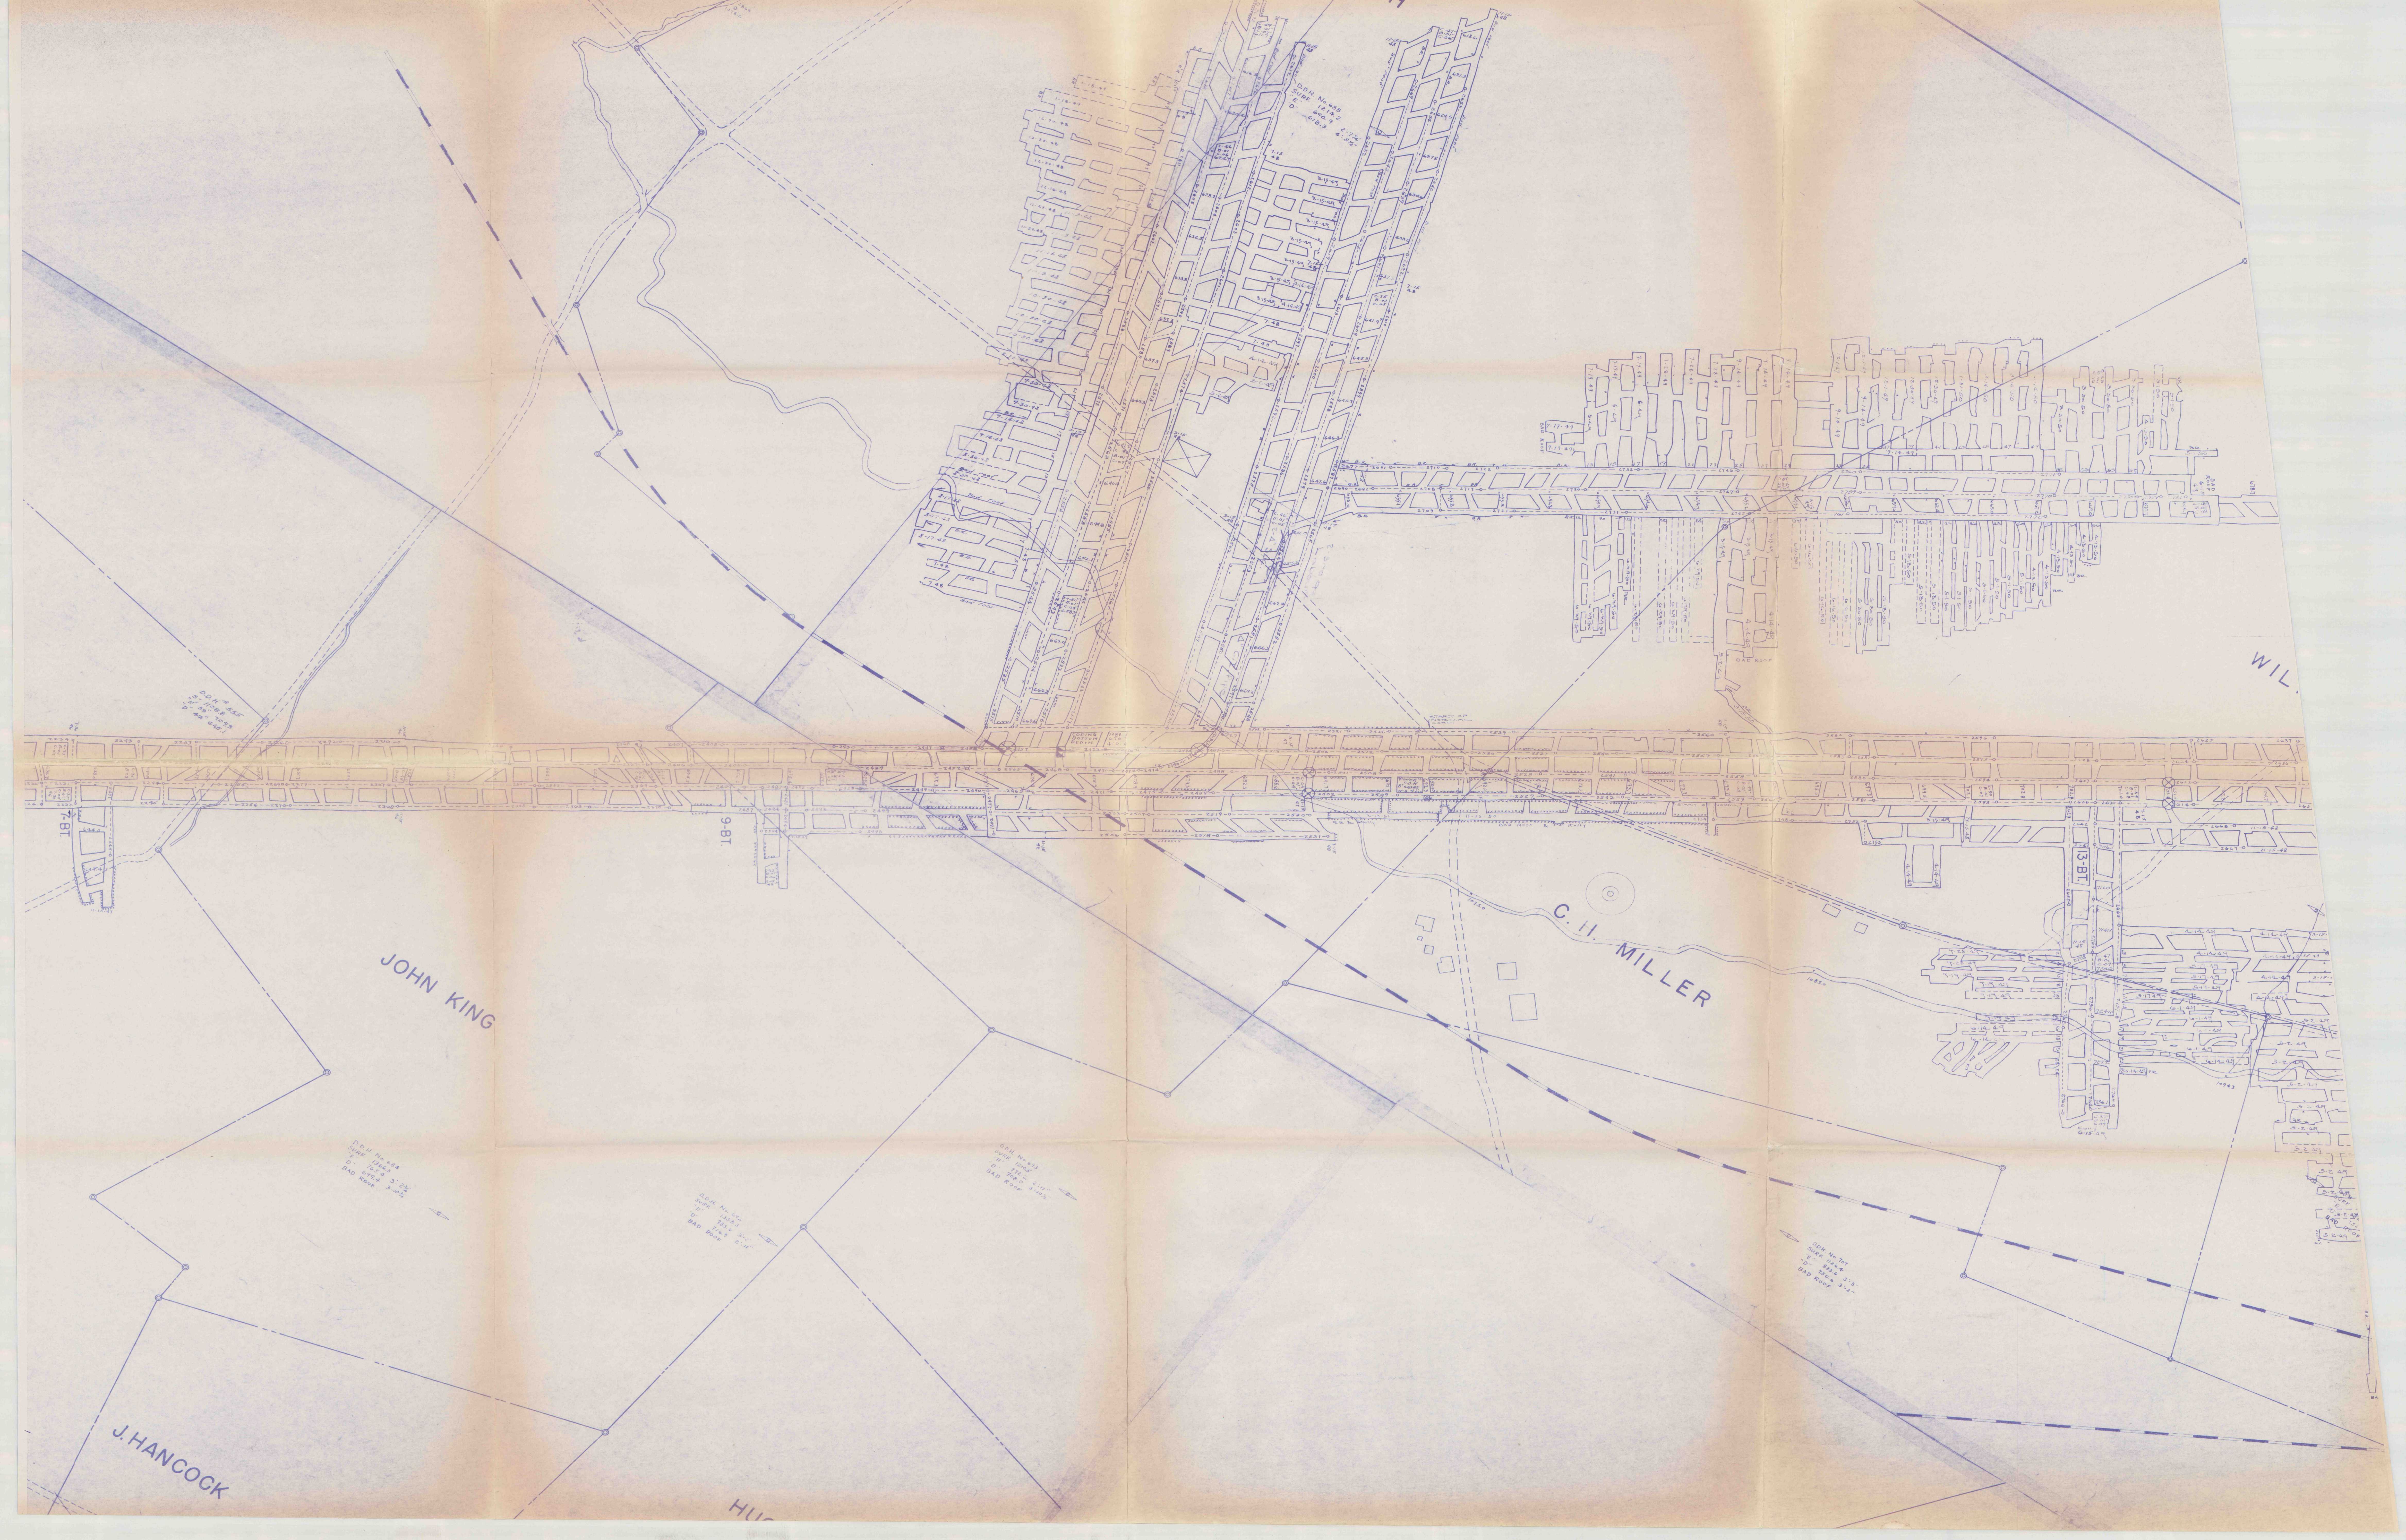

JOHN KING

J. HANCOCK

C. H. MILLER

WIL

D.D.H. No. 448
CUM. 124.3
D. 124.3
BAD ROOF



