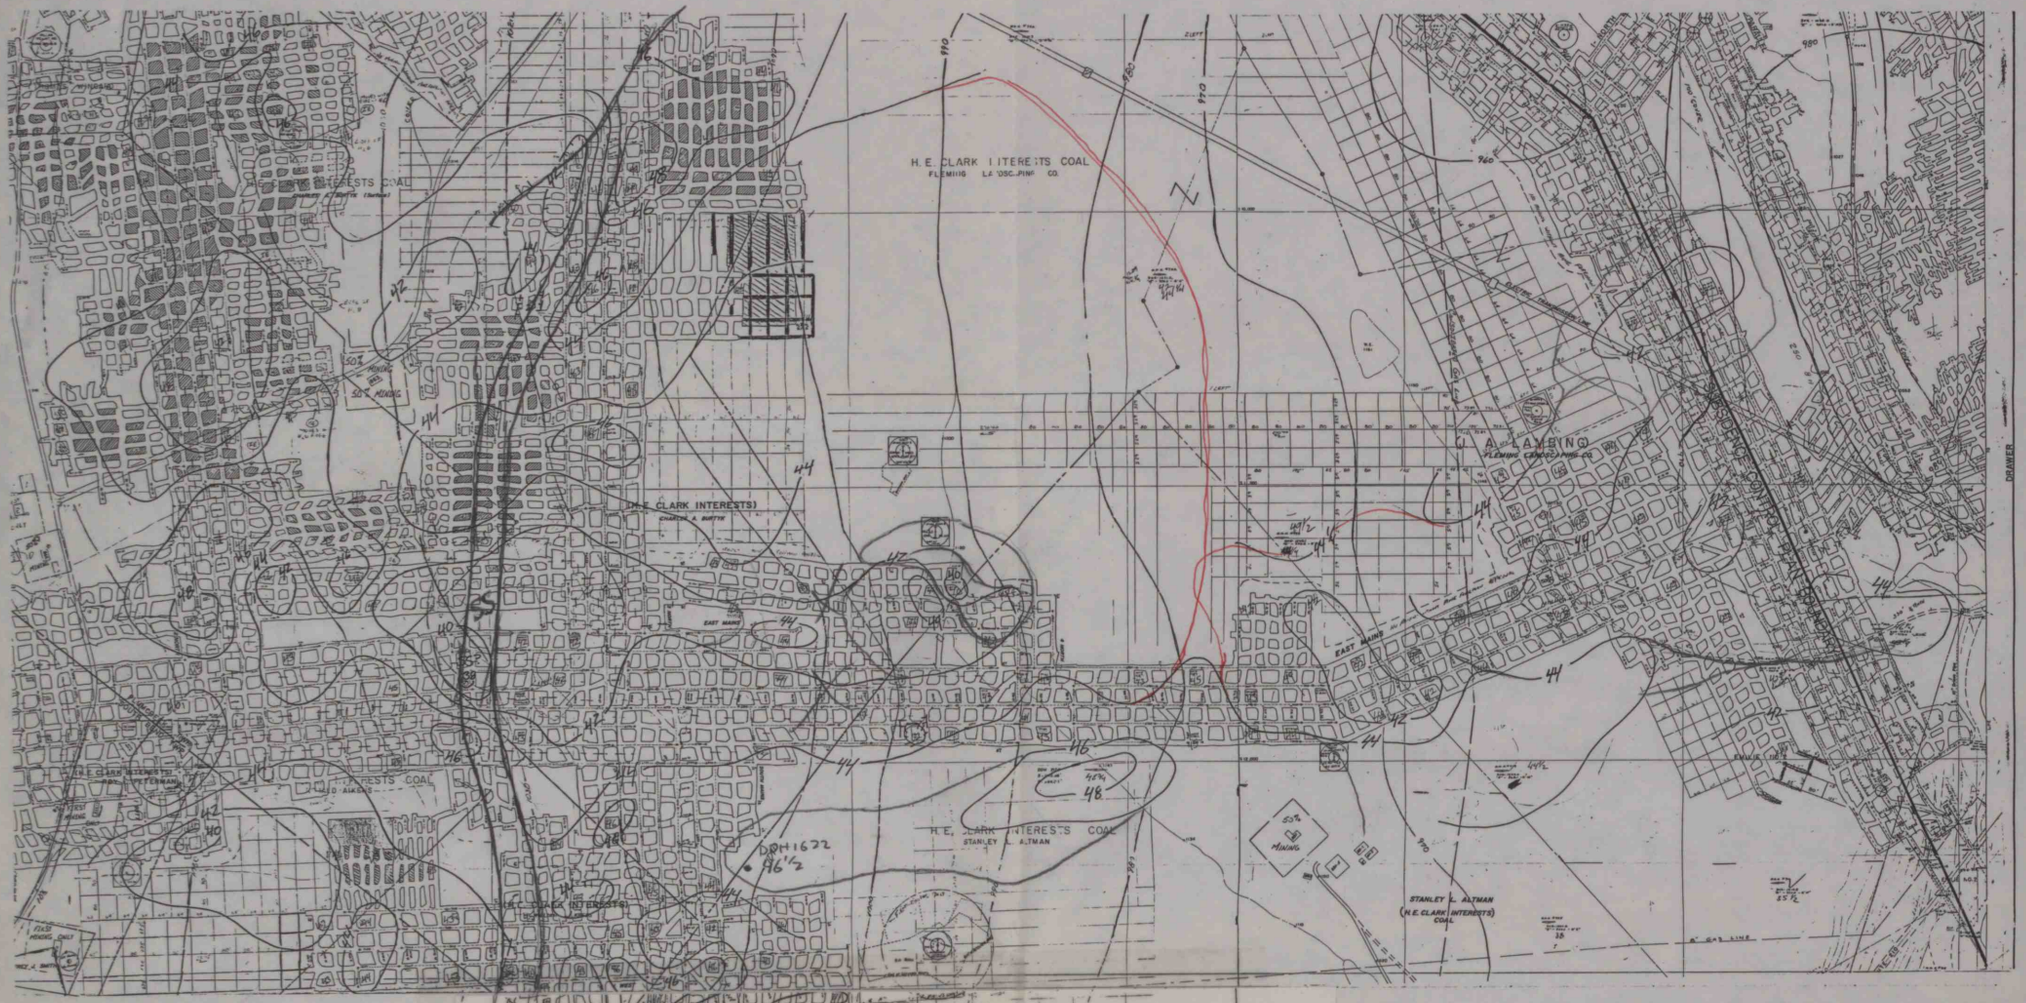

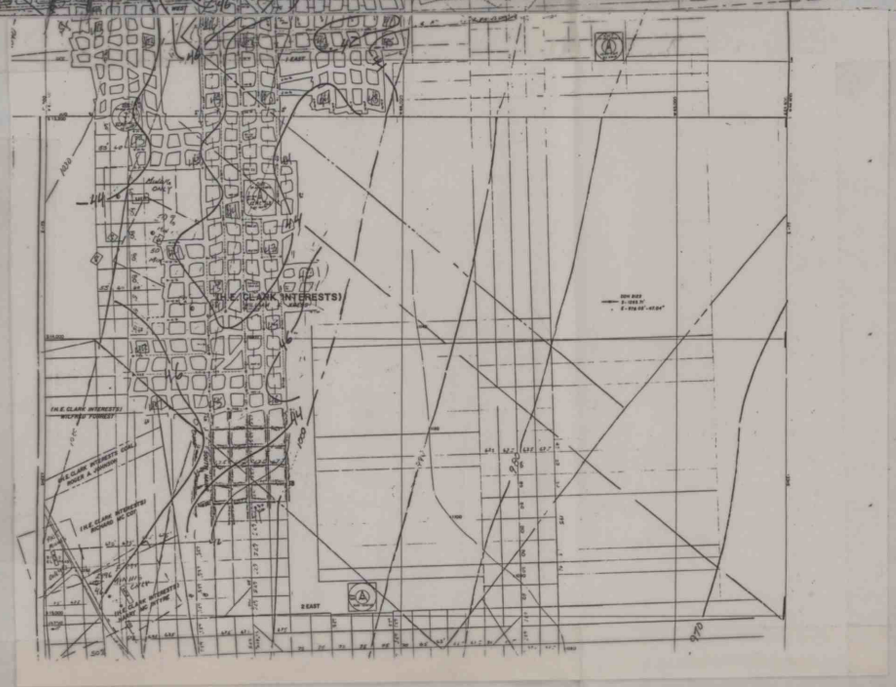

1" = 400'

THR 8-5 - Lunchroom

MADE CHANGES

IMAPS 17694