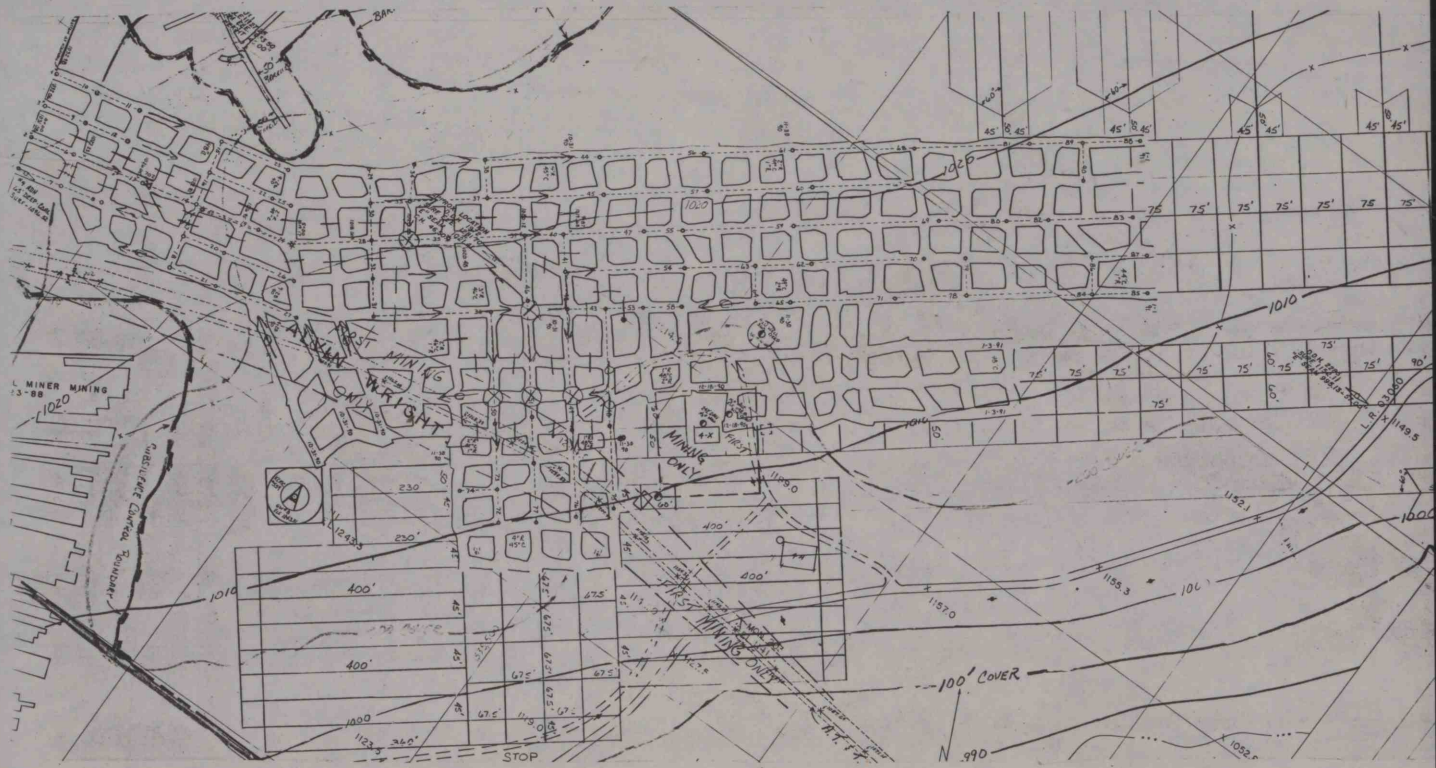
MINING ONLY
FIRST MINING ONLY
MINING ONLY
100' COVER
STOP
N 990
1010
1020
1000
L.R. 51060

IMAPS# 17698