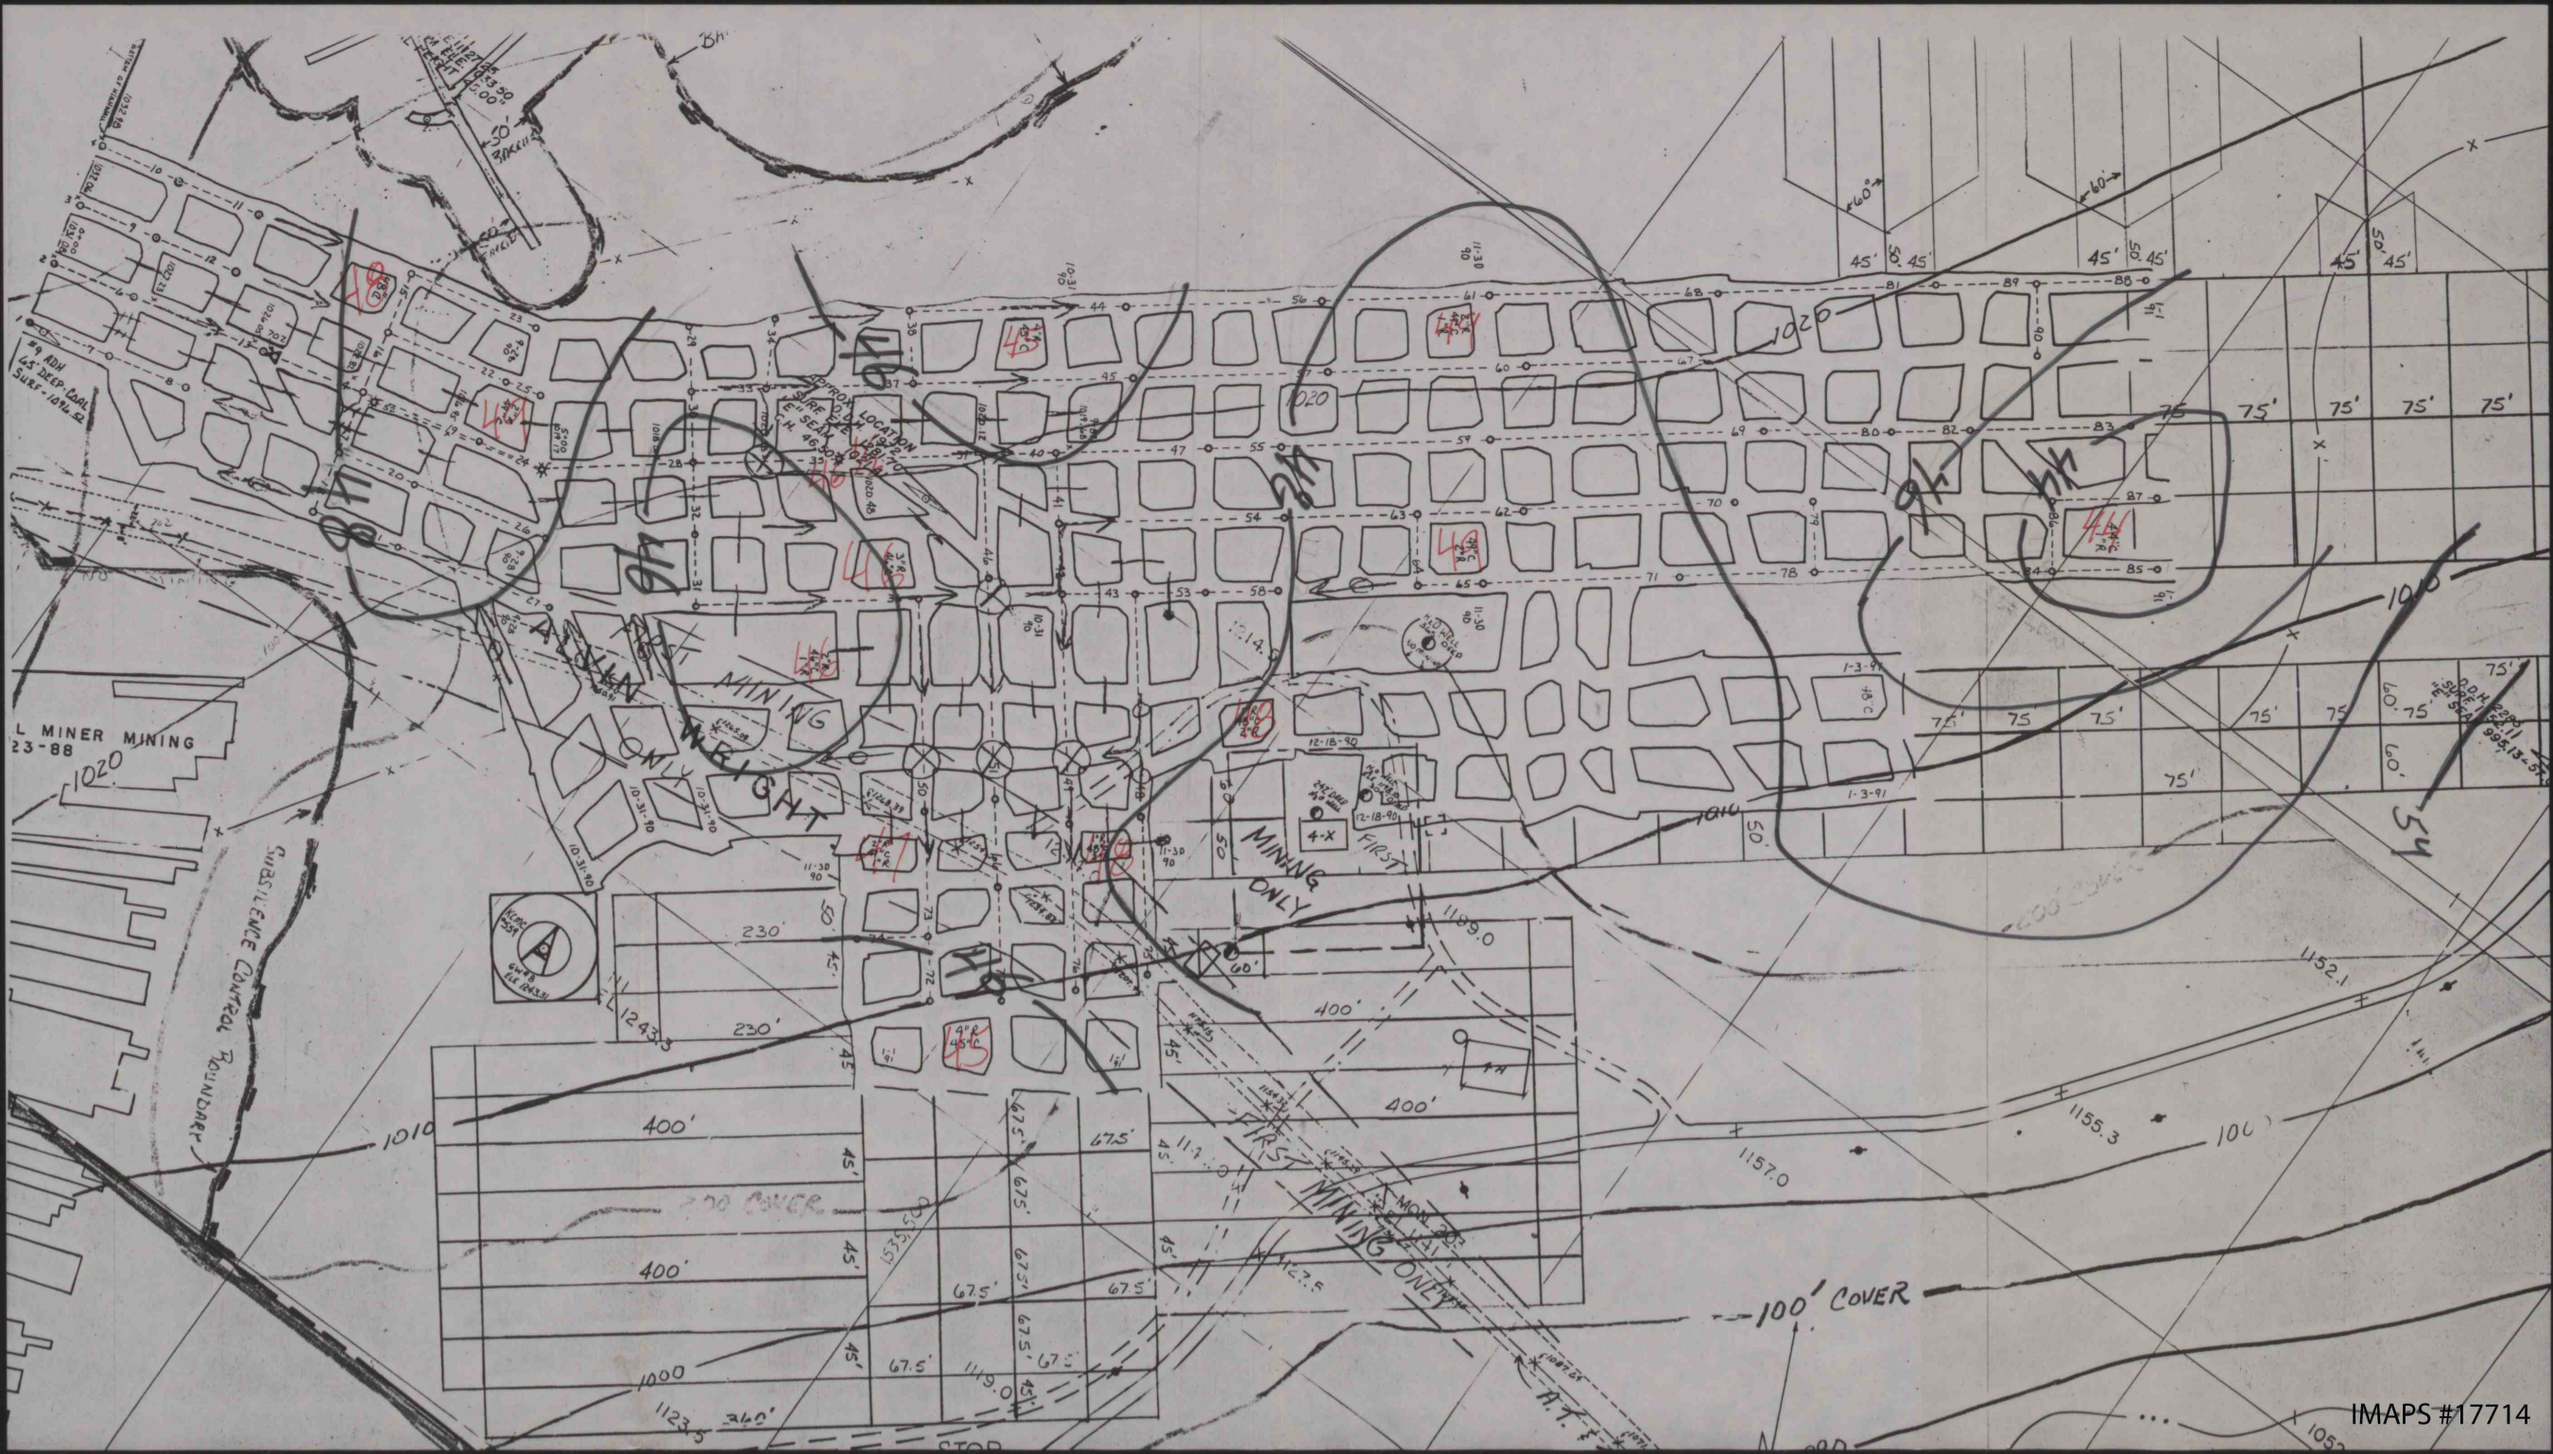
MINING ONLY
WEIGHT
FIRST
MINING ONLY
FIRST
MINING ONLY
SUBSIDENCE CONTROL BOUNDARY
100' COVER
L MINER MINING
23-88
1020
1010
1000
1152.1
1155.3
1157.0
1119.0
1123.5
1243.3
400'
230'
360'
45'
75'
60'
50'
STOP

IMAPS #17714