


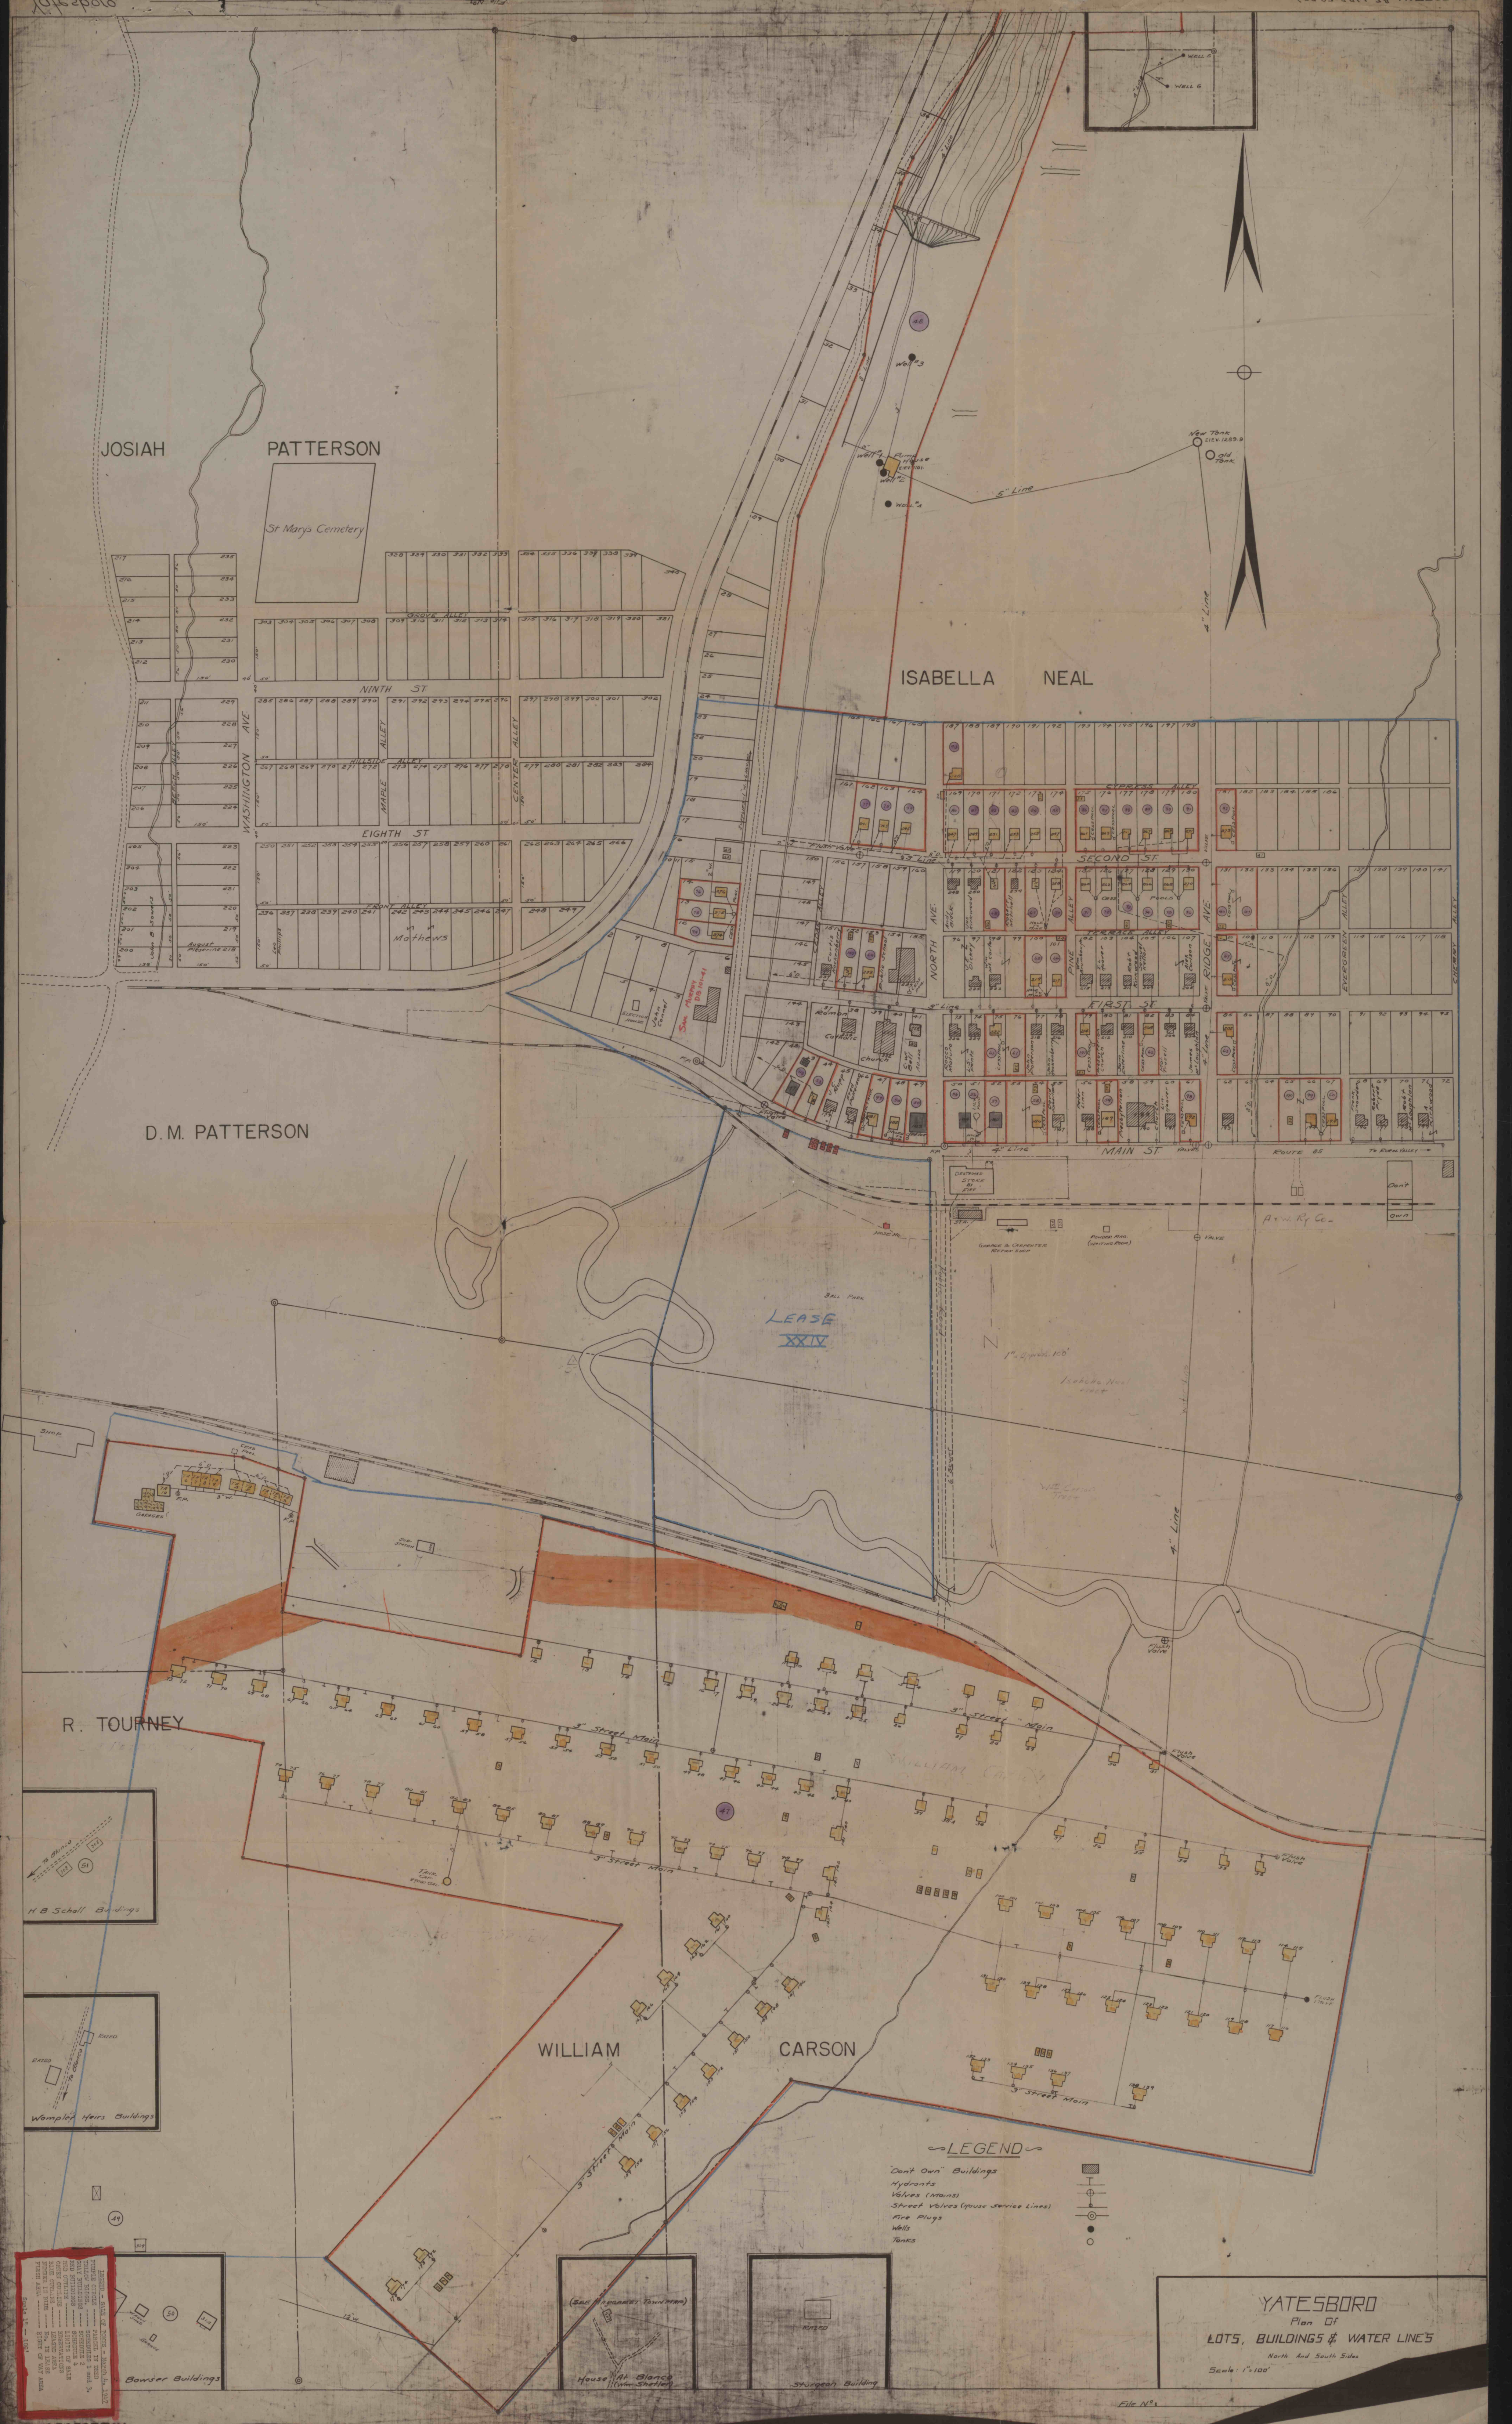


YATESBORO
Plan of
LOTS, BUILDINGS & WATER LINES
North and South Sides

Scale: 1"=100'

LEGEND

- Don't Own Buildings
- Hydrants
- Valves (Mains)
- Street Valves (House Service Lines)
- Fire Plugs
- Wells
- Tanks

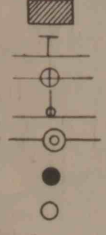

WILLIAM

CARSON

R. TOURNEY

D.M. PATTERSON

ISABELLA NEAL




JOSIAH

PATTERSON

St Marys Cemetery

Mathews

LEASE
XXIV

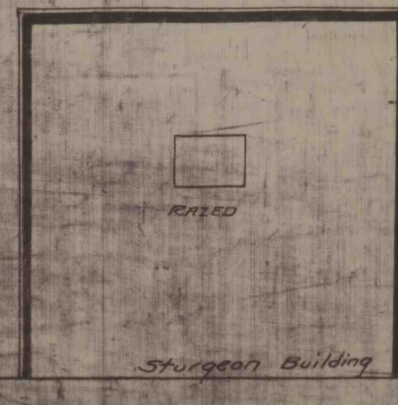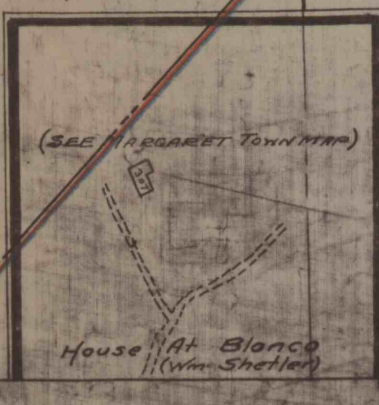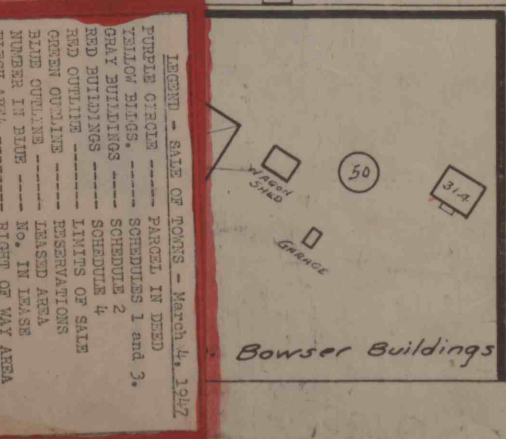

File No.