


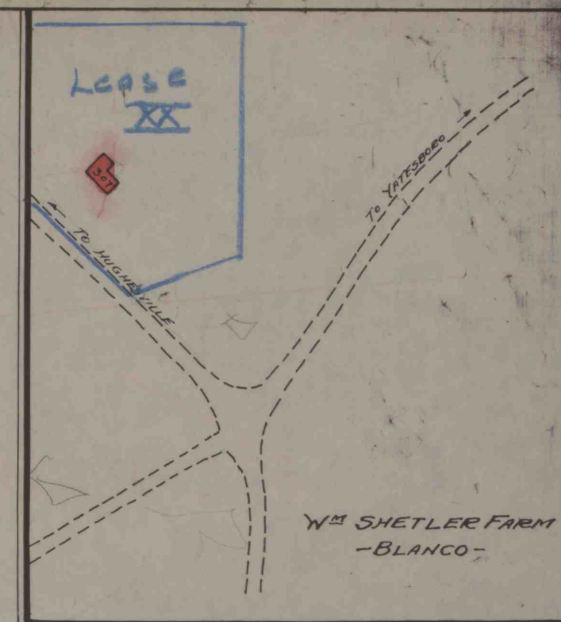

MOSES BEER HRS.

JACOB BOYER

ANN M. SOWERS

HENRY SOWERS

J. M. DUNMIRE

TOWN PLAN
AND
WATER SYSTEM
MARGARET
COWANSHANNOCK TWP. ARMSTRONG CO.
SCALE 1" = 100' JAN. 1936

IMAPS # 17731

622-97-714-A