



ERNEST

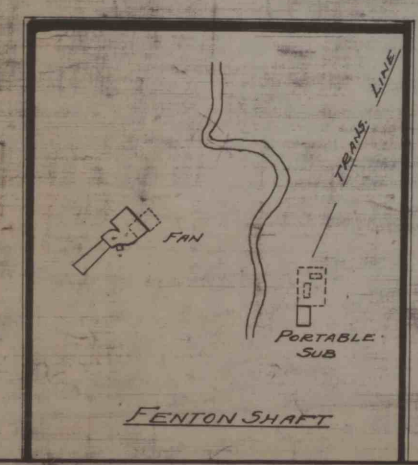


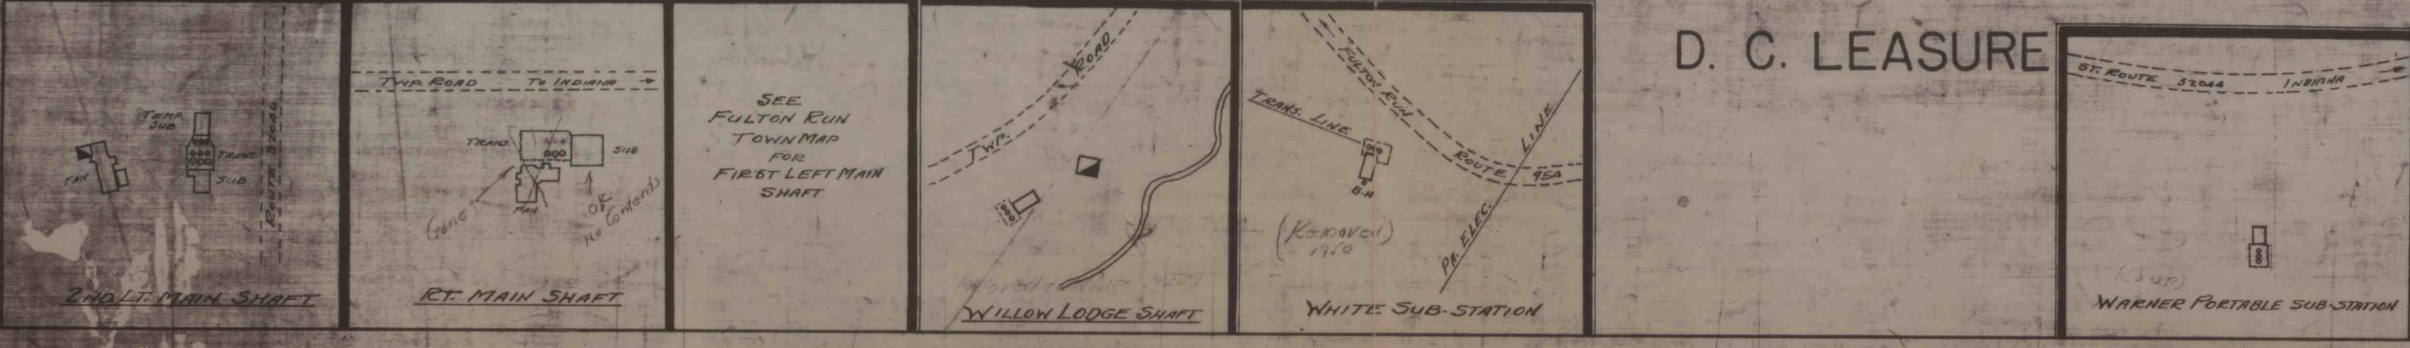

TOWN PLAN
AND
WATER SYSTEM
ERNEST
ENGINEERING & SURVEYING CO.
SCALE 1" = 100'
ERNEST
I. MAPS # 12749