
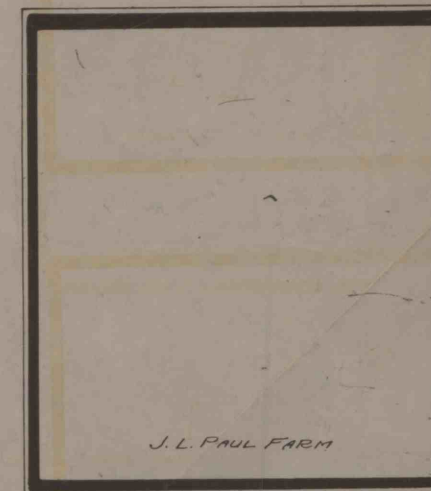
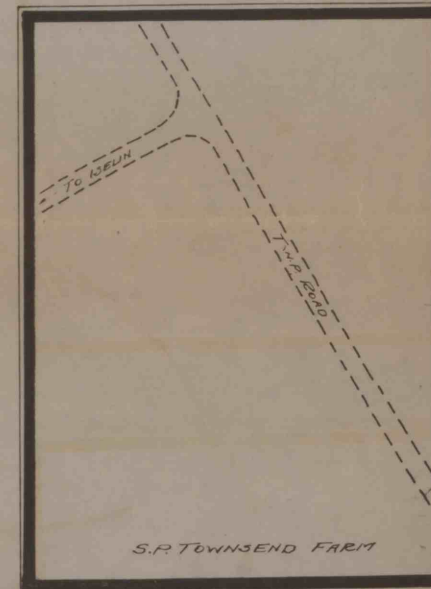
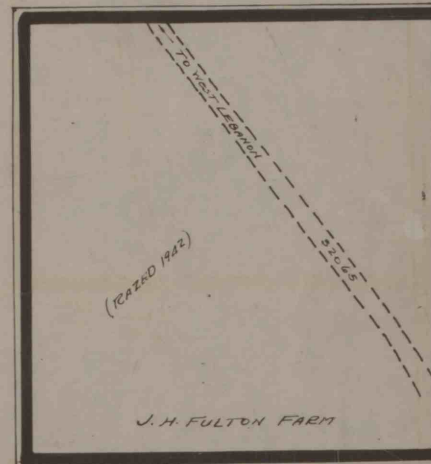
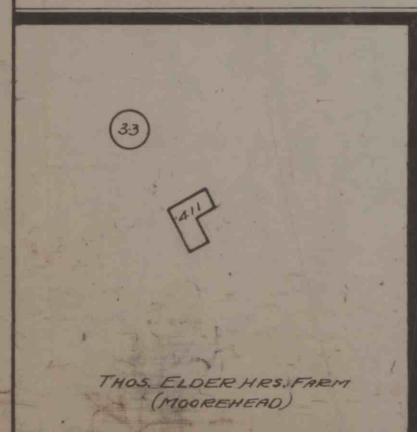
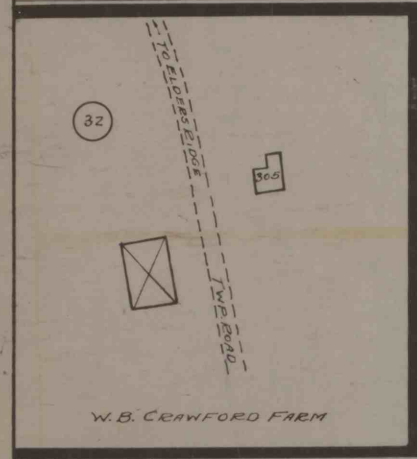
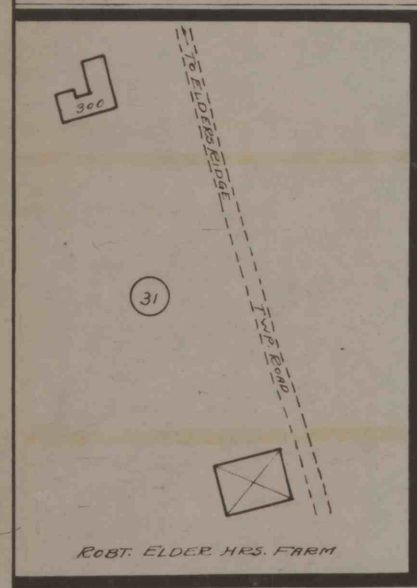
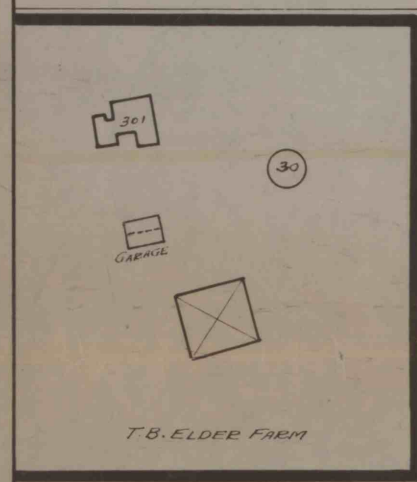
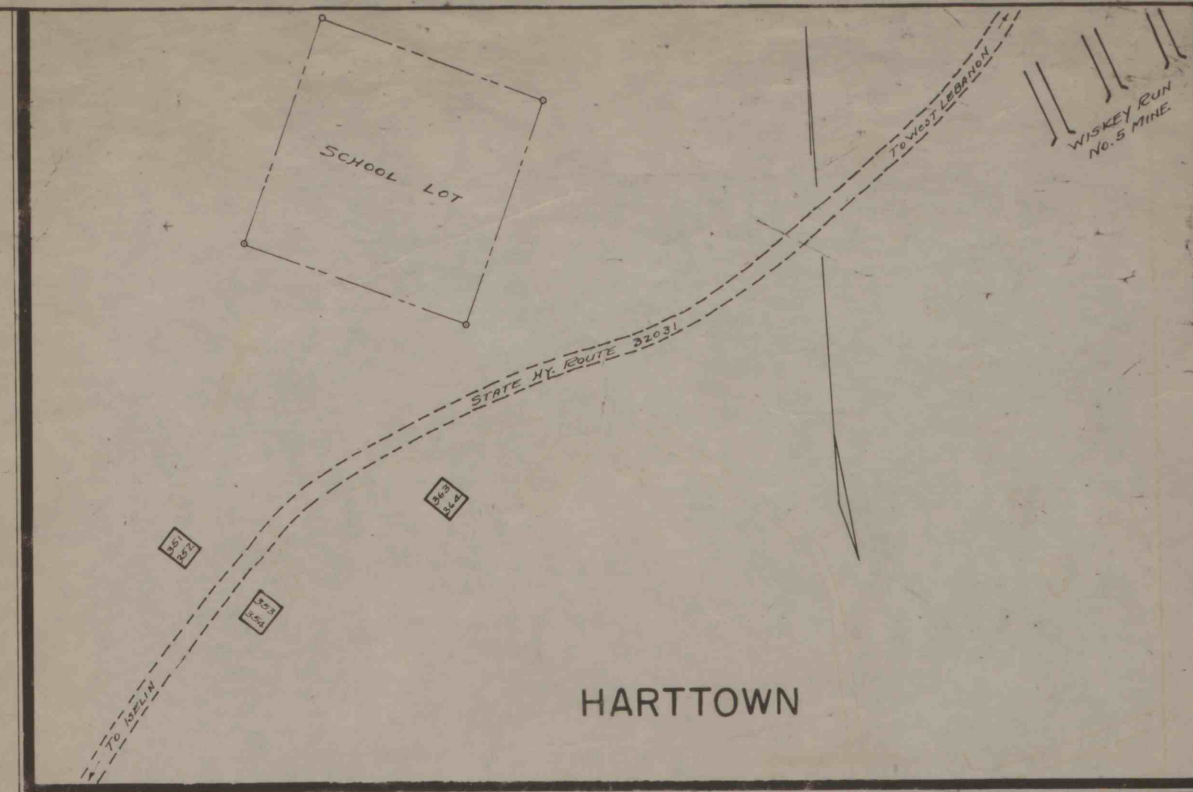
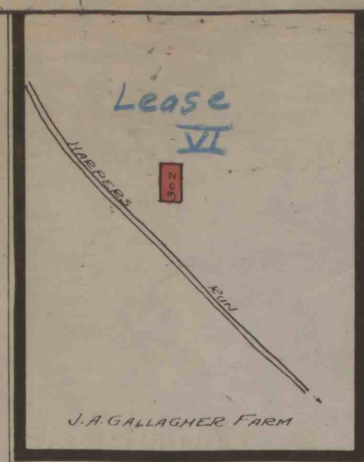


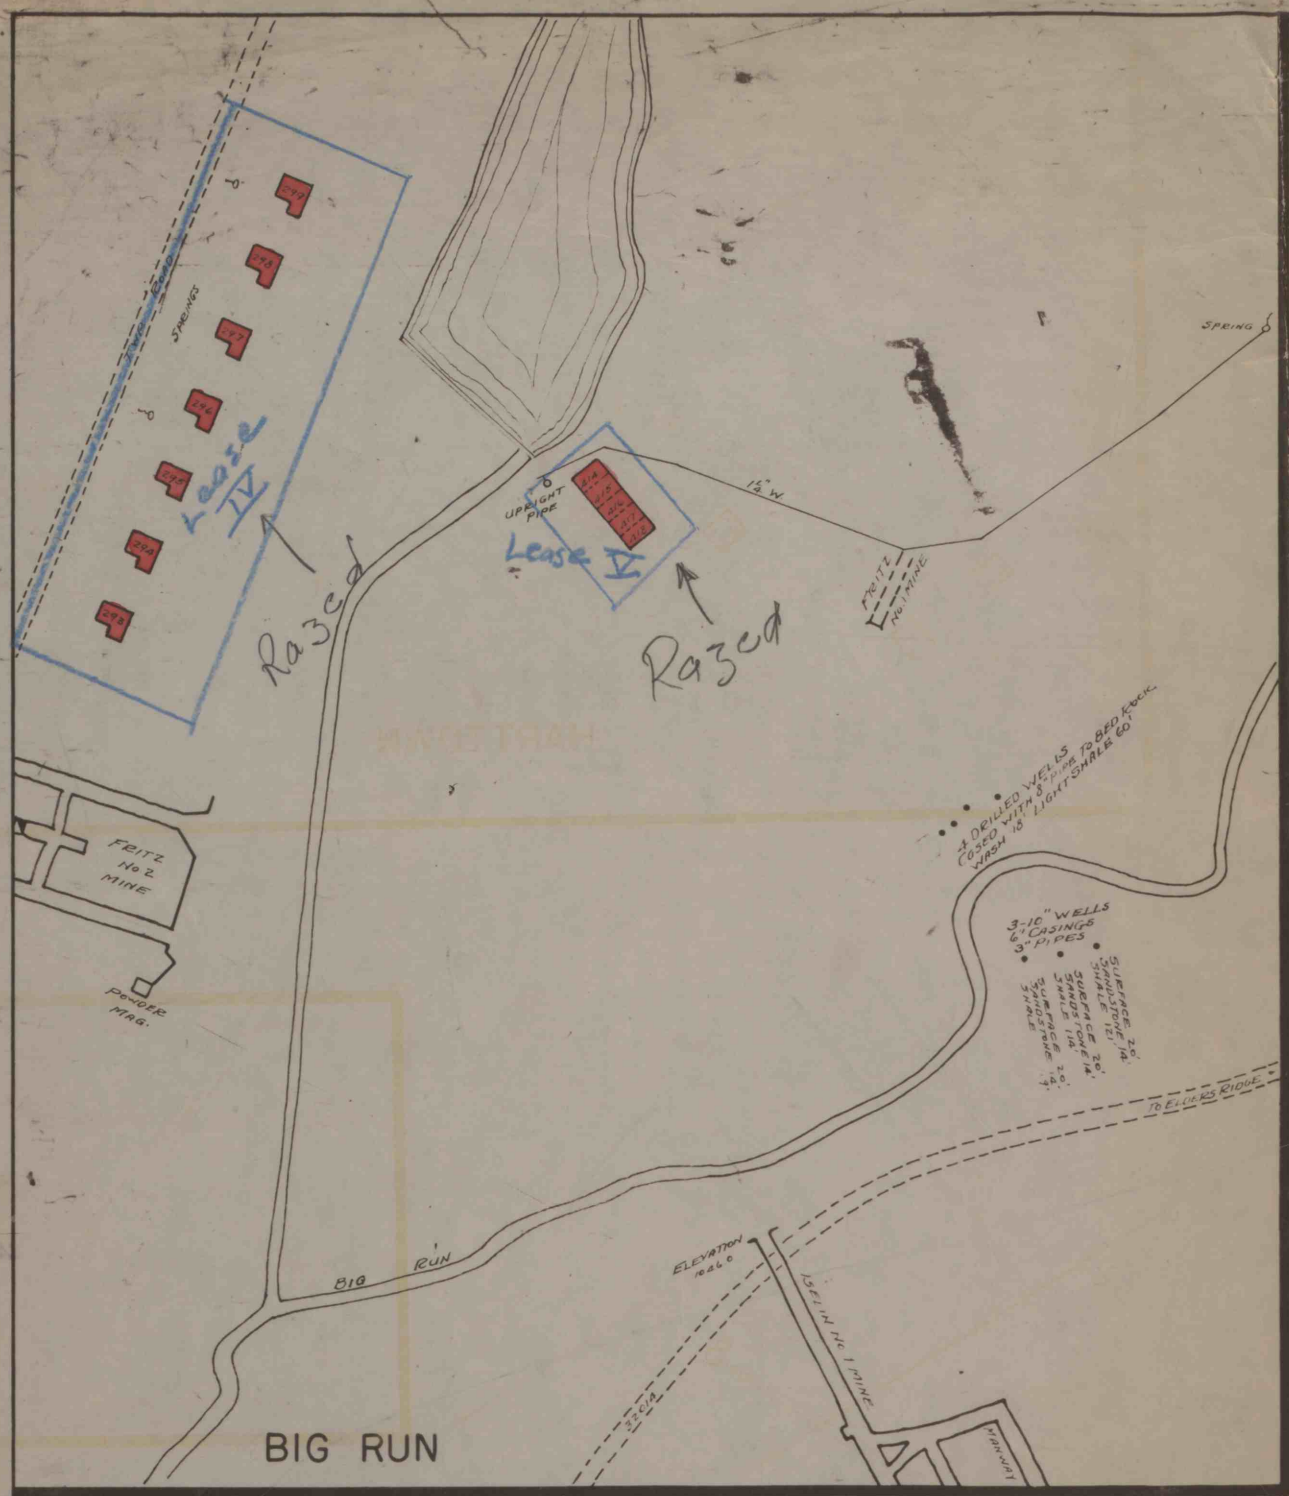

LEGEND - SALE OF TOWNS - March 4, 1907
 PURPLE CIRCLE - PARCEL IN DEED
 YELLOW TRIANGLE - SCHEDULES 1 and 3
 GRAY BUILDINGS - SCHEDULE 2
 RED BUILDINGS - SCHEDULE 4
 RED OUTLINES - LIMITS OF SALE
 GREEN OUTLINES - RESERVATIONS
 BLUE OUTLINES - LEASED AREA
 NUMBER IN BLUE - NO. IN LEASE
 FISH AREA - RIGHT OF WAY AREA
 Scale 1" = 100'

TOWN PLAN
 AND
 WATER SYSTEM
 LEBELIN-BIG RUN & HARTTOWN
 YOUNG TOWNS
 INDIANA CO.
 JAN 1938