


28910

Latitude 40°30'00"

Longitude 78°57'30"

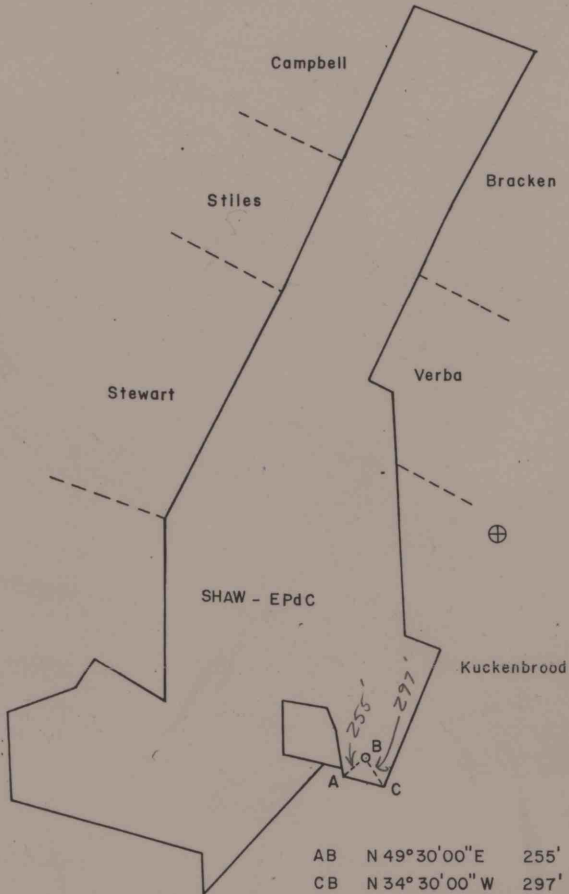

- New Location ☒
 Drill Deeper ☐
 Abandonment ☐
 Re-drill ☐

AB N 49°30'00"E 255'
 CB N 34°30'00"W 297'

Company ENERGY PRODUCTION COMPANY
 Address P.O. BOX 500, LAWRENCE, PA. 15055
 Farm SHAW HEIRS & ENERGY PRODUCTION CO.
 Tract _____ Acres 297 Lease No. _____
 Well (Farm) No. 5 Co. Serial No. _____
 Angle of Deviation, if any _____
 Elevation 1505 Quadrangle VINTONDALE
 County INDIANA Township BUFFINGTON
 Engineer D. MICHAEL CANADA
 Engineer's Registration No. 29272
 File No. _____ Drawing No. _____
 Date JUNE 16, 1983 Scale 1"=1000'

COMMONWEALTH OF PENNSYLVANIA
 DEPARTMENT OF MINES

Oil and Gas Division
 HARRISBURG

WELL LOCATION MAP
 Dept. File No. _____

⊕ Denotes Values of Well on United
 States Topographic Maps

Scale 15' ☐ ☒

WORKABLE COAL SEAMS TO BE PENETRATED

Name of Seam Owner of Seam

"B" ROCHESTER & PITTSBURGH COAL

REMAINING CAUFFIEL BROTHERS

IMAPS #17836

IND-27606