
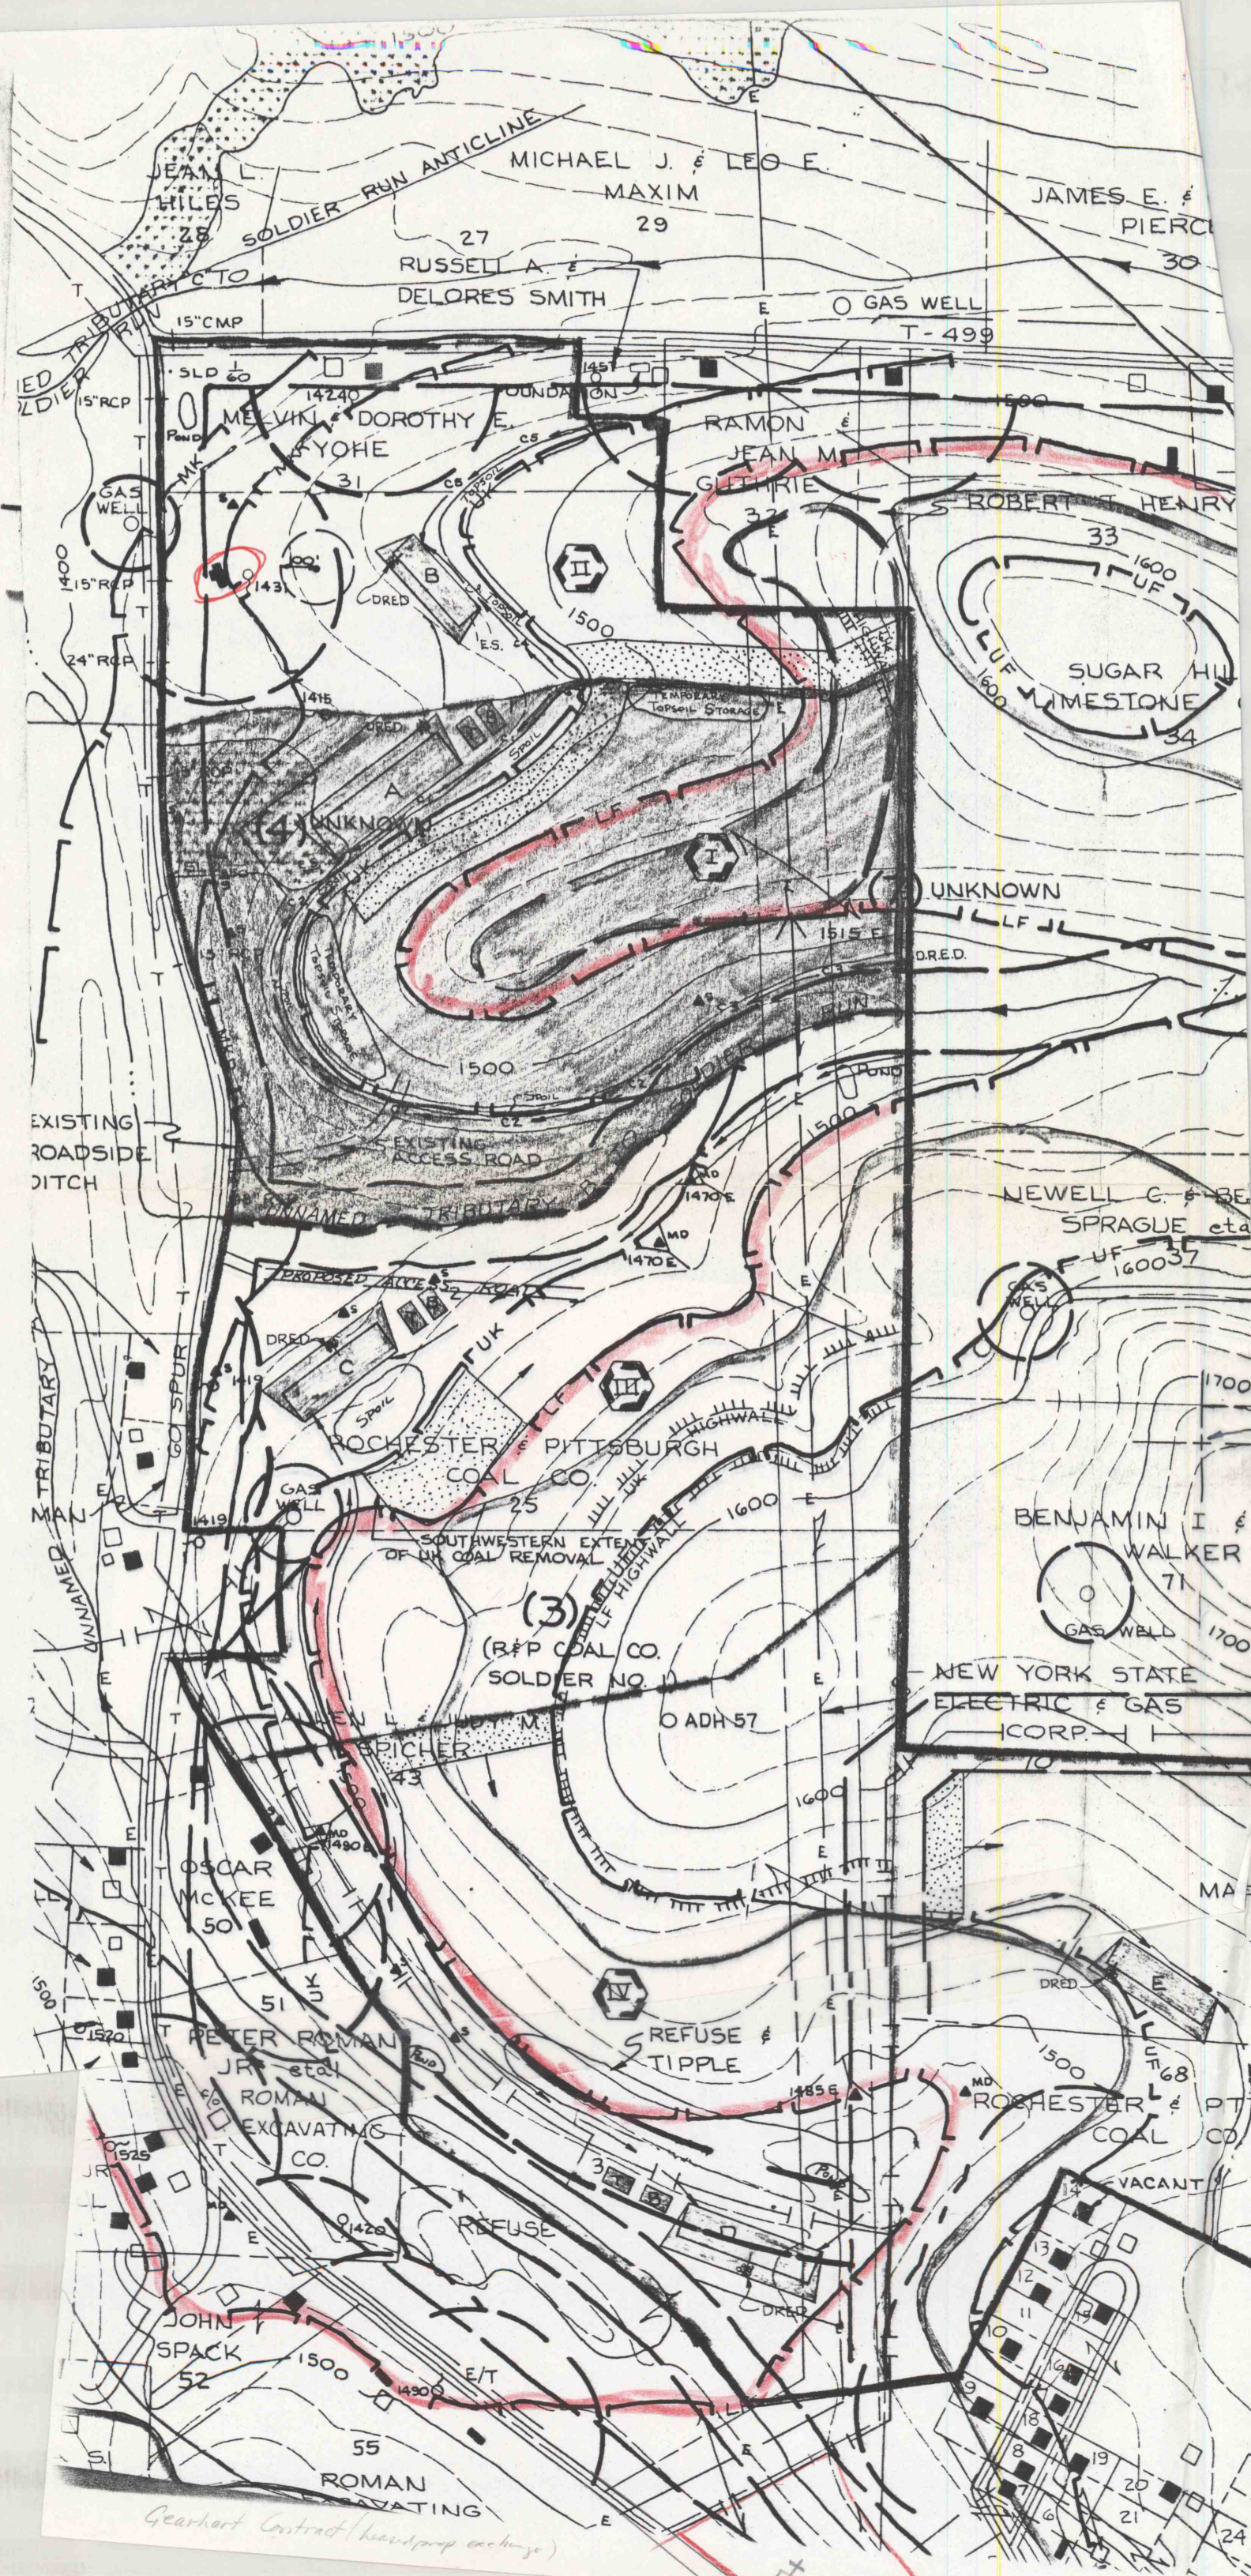


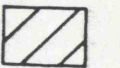

GEARHART PERMIT
ADJOINING WILSON 7

-  ARE
UND
-  STAC
-  STAC
-  STAC

1. ANG
2. DOM
3. VIV
4. ART
5. ROE
6. THO
7. SO
8. PET
9. HEL
10. CL
11. P
12. JA
13. ST
14. WI
15. AN
16. AL
17. RI
18. MA
19. W
20. E