


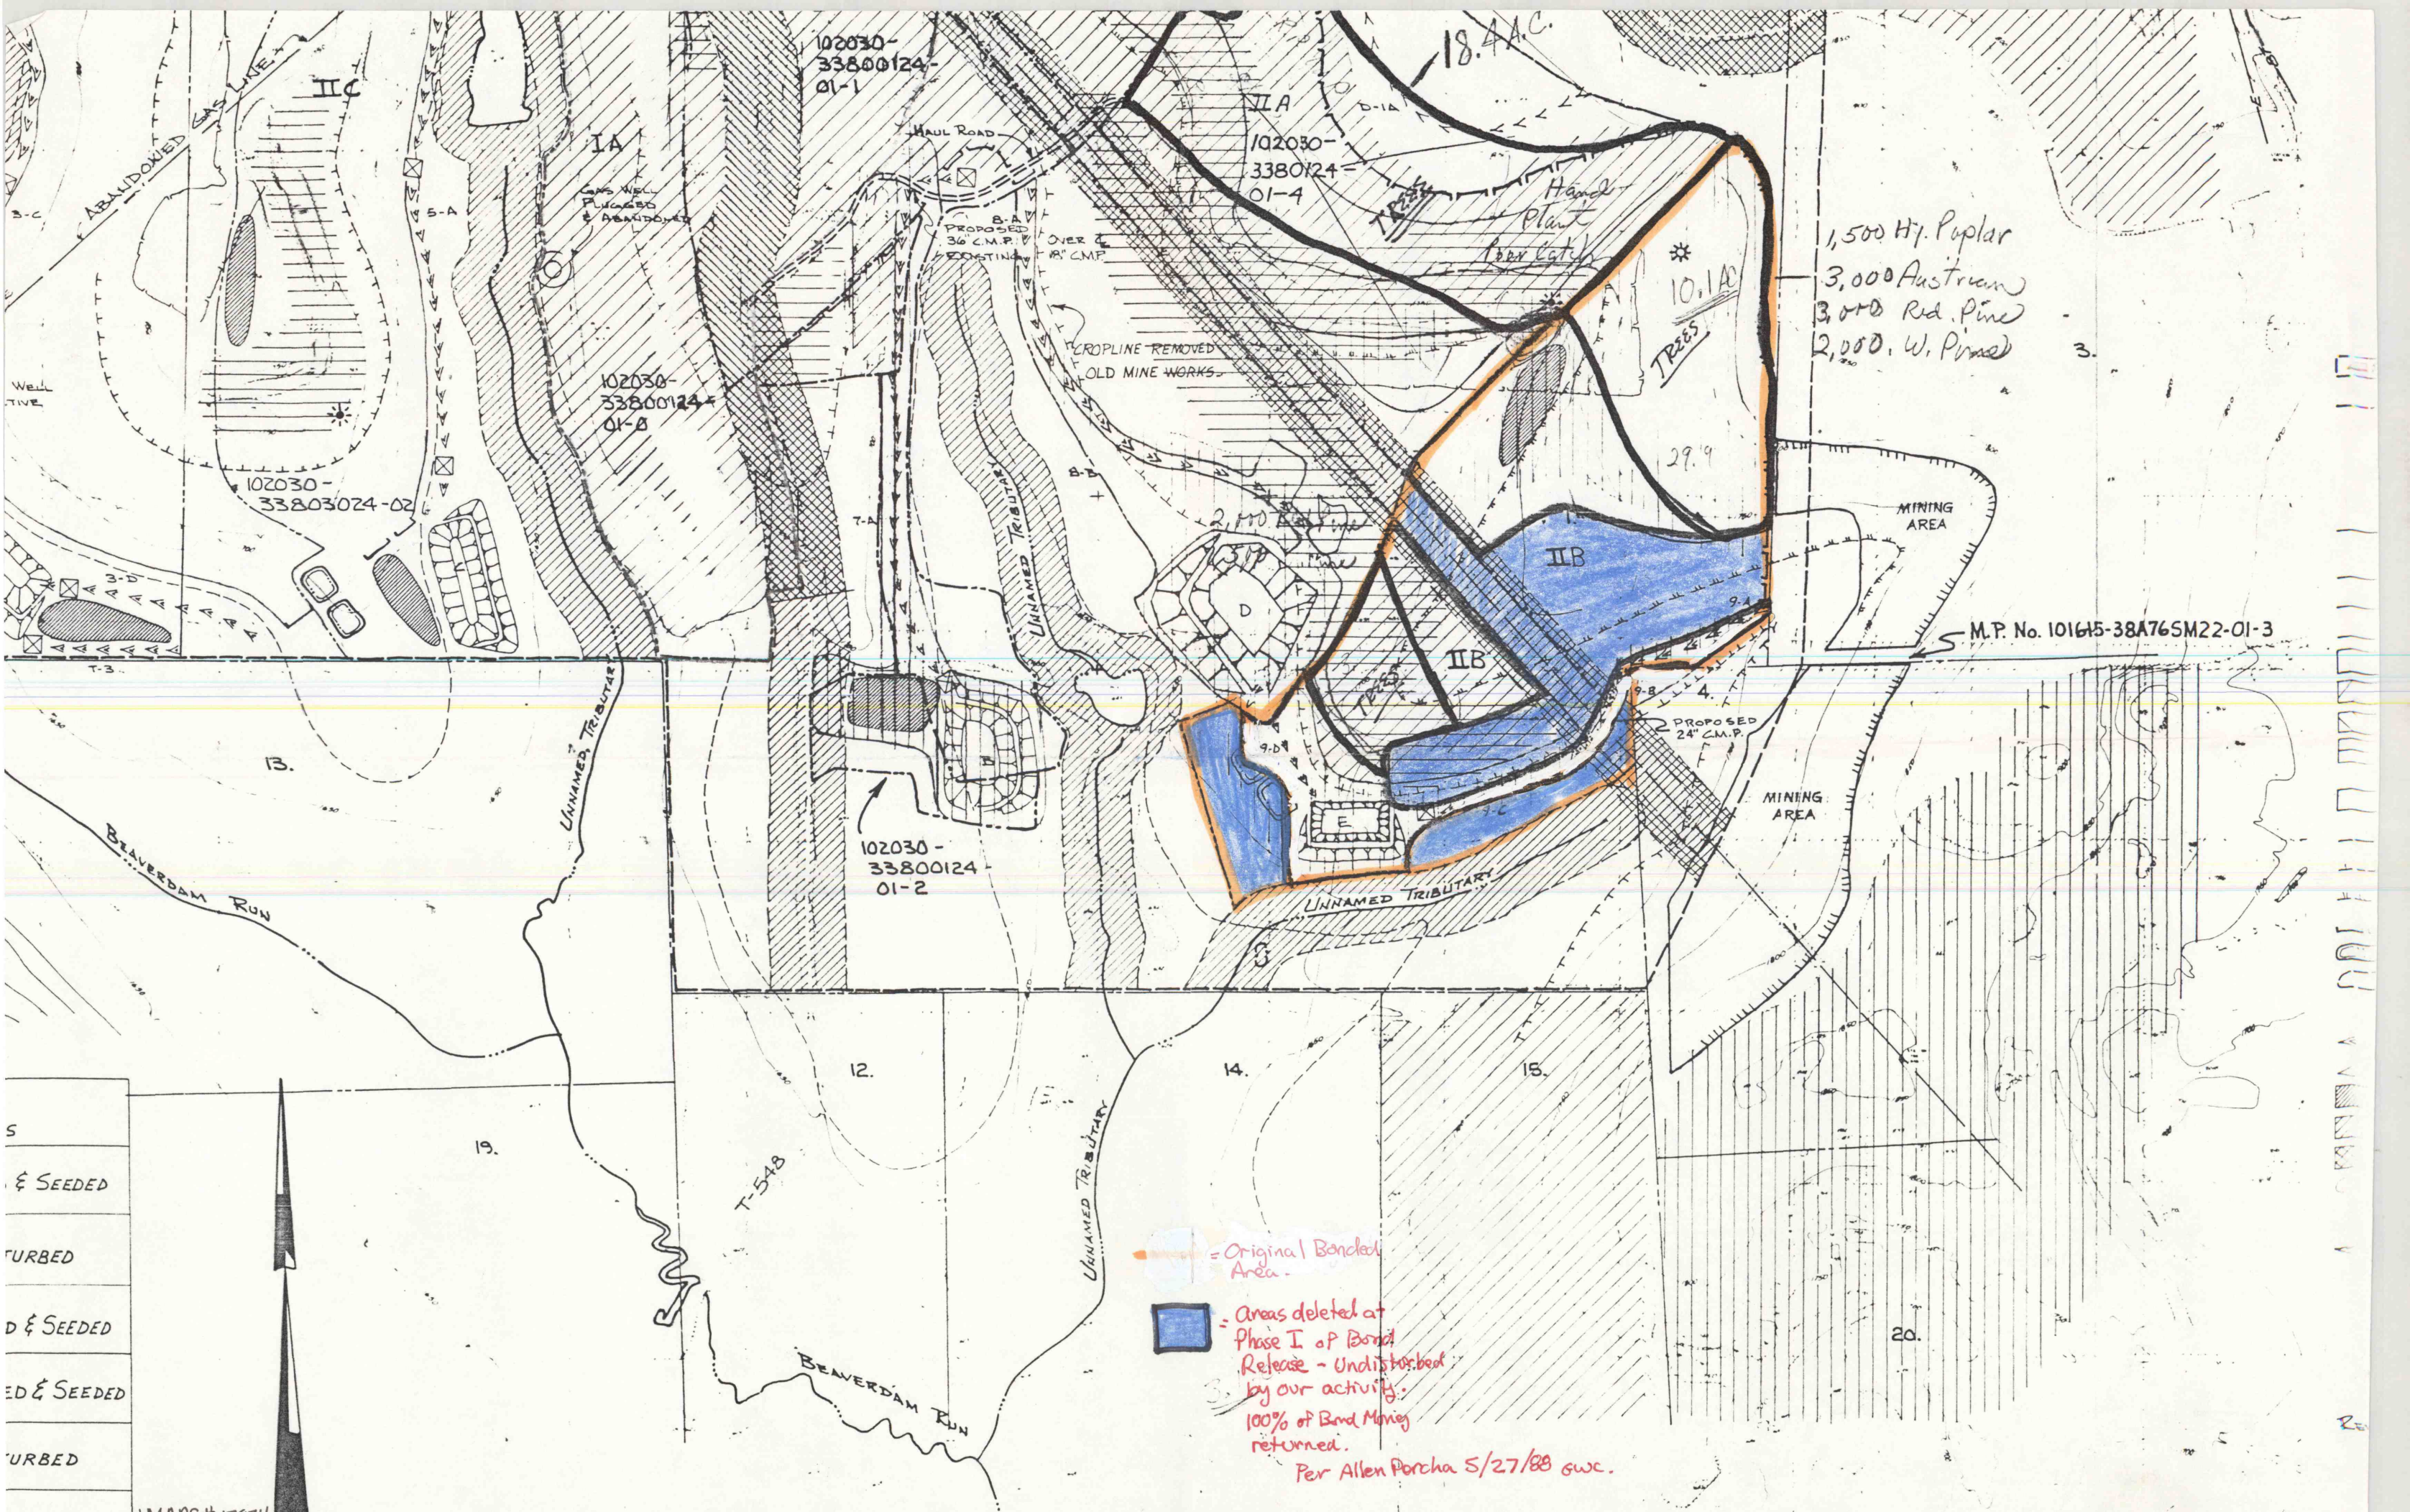

 = Original Bonded Area.

 = Areas deleted at Phase I of Bond Release - Undisturbed by our activity. 100% of Bond Money returned.

Per Allen Porcha 5/27/88 gwc.