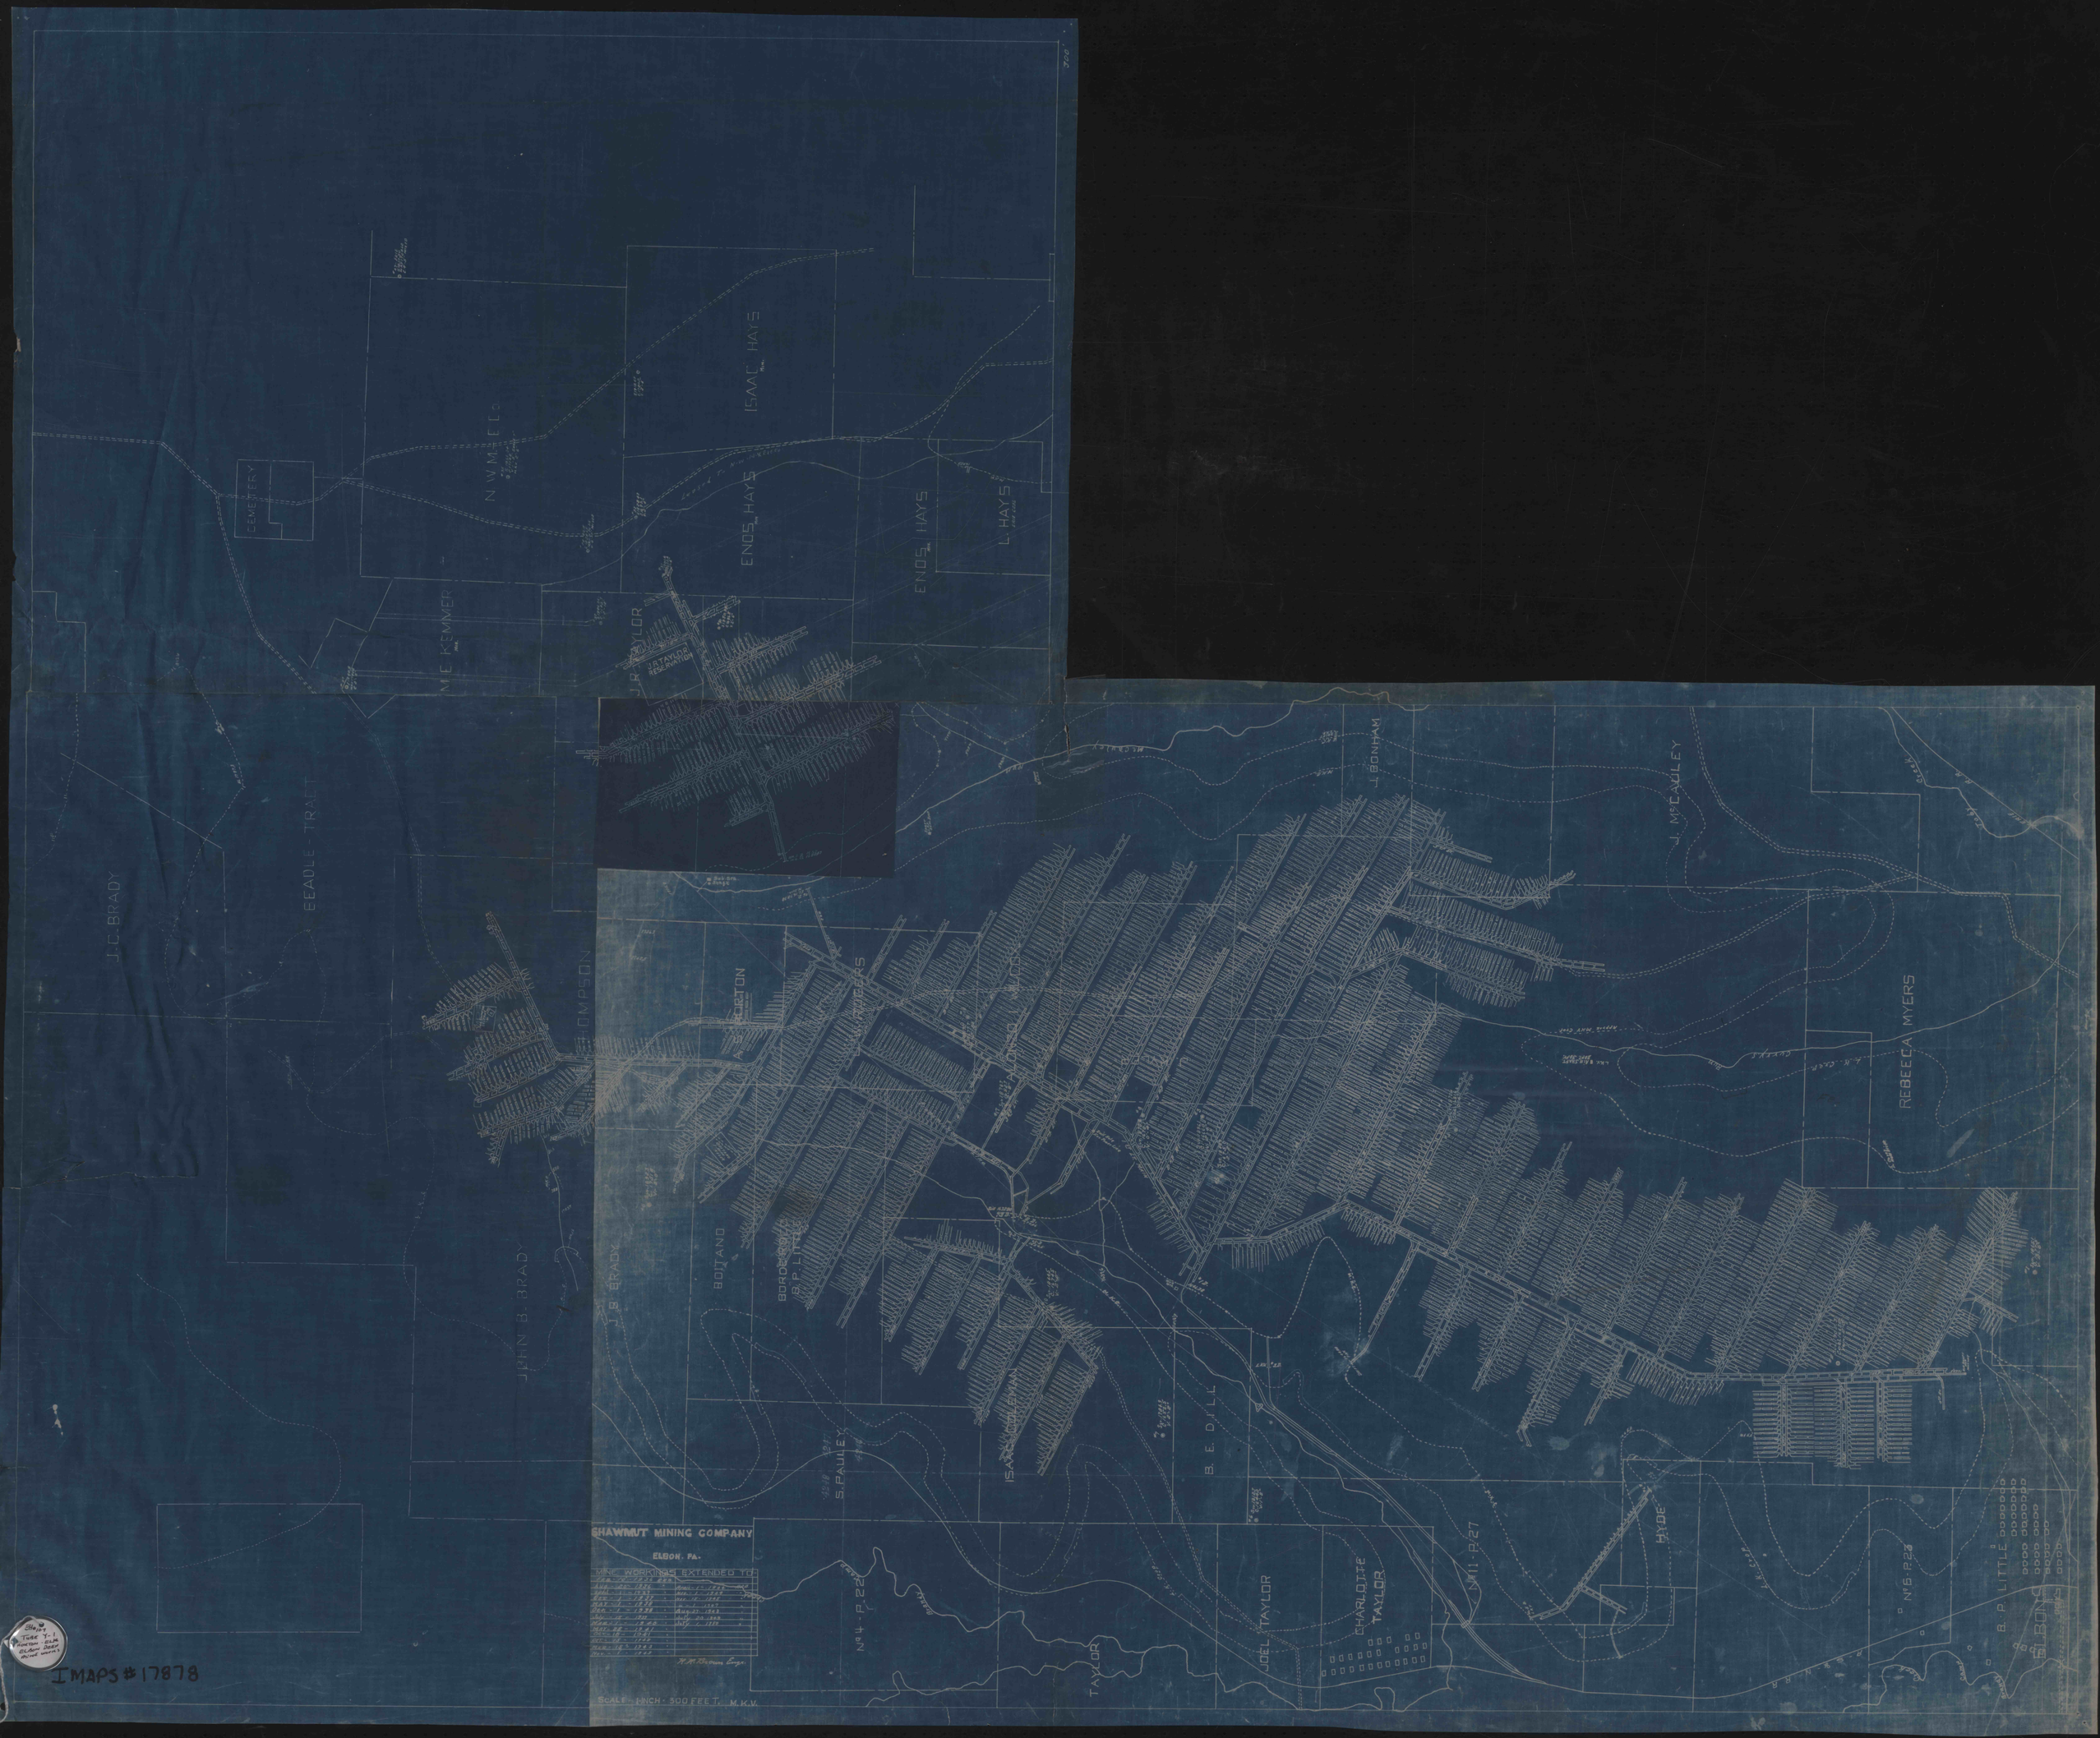
CEMETERY
N. W. M. E. C.
ISAAC HAYS
ENOS HAYS
ENOS HAYS
L. HAYS
M. E. KEMMER
J. R. TAYLOR
J. C. BRADY
EEADLE TRACT
THOMPSON
J. B. BRADY
JOHN B. BRADY
BOITANO
BORDEROUX
B. P. LITTLE
ALONZO MOORE
S. PAULEY
ISAAC COLEMAN
B. E. DILL
J. BONHAM
J. McCADLEY
REBECCA MYERS
TAYLOR
JOEL TAYLOR
CHARLOTTE TAYLOR
HYDE
B. P. LITTLE
BONS
SHAWMUT MINING COMPANY
ELBON, PA.
MINE WORKINGS EXTENDED TO
H. M. Brown Engr.
SCALE - 1 INCH - 300 FEET. M.K.V.

IMAPS #17878