



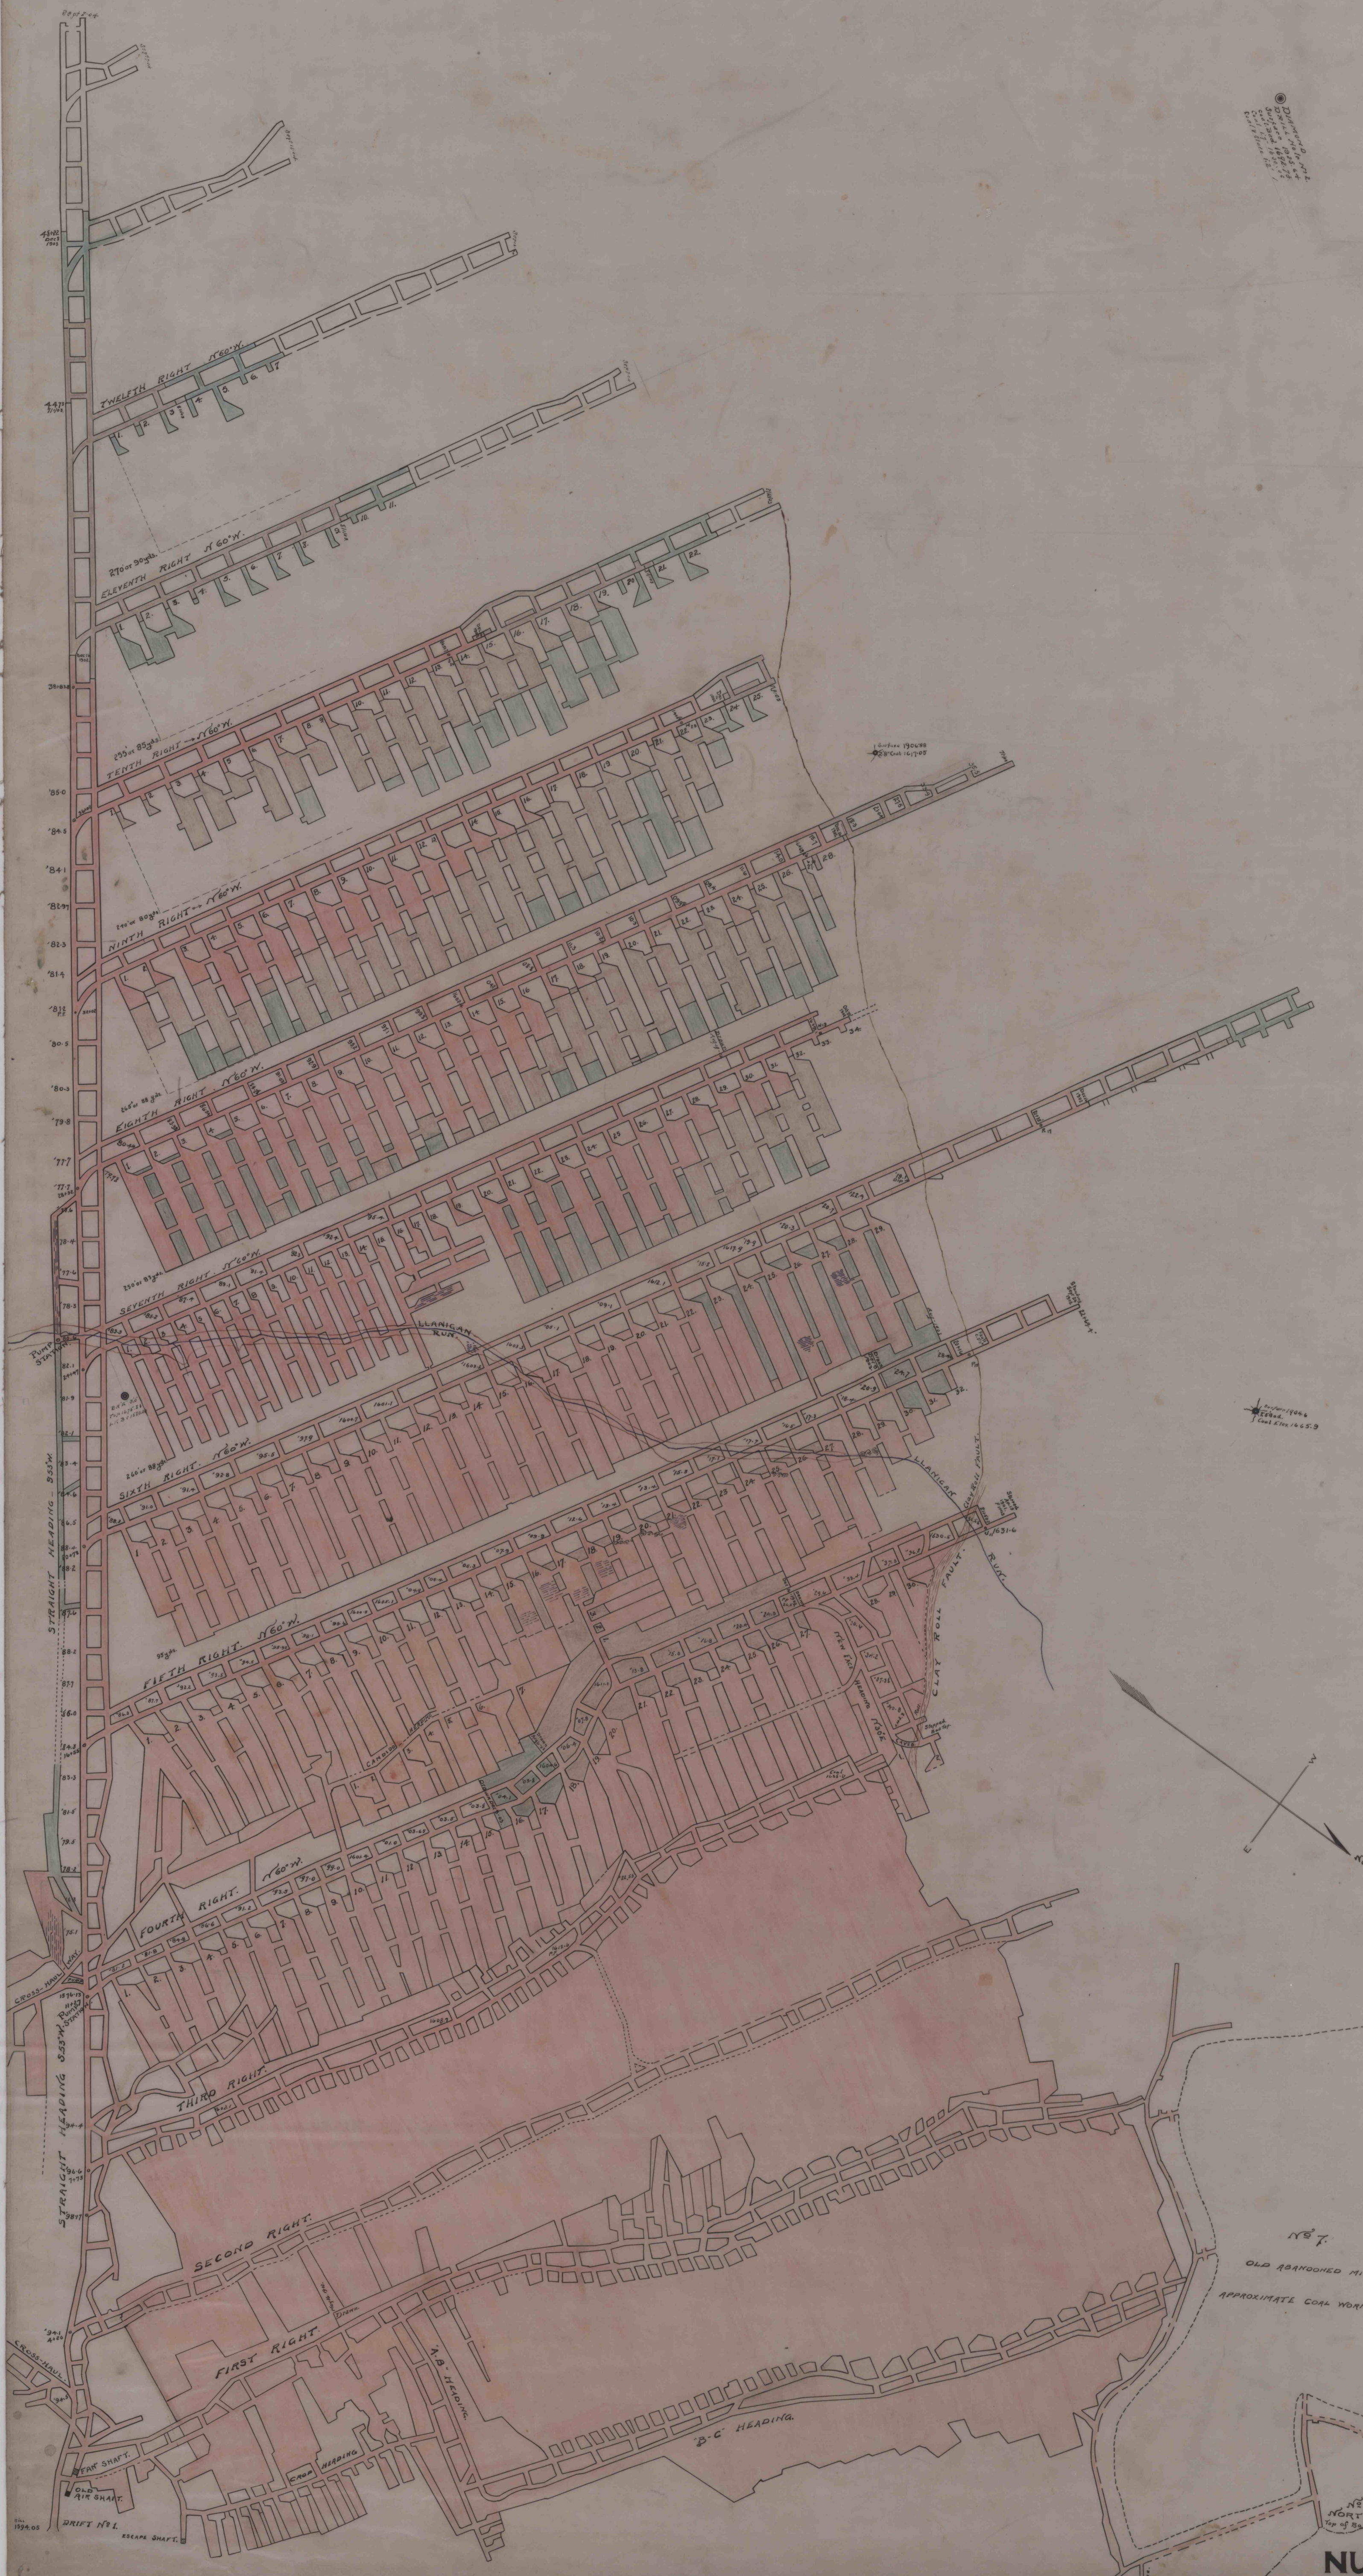

© DIAMOND
DANIEL W. CO. L.
Surface 1880-18
Coal 1880-18



**SHAWMUT MINES,
NUMBER EIGHT, DRIFT NO. 1.**
"SHAWMUT MINING CO."
OPERATORS.
Date of Last Survey, Dec. 16, 1902.
Aug. 22, 1903.
Oct. 1, 1903.
SCALE 1"=100'
