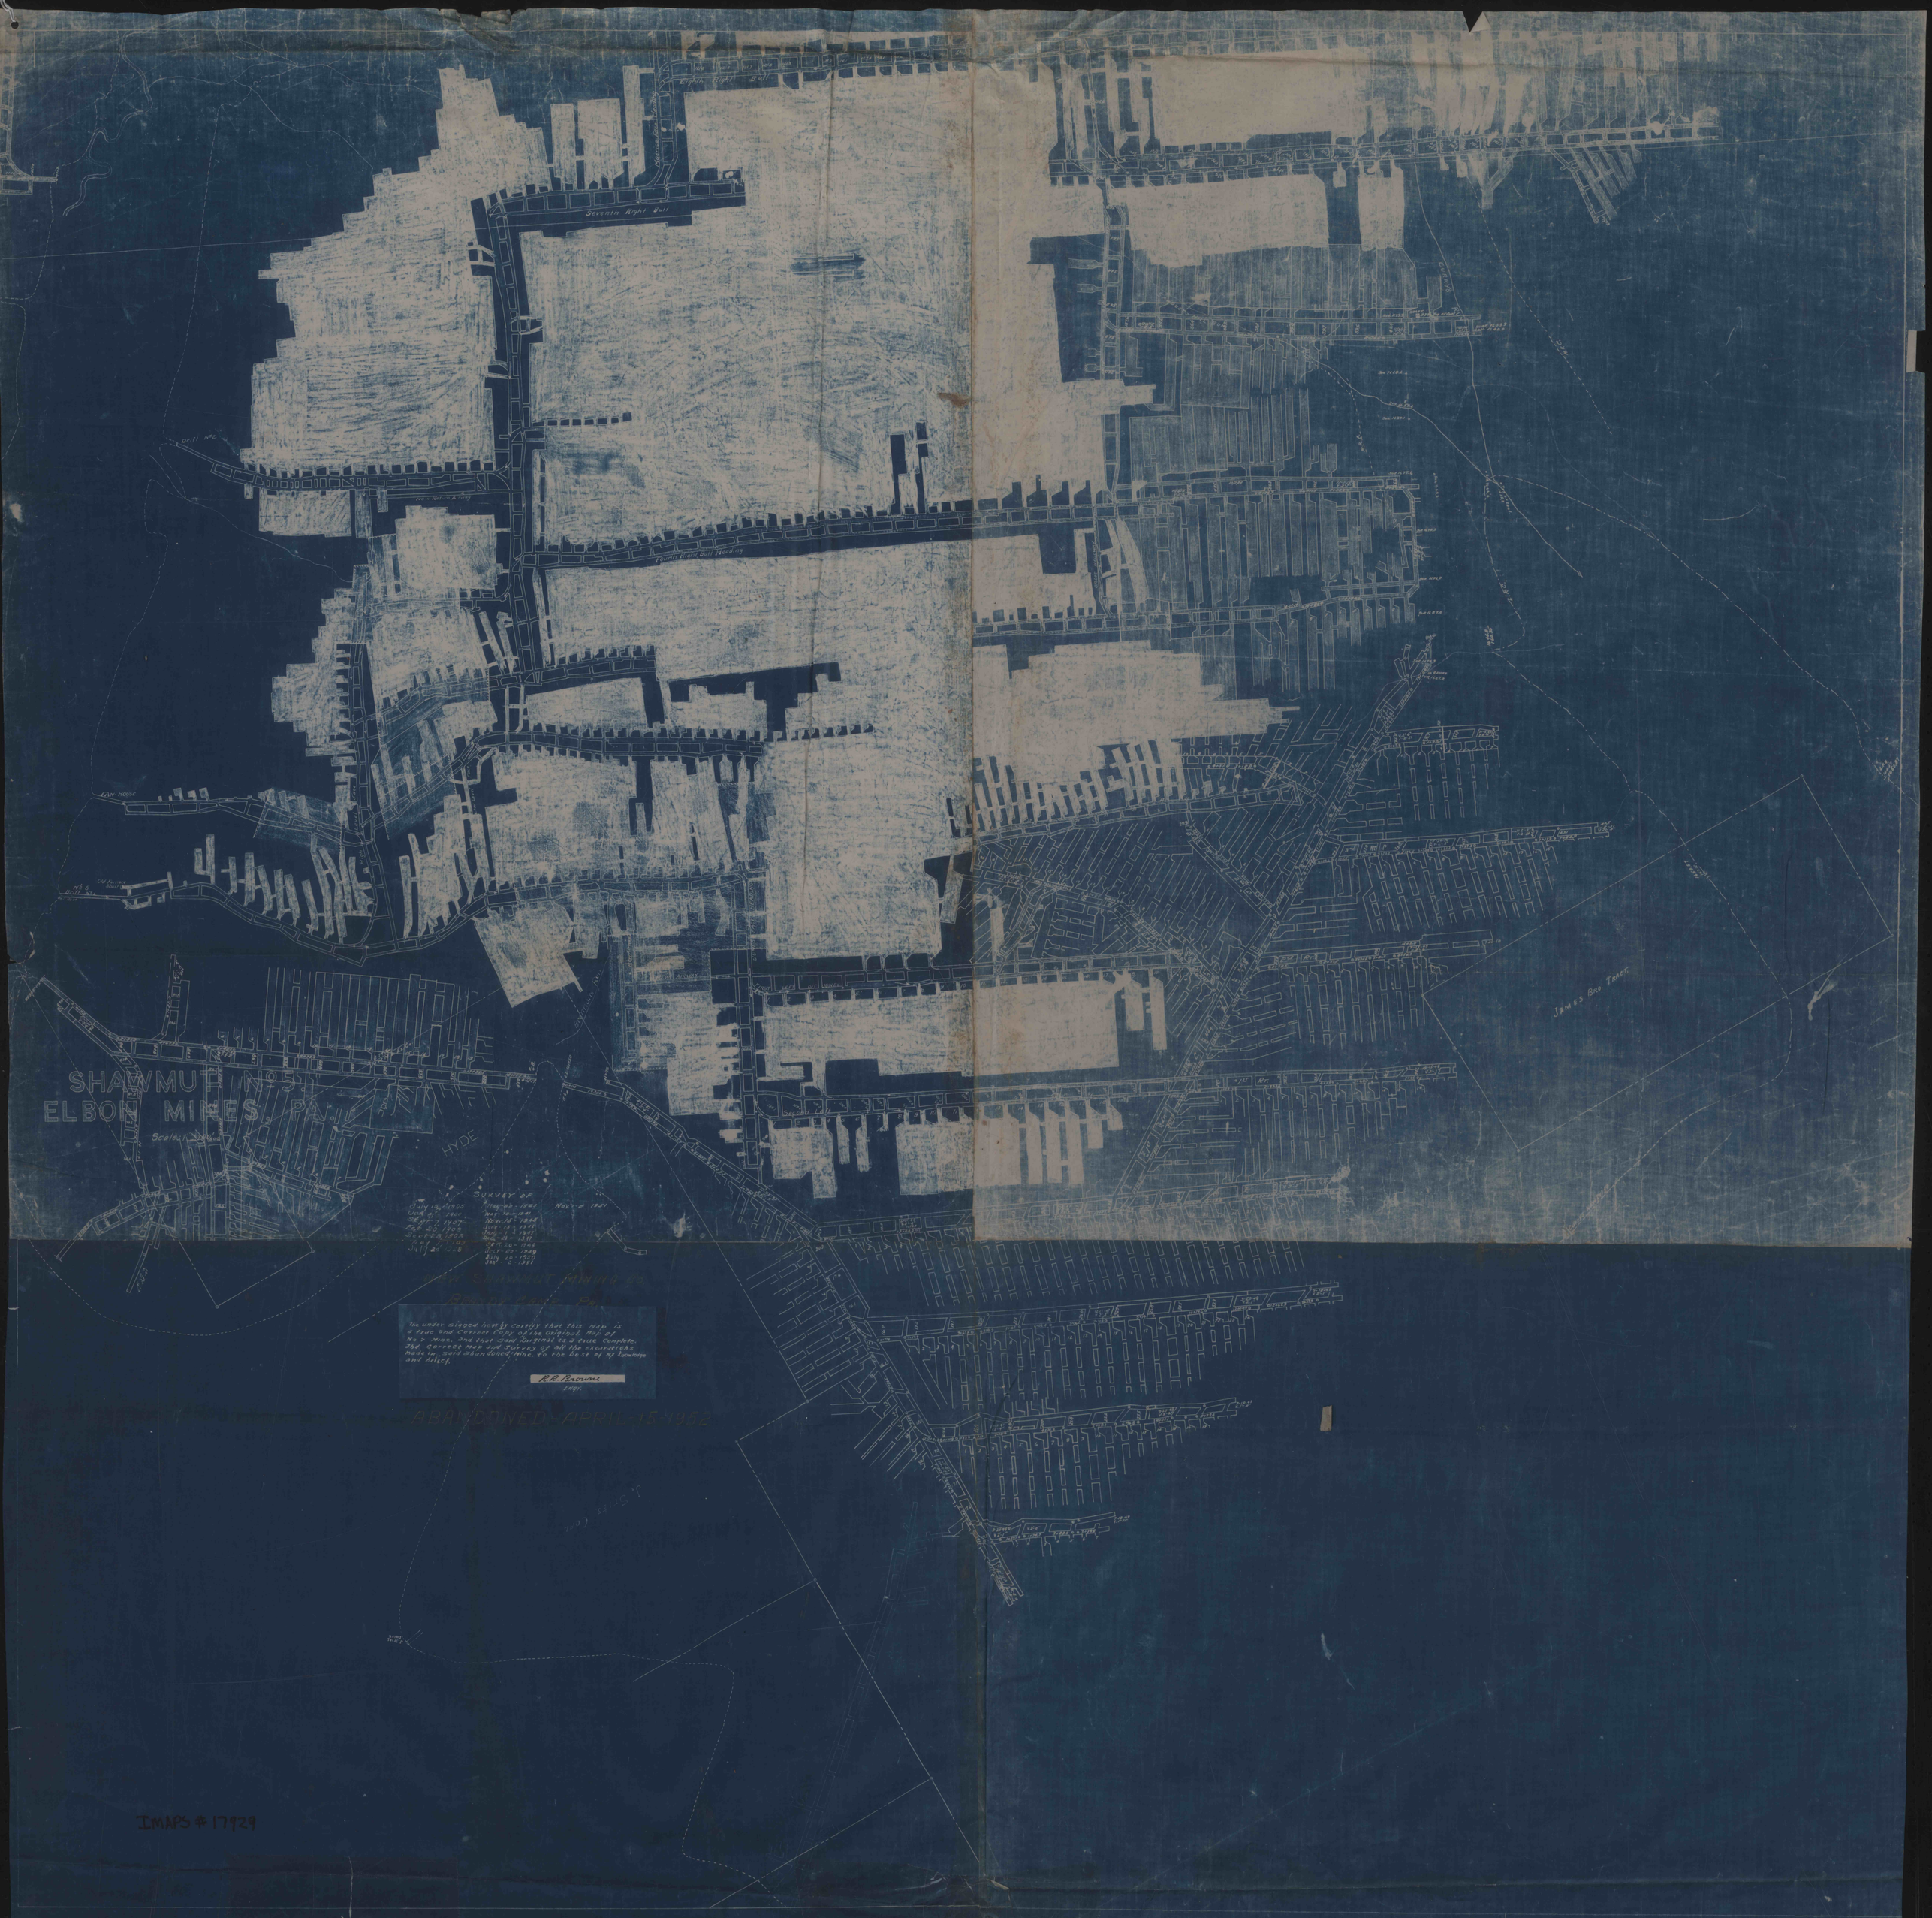
Eighth Right Bull
Seventh Right Bull
Fourth Right Bull Heading
Fox House
James Bro Tract
SHAWMUT No 5
ELBON MINES, PA.
Scale 1" = 50 Feet
HYDE
SURVEY OF
July 19, 1905
Oct 7, 1907
Feb 20, 1908
Nov 20, 1905
July 20, 1908
May 23, 1921
Nov 2, 1921
Mar 10, 1941
Nov 15, 1945
June 20, 1946
Jan 1, 1947
Dec 20, 1947
Sept 20, 1948
July 20, 1949
July 20, 1950
Jan 2, 1951
The under signed hereby certify that this Map is a true and correct copy of the Original Map of No 7 Mine, and that said Original is a true, complete, and correct Map and Survey of all the excavations made in said abandoned Mine, to the best of my knowledge and belief.
R.B. Brown
Engr.
ABANDONED APRIL 15 1952

IMAPS #17929