


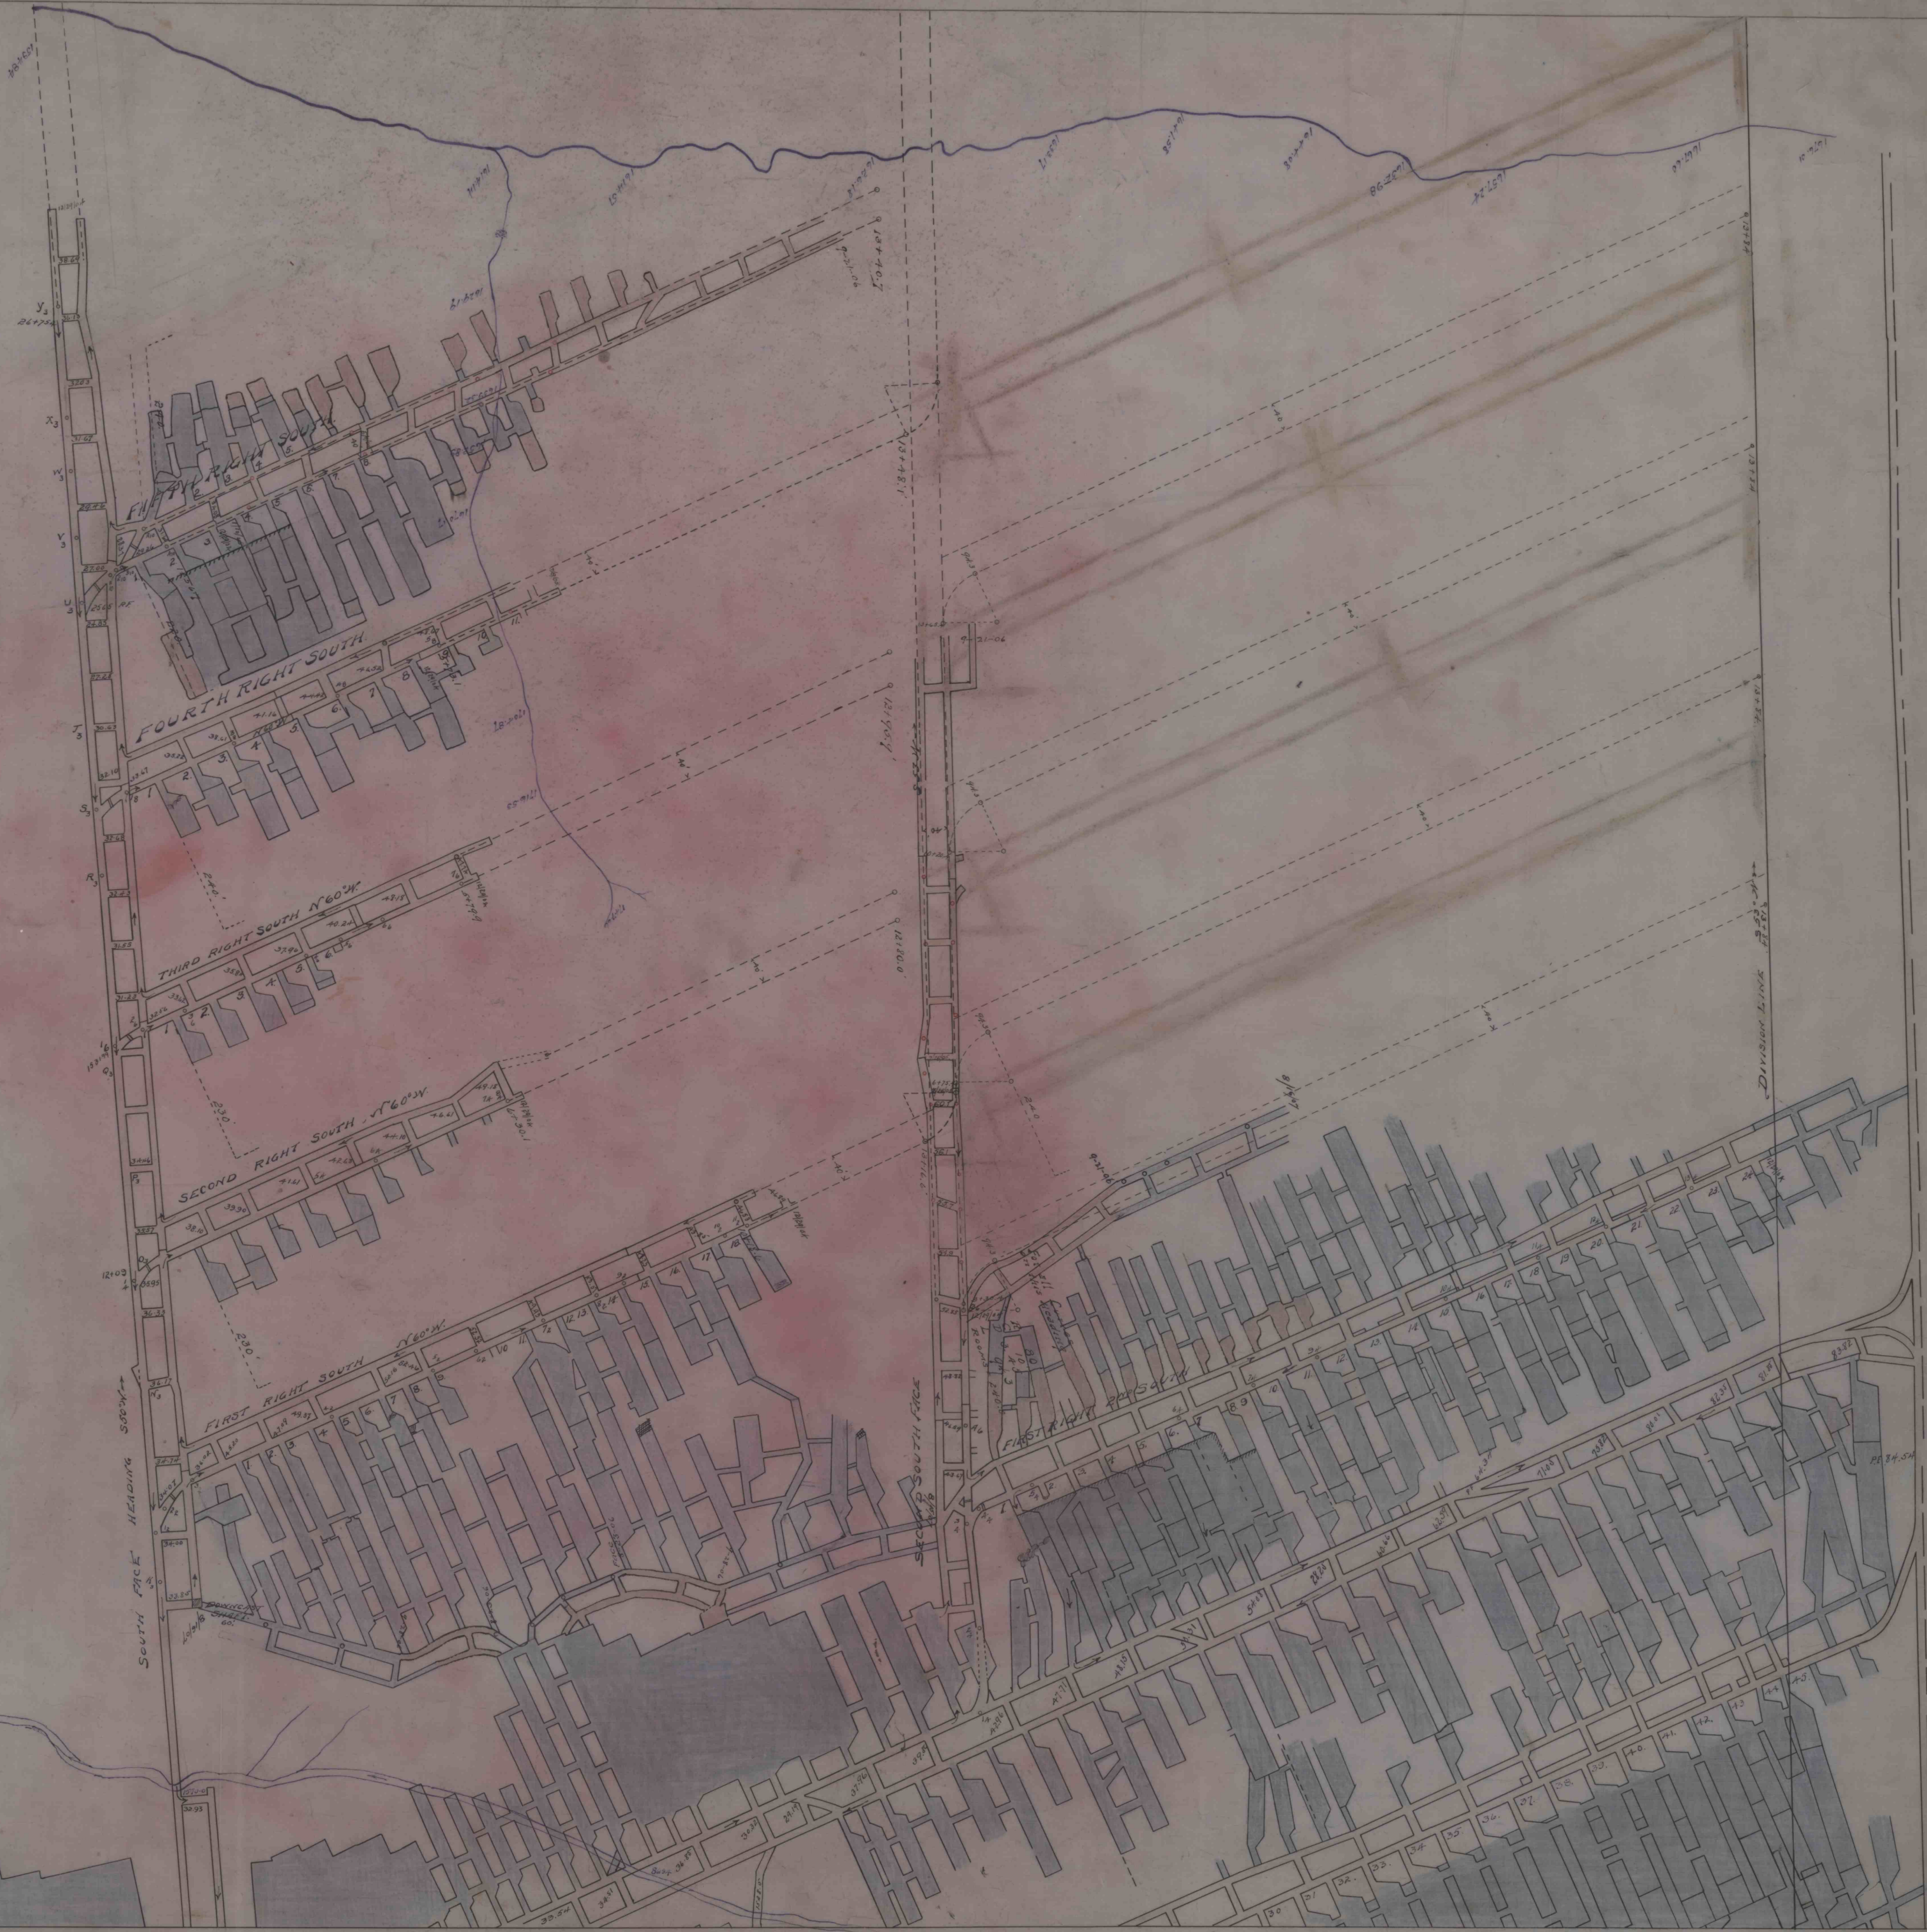

MAPS # 17935

#8
MINES