


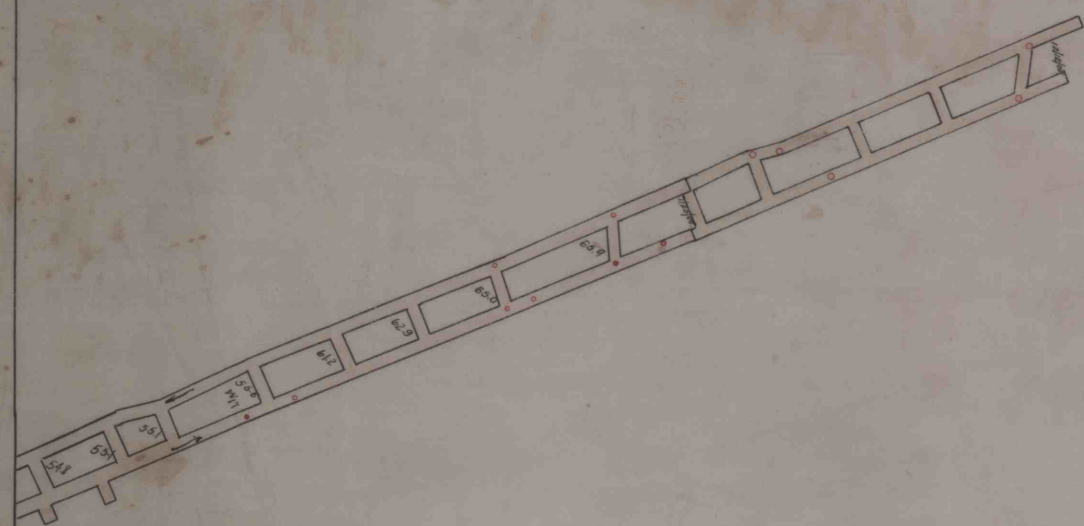

IMAPS # 0946