


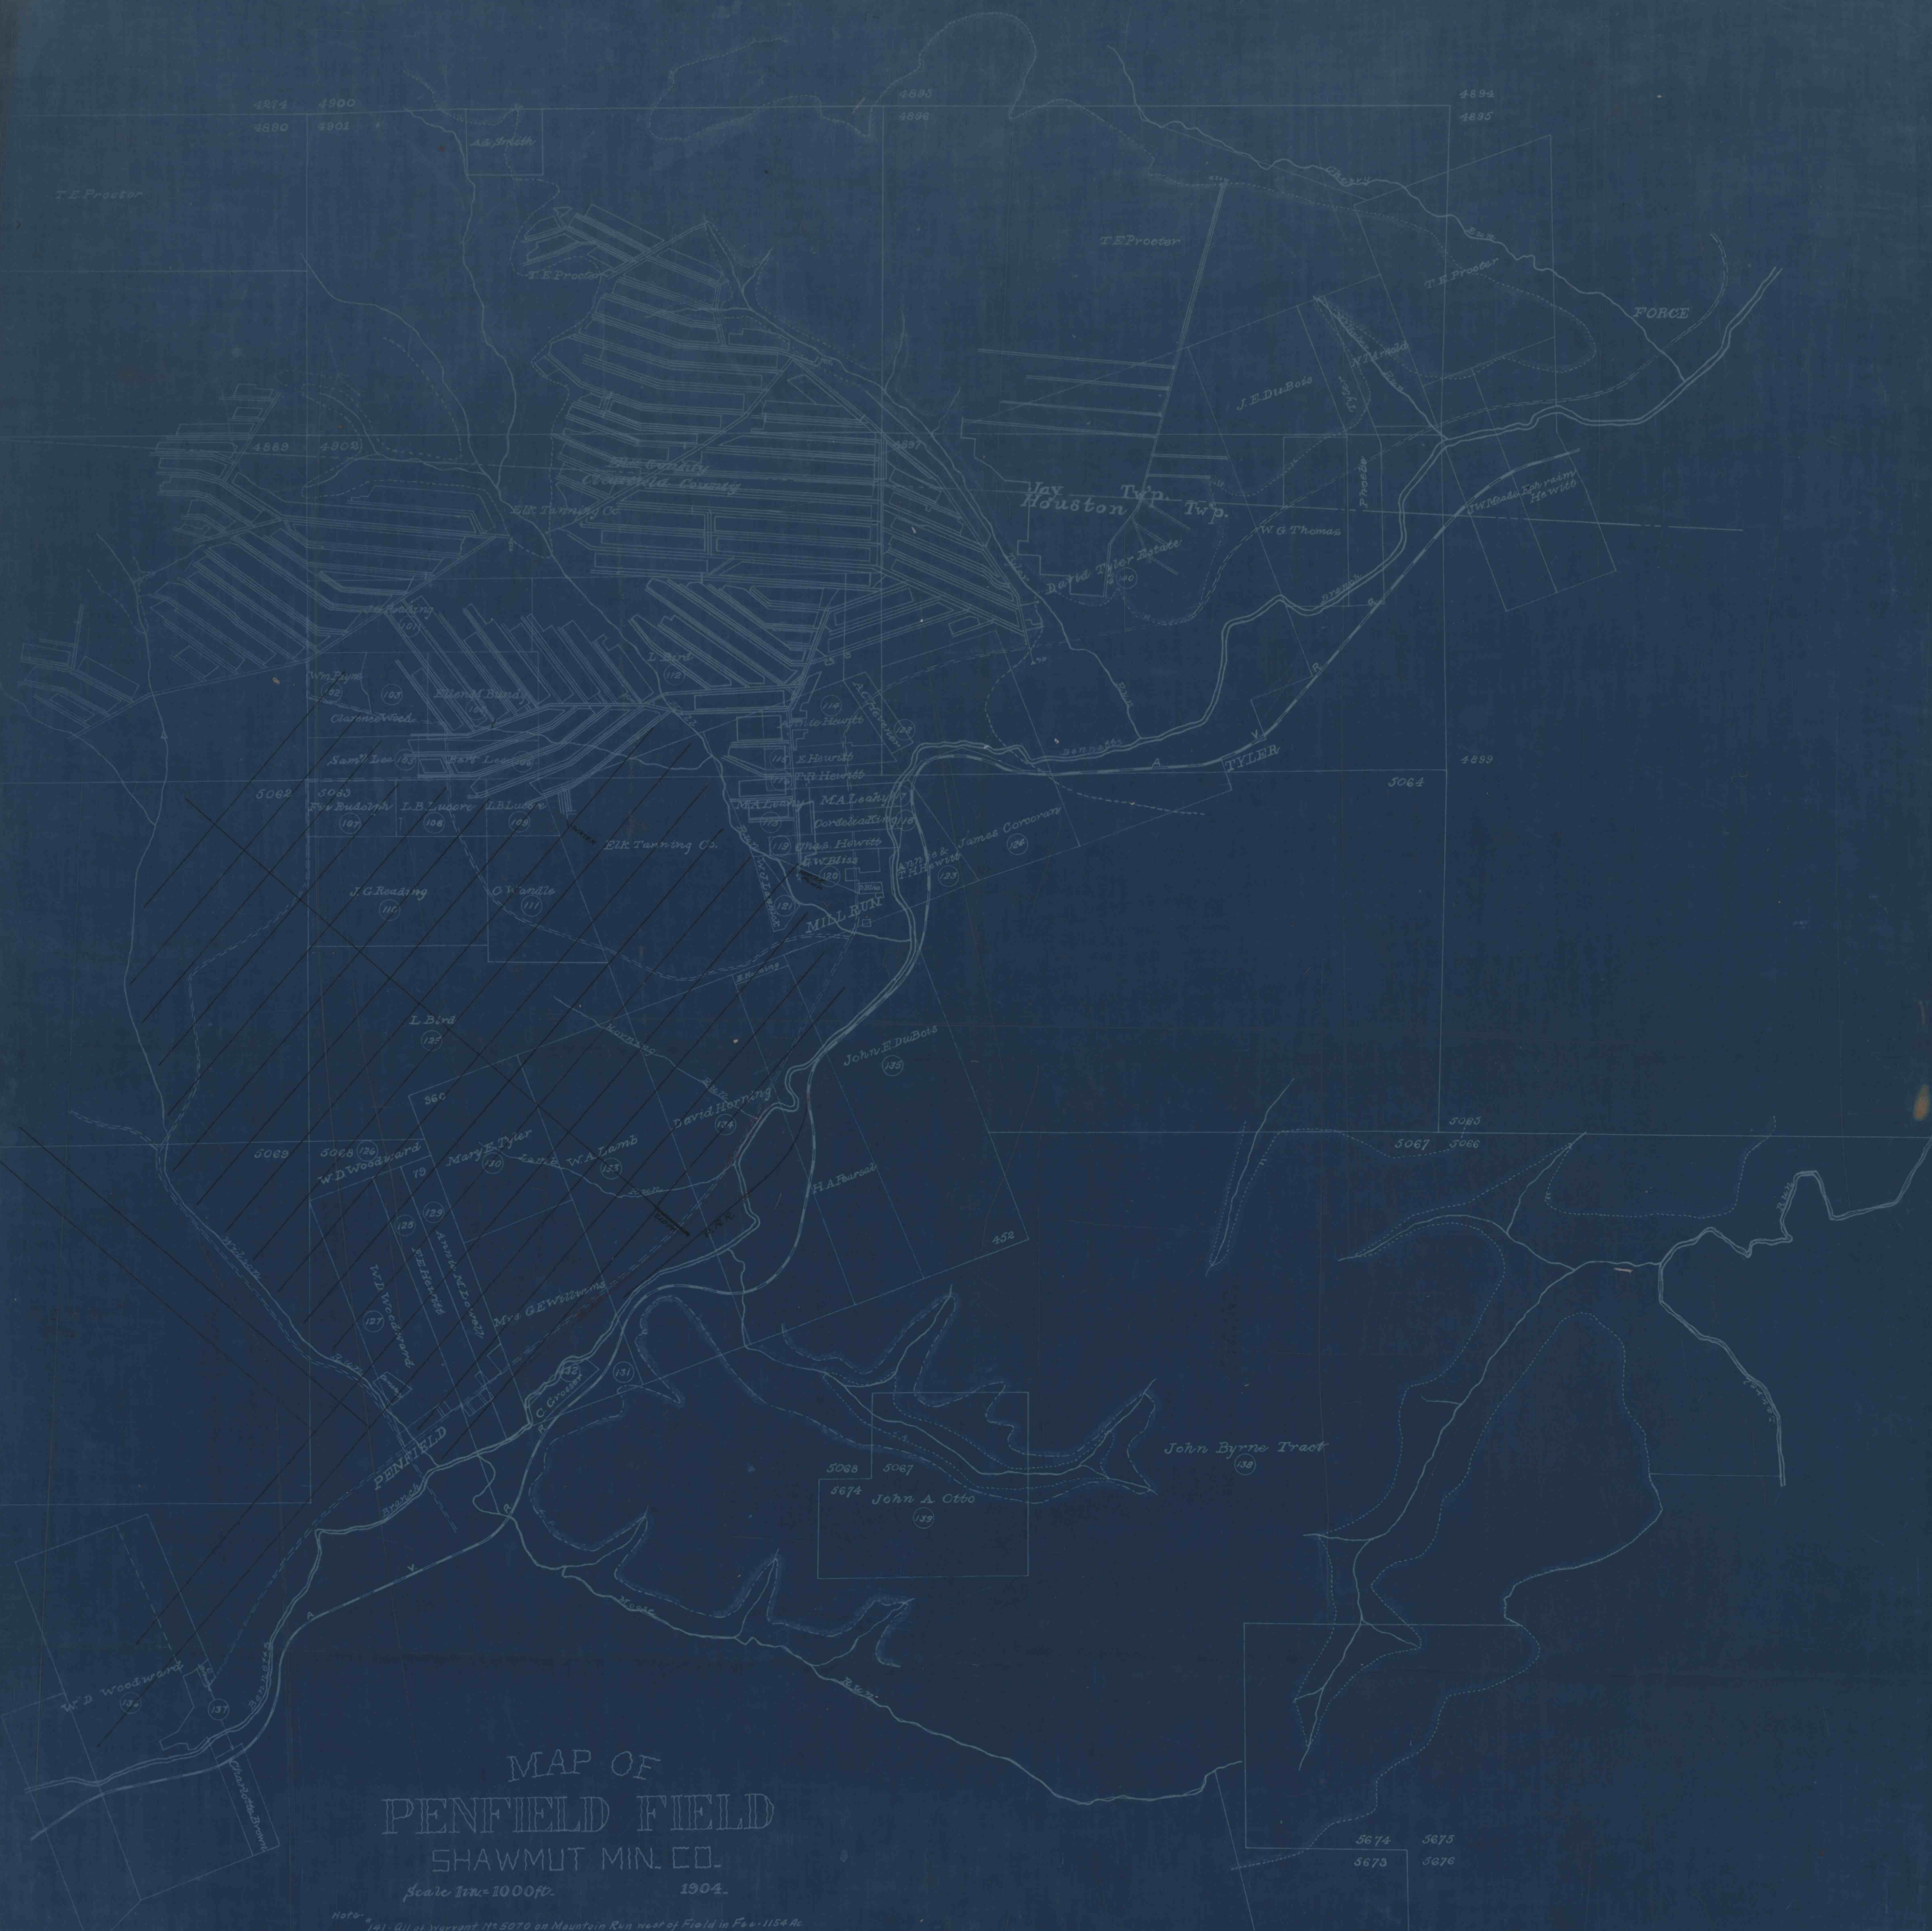

MAP OF
PENFIELD FIELD
SHAWMUT MIN. CO.
Scale 1 in. = 1000 ft. 1904.

Note - All of variant 1755070 on Mountain Run west of Field in Feb. 1154 Ac.

CH. # 60 TUBE 6A
PENFIELD FIELD MAP
OF L.K. SLOPE & R.R.'S.

IMAPS#17972