


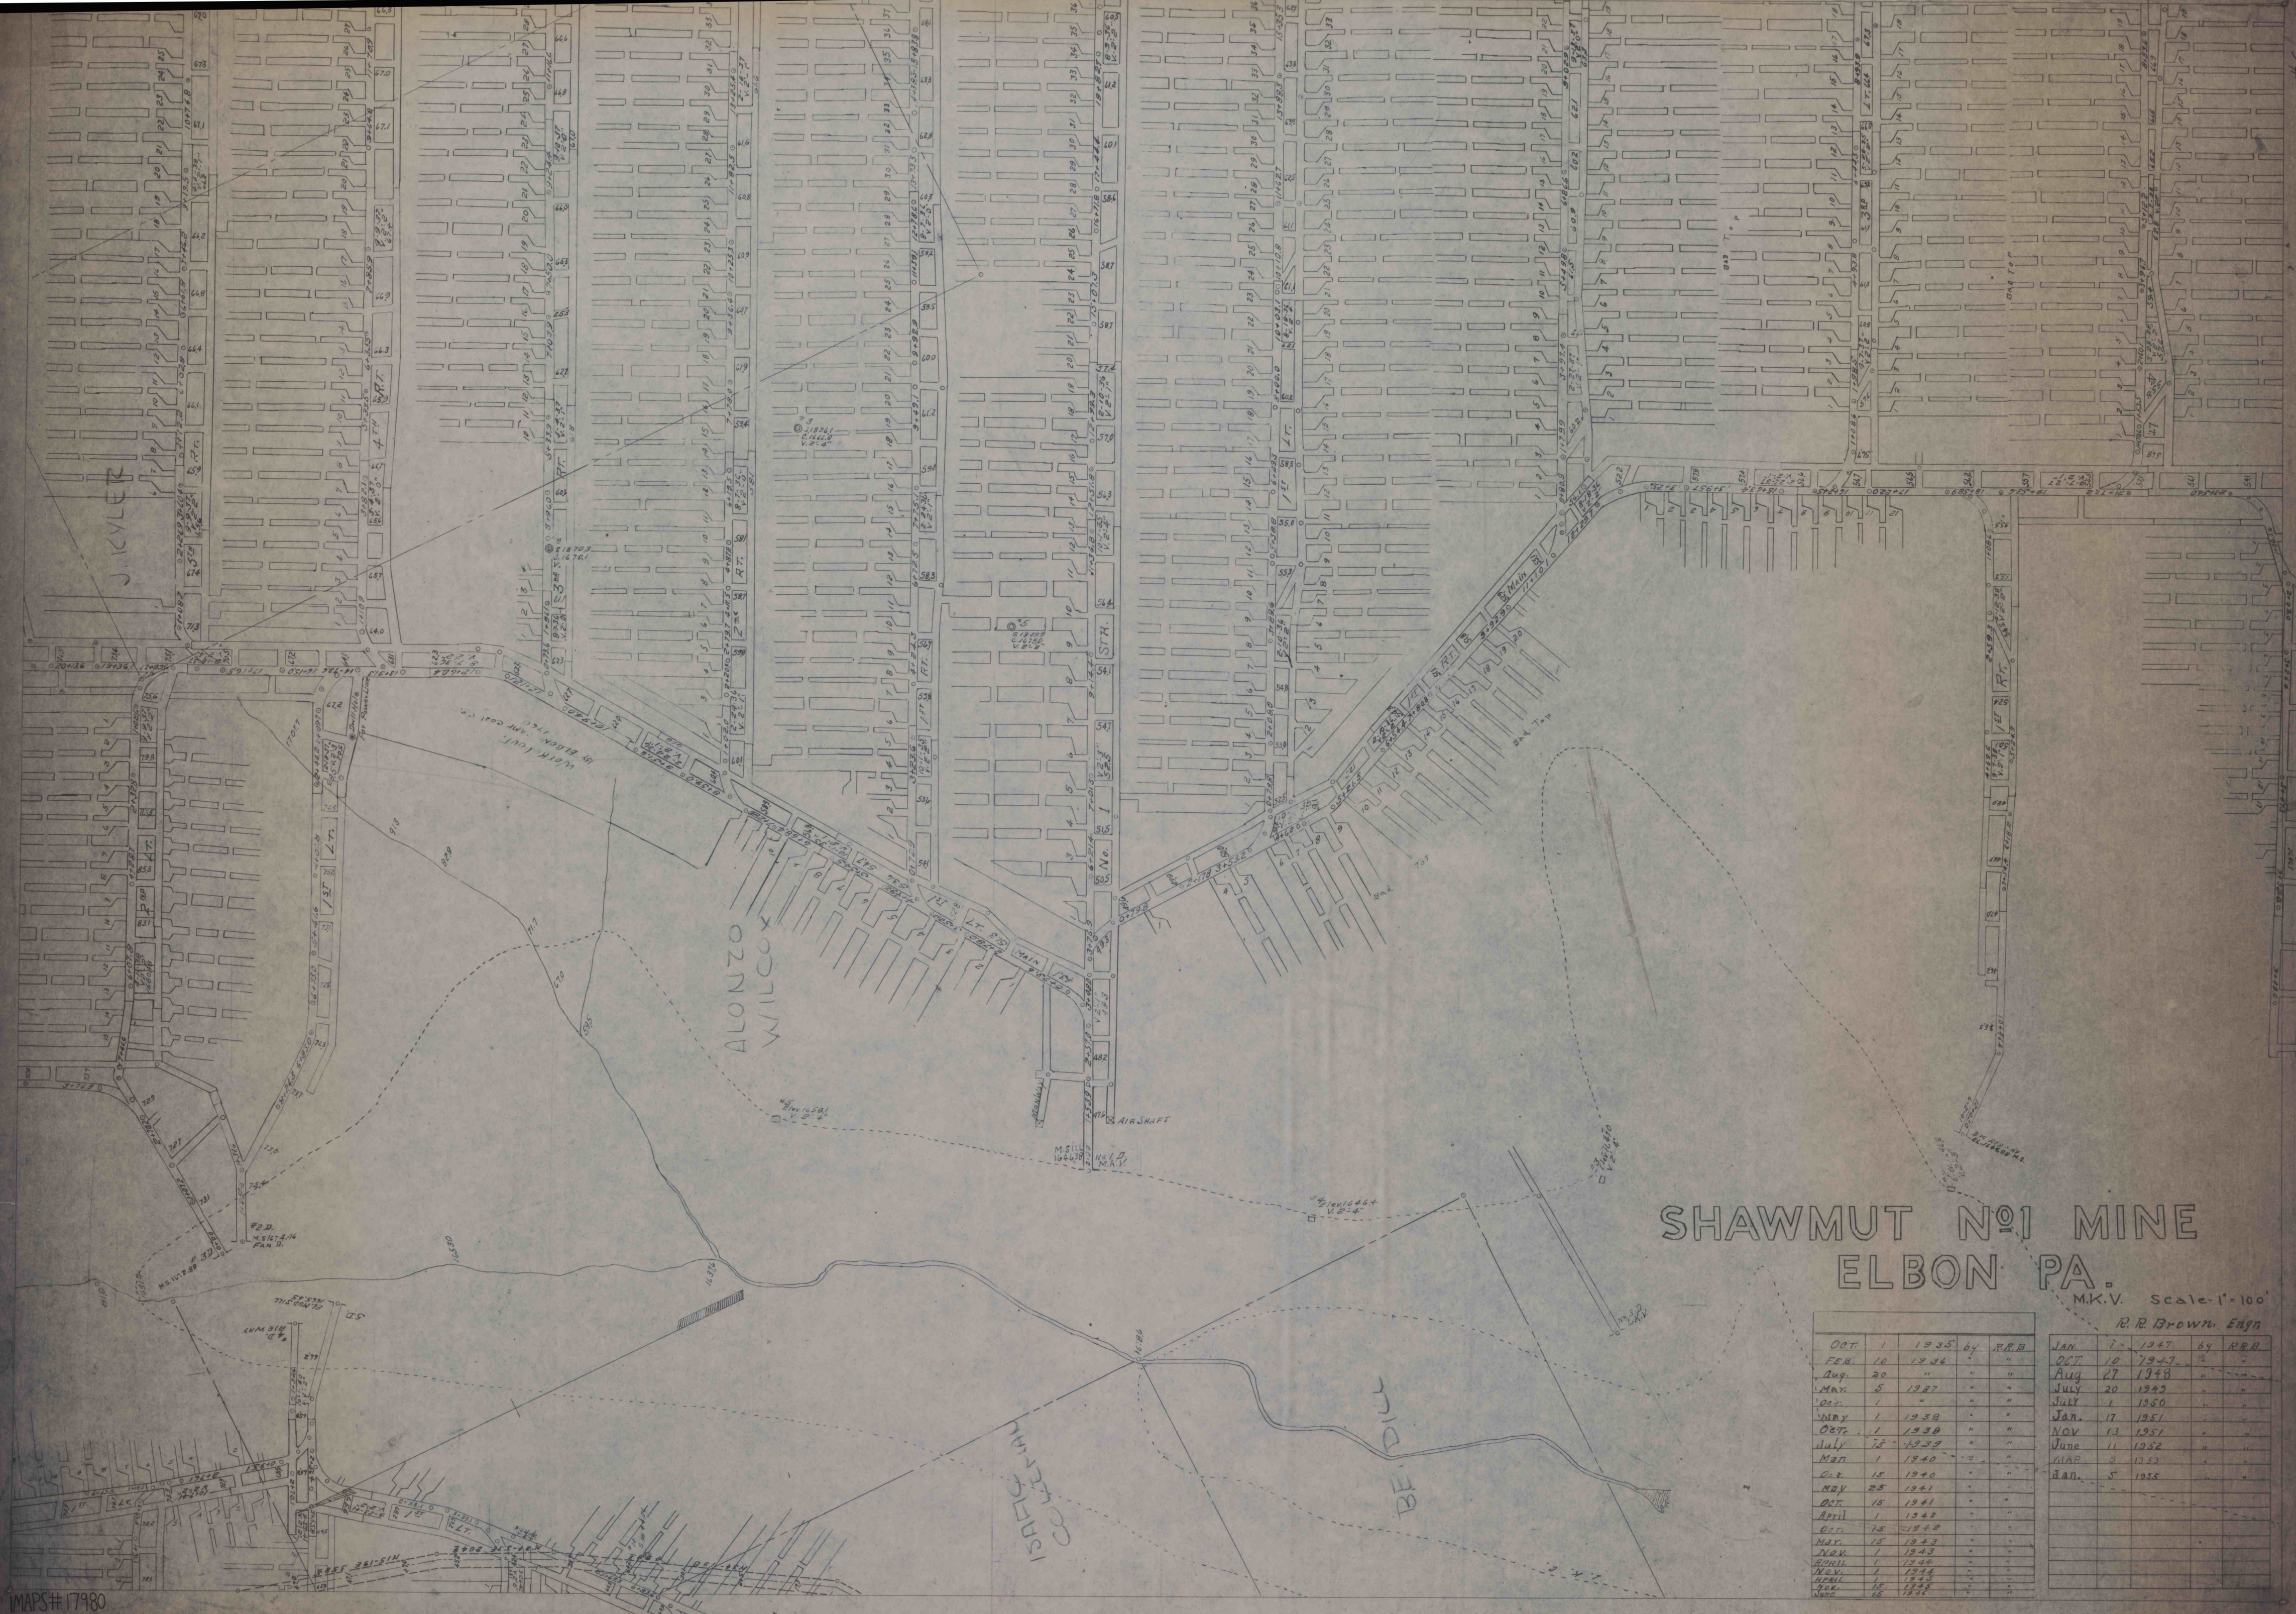

SHAWMUT NO. 1 MINE ELBON PA.

M.K.V. Scale 1"=100'

R. R. Brown, Engr.

OCT	1	1935	64	R.R.B.
FEB.	10	1936	"	"
Aug.	20	"	"	"
Mar.	5	1937	"	"
Oct.	1	"	"	"
May	1	1938	"	"
Oct.	1	1939	"	"
July	15	1939	"	"
Mar.	1	1940	"	"
Oct.	15	1940	"	"
May	25	1941	"	"
Oct.	15	1941	"	"
April	1	1942	"	"
Oct.	15	1942	"	"
Mar.	15	1943	"	"
Nov.	1	1943	"	"
Nov.	1	1944	"	"
Nov.	15	1945	"	"
June	15	1946	"	"

JAN	1	1947	64	R.R.B.
OCT.	10	1947	"	"
Aug.	27	1948	"	"
July	20	1949	"	"
July	1	1950	"	"
Jan.	17	1951	"	"
NOV	13	1951	"	"
June	11	1952	"	"
MAR	2	1953	"	"
Jan.	5	1955	"	"