


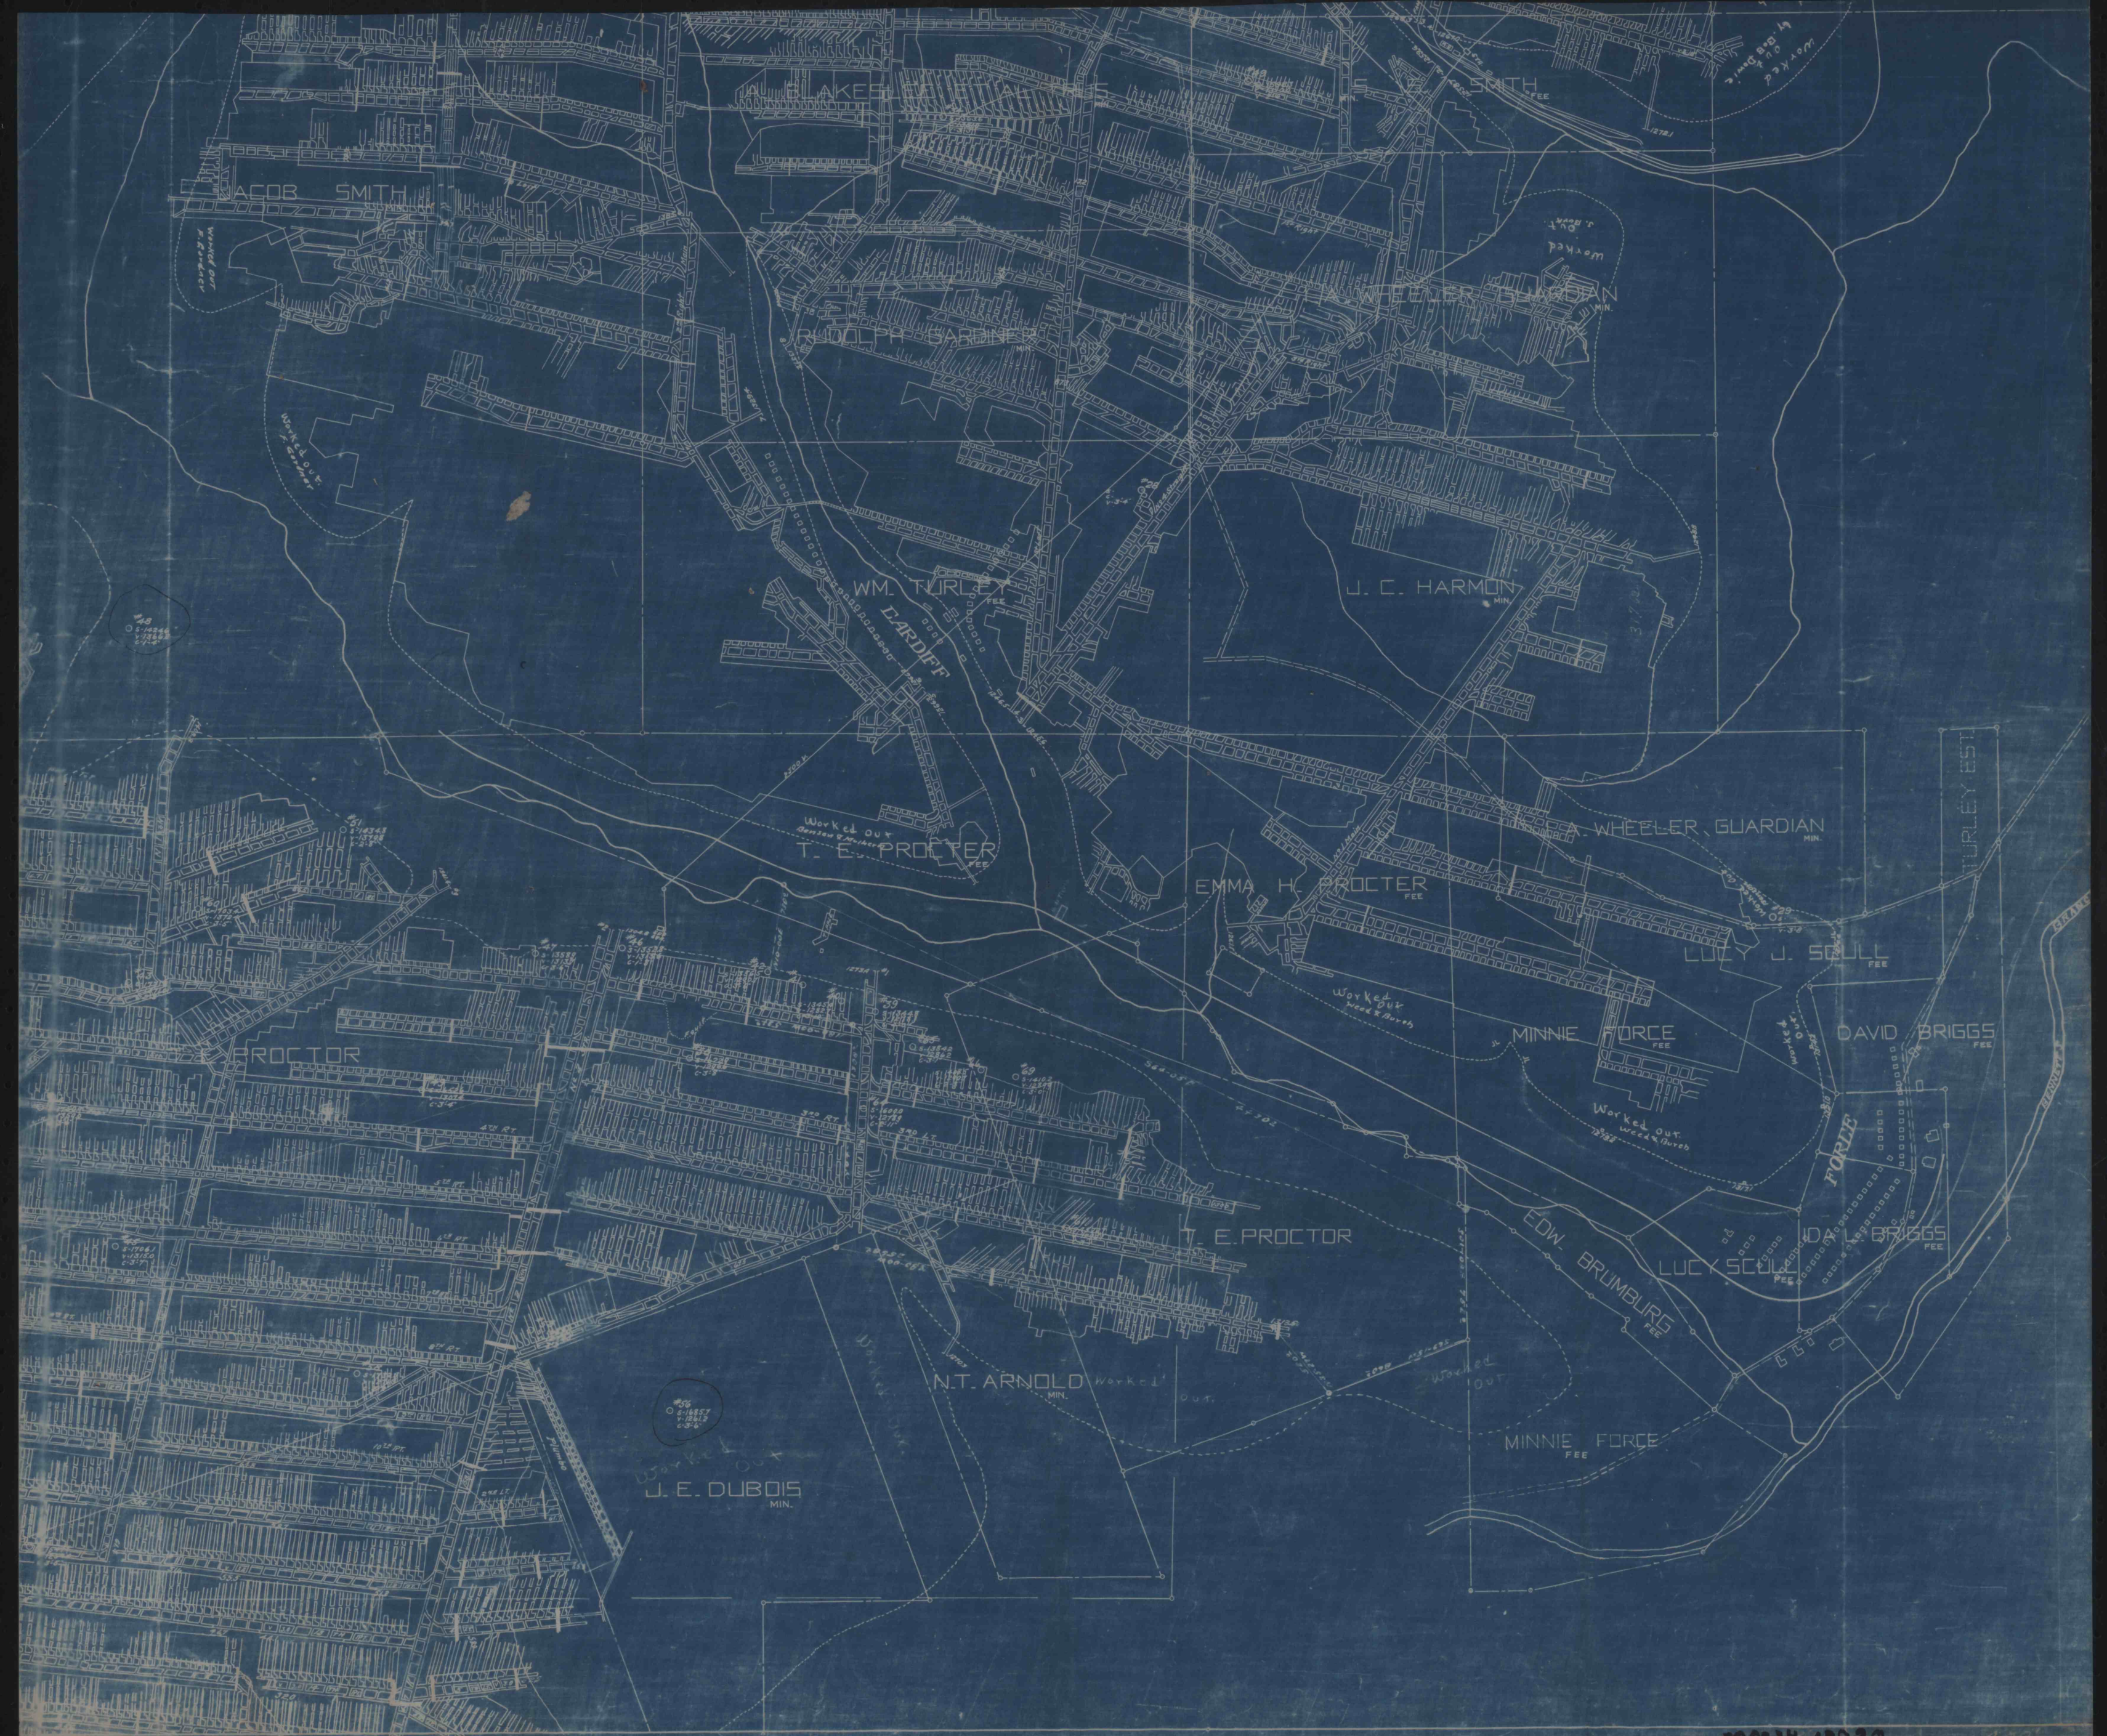

JACOB SMITH

AL BLAKE

R. D. HARRIS

WM. TURLEY

L. DART

J. C. HARMON

Worked Out
Gentle & Miller
T. E. PROCTER

EMMA H. PROCTER

WHEELER, GUARDIAN

LUCY J. SCULL

PROCTOR

MINNIE FORCE

DAVID BRIGGS

T. E. PROCTOR

EDW. BRUMBURG

LUCY SCULL

DAVID BRIGGS

N.T. ARNOLD

J. E. DUBOIS

MINNIE FORCE