


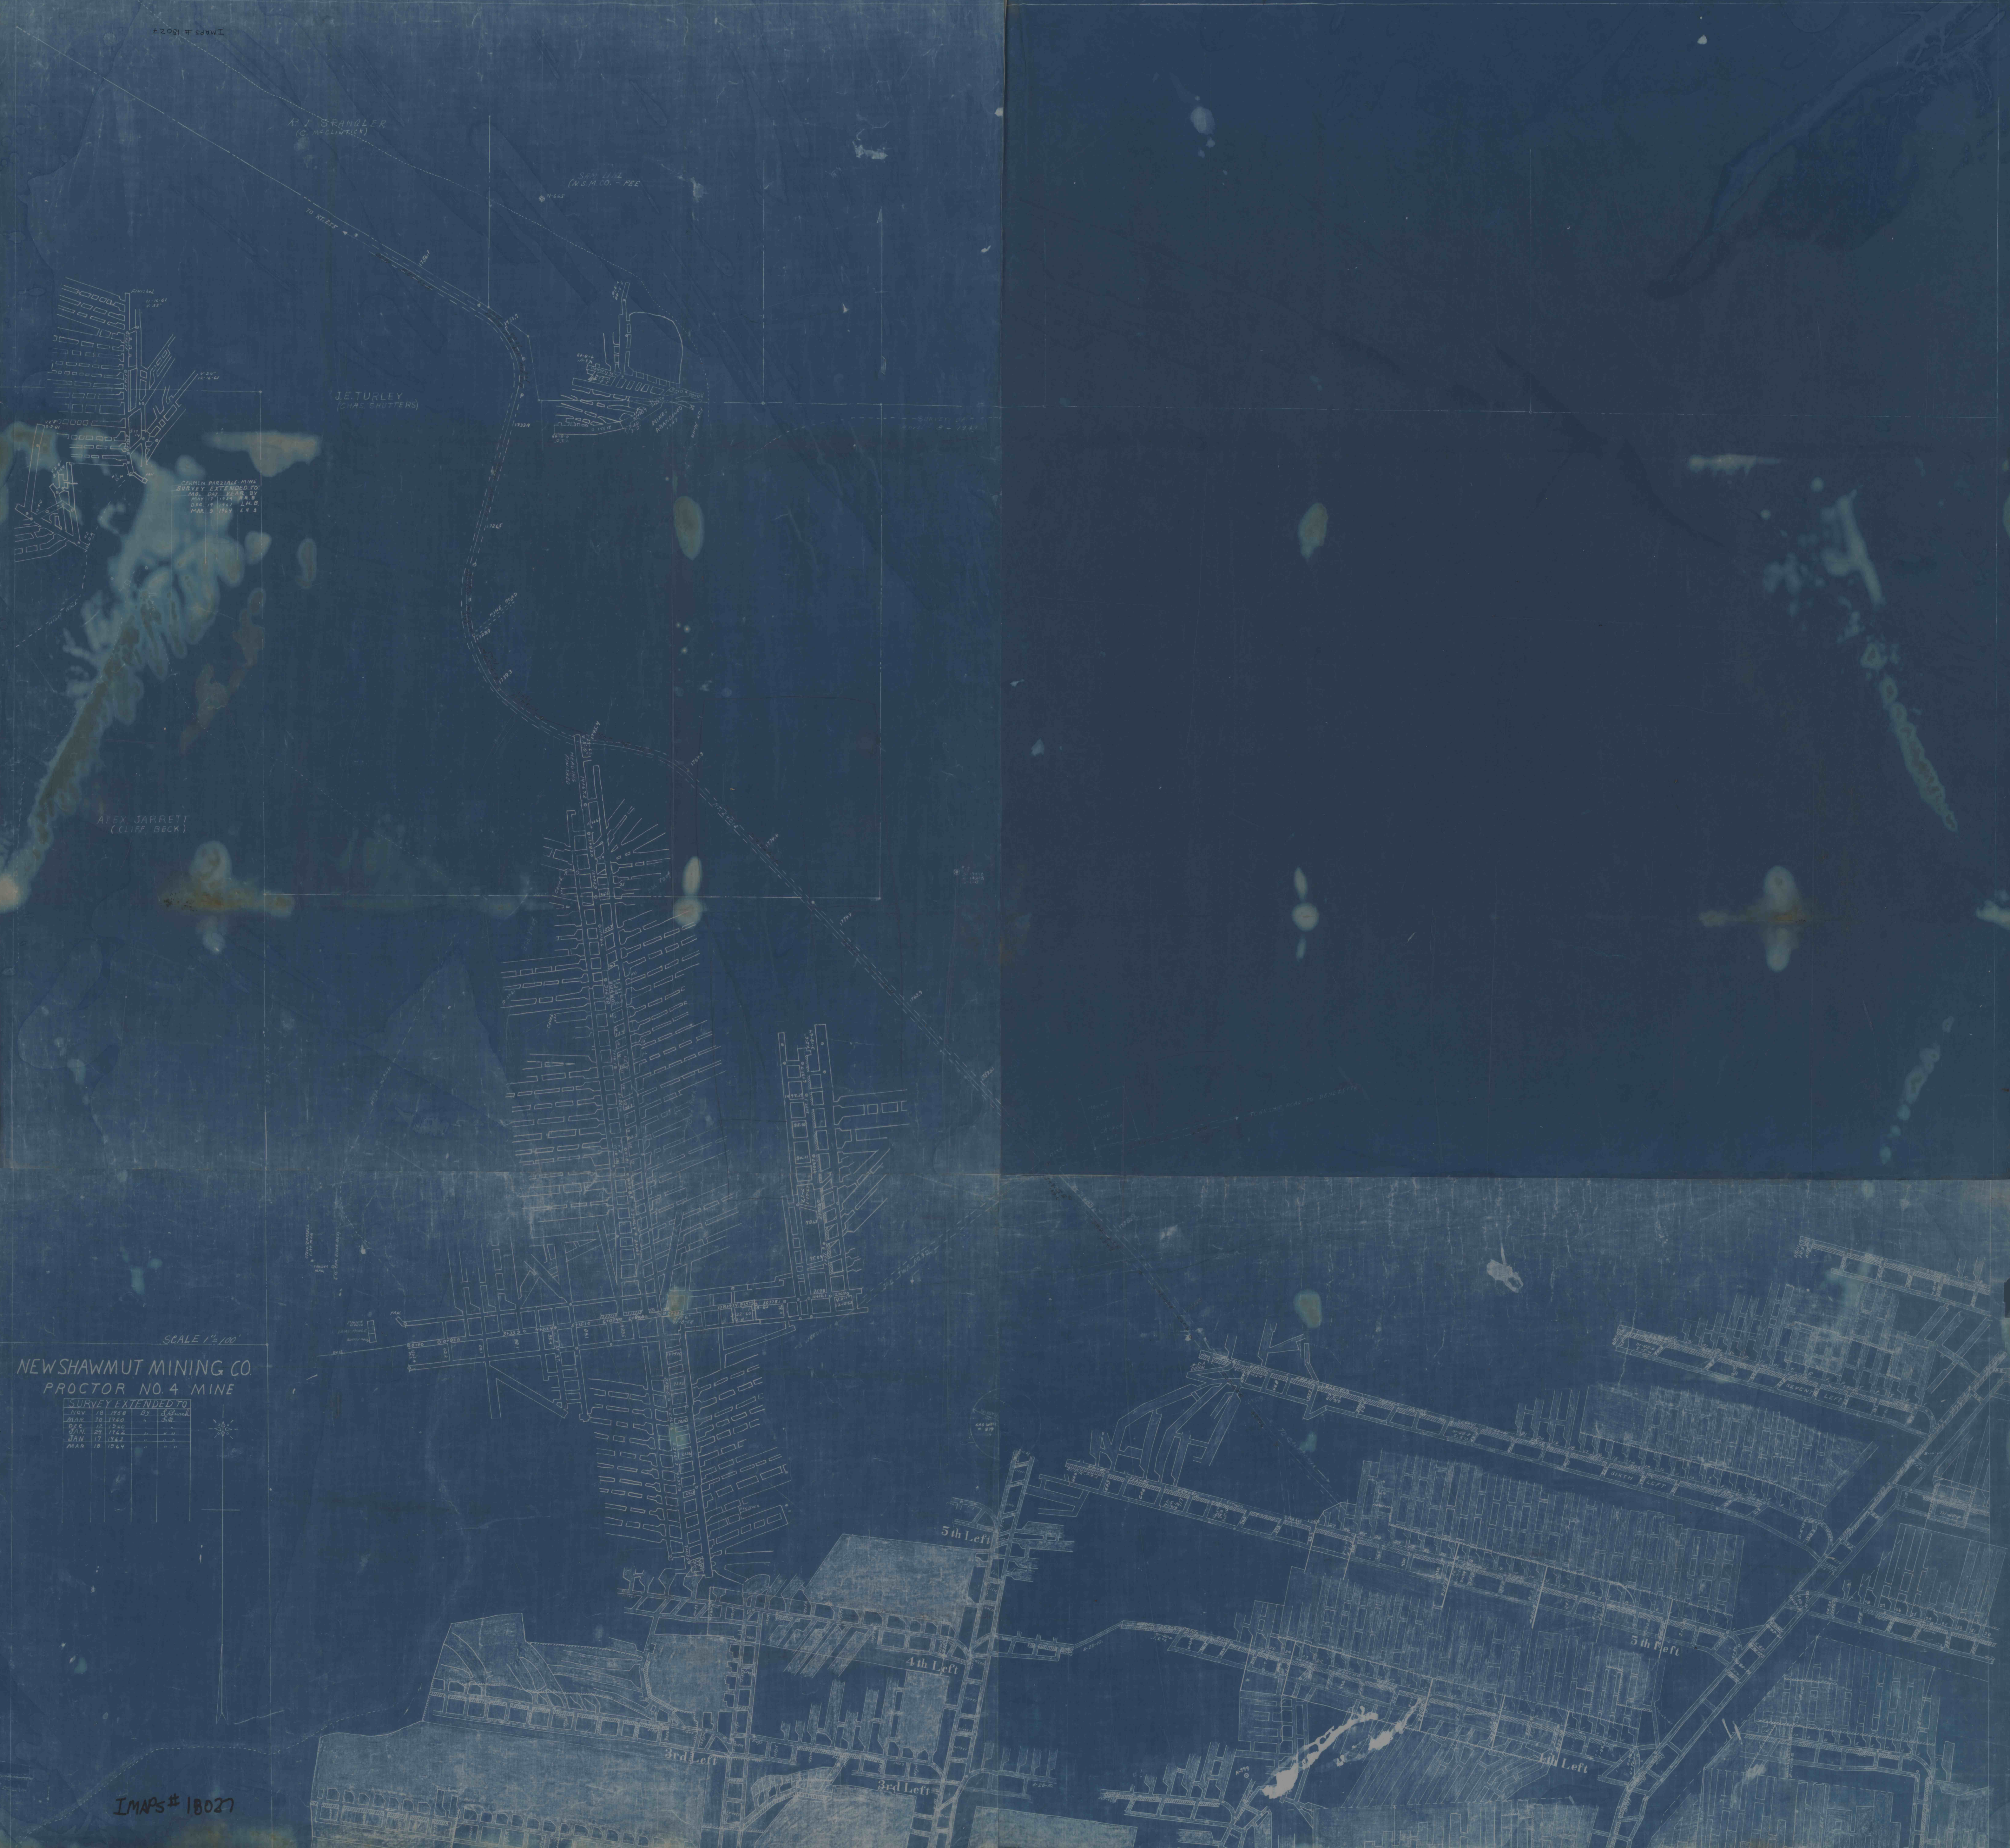

NEW SHAWMUT MINING CO
PROCTOR NO. 4 MINE

SURVEY EXTENDED TO			
NOV	18	22.8	3.5
DEC	18	18.0	3.5
JAN	19	12.0	3.5
FEB	19	12.0	3.5
MAR	19	12.0	3.5

IMAPS # 18027