


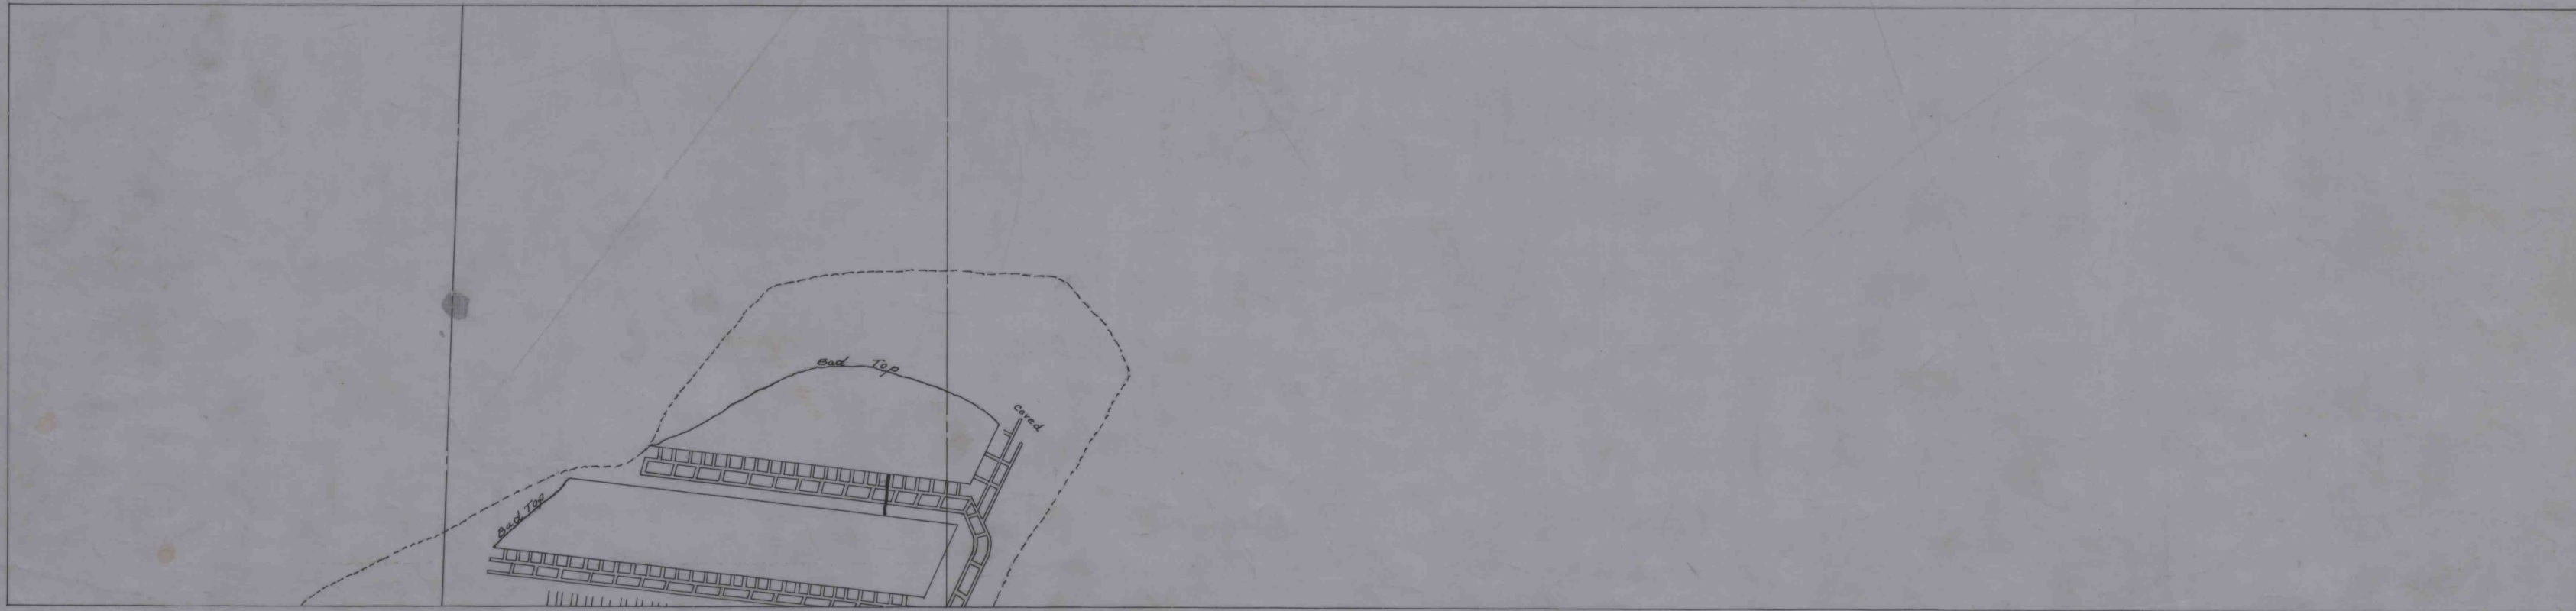

IMAPS#18033 Proctor #1 300'